
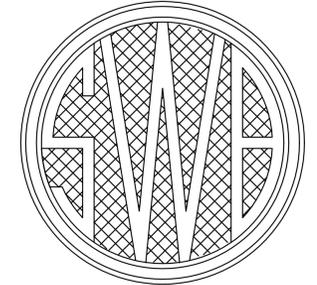



SEWERAGE AND WATER BOARD OF NEW ORLEANS

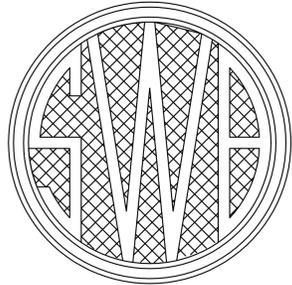

CONTRACT No. 3668 HURRICANE KATRINA RELATED 404 HAZARD MITIGATION GRANT PROGRAM REPLACEMENT OF VICTORIA SEWAGE PUMPING STATION

DRAWING INDEX

SHEET No.	DRAWING No.	Discipline	TITLE	SHEET No.	DRAWING No.	Discipline	TITLE
1	12039-W-63	GENERAL	TITLE SHEET	27	12039-W-63	MECHANICAL	LONGITUDINAL SECTION
2	12039-W-63	GENERAL	LOCATION MAP/GENERAL NOTES	28	12039-W-63	MECHANICAL	PIPING CROSS SECTION THROUGH STATION & MISCELLANEOUS DETAILS
3	12039-W-63	CIVIL	SITE PLAN - EXISTING CONDITIONS AND DEMOLITION	29	12039-W-63	MECHANICAL	REHABILITATION OF DRY WELL FOR WET WELL SERVICE - 1
4	12039-W-63	CIVIL	SITE PLAN - REQUIRED STATION AND PIPING	29A	12039-W-63	MECHANICAL	REHABILITATION OF DRY WELL FOR WET WELL SERVICE - 2
5	12039-W-63	CIVIL	SITE PAVING AND FENCING PLAN	30	12039-W-63	--	REFERENCE DRAWING
5A	12039-W-63	CIVIL	WOOD FENCING DETAILS	31	12039-W-63	--	REFERENCE DRAWING
6	12039-W-63	CIVIL	MISCELLANEOUS SITEWORK DETAILS	32	12039-W-63	--	REFERENCE DRAWING
7	12039-W-63	CIVIL	SEWER NOTES	33	12039-W-63	--	REFERENCE DRAWING
8	12039-W-63	ARCHITECTURAL	FLOOR FRAMING AND ROOF PLANS	34	12039-W-63	--	REFERENCE DRAWING
9	12039-W-63	ARCHITECTURAL	BUILDING ELEVATIONS	35	5030-P1	ELECTRICAL	ELECTRICAL - REQUIRED SITE PLAN
10	12039-W-63	ARCHITECTURAL	BUILDING SECTIONS	36	5030-P2	ELECTRICAL	ELEMENTARY, PNEUMATIC, CONTROL AND ONE LINE DIAGRAMS
11	12039-W-63	ARCHITECTURAL	ARCHITECTURAL DETAILS	37	5030-P3	ELECTRICAL	ELECTRICAL FLOOR PLAN, EXTERIOR WALL ELEVATIONS AND DETAILS
12	12039-W-63	ARCHITECTURAL	ARCHITECTURAL DETAILS	38	5030-P4	ELECTRICAL	ELECTRICAL INTERIOR WALL ELEVATIONS AND DETAILS
13	12039-W-63	STRUCTURAL	BORING LOGS	39	5030-P5	ELECTRICAL	AUTOMATION CONTROL PANEL FABRICATION AND WIRING
14	12039-W-63	STRUCTURAL	STRUCTURAL NOTES	40	5030-P6	ELECTRICAL	SCADA PANEL RISER DIAGRAM AND DETAILS
15	12039-W-63	STRUCTURAL	FOUNDATION PLAN AND SECTIONS	41	5030-P7	ELECTRICAL	LIGHTNING PROTECTION PLAN AND DETAILS
16	12039-W-63	STRUCTURAL	OPERATING FLOOR FRAMING AND GRATING PLAN				
17	12039-W-63	STRUCTURAL	CEILING LEVEL FRAMING AND ROOF PLAN				
18	12039-W-63	STRUCTURAL	FRAMING SECTION AND DETAILS - 1				
19	12039-W-63	STRUCTURAL	FRAMING SECTION AND DETAILS - 2				
20	12039-W-63	STRUCTURAL	PLATFORM AND STAIR FRAMING PLAN				
21	12039-W-63	STRUCTURAL	STAIR SECTION AND DETAILS				
22	12039-W-63	STRUCTURAL	LADDER DETAILS				
23	12039-W-63	STRUCTURAL	ROOF SECTION AND DETAILS				
24	12039-W-63	STRUCTURAL	PPC PILE AND MISCELLANEOUS DETAILS				
25	12039-W-63	MECHANICAL	MECHANICAL EQUIPMENT LAYOUT PLAN				
26	12039-W-63	MECHANICAL	PIPING CROSS SECTION THROUGH STATION AND WET WELL				

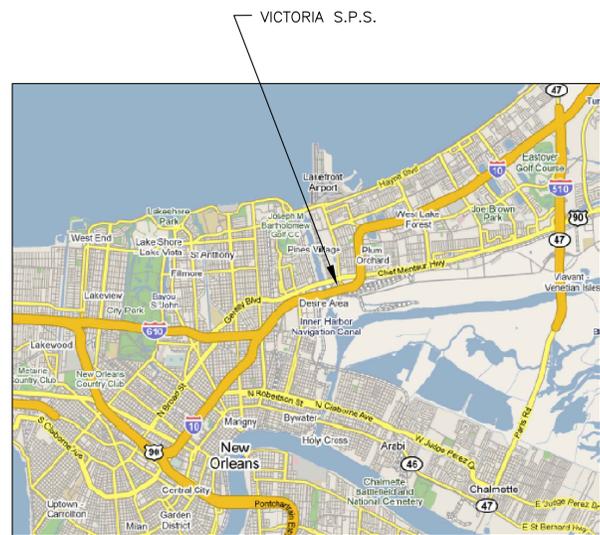


VICINITY MAP
AREA MAP NO SCALE

CONFORMED DOCUMENTS
FOR CONSTRUCTION

DESIGN ENGINEERING INC.
3530 West Esplanade, Ave. 5,
Suite 205
Metairie, LA 70002
(504) 836-2155



REV.	DATE	DESCRIPTION	BY
SEWERAGE AND WATER BOARD OF NEW ORLEANS			
CONTRACT 3668 HURRICANE KATRINA RELATED 404 HAZARD MITIGATION GRANT PROGRAM REPLACEMENT OF VICTORIA SEWAGE PUMPING STATION			
TITLE SHEET			
DR. TH/BD			
TRC. --			
CK. DS/CW			GENERAL SUPERINTENDENT
AP. JH			
SCALE: AS SHOWN		DWG. No. 12039-W-63	
DATE: SEPTEMBER 2013	SET NO.		SHEET NO. 1

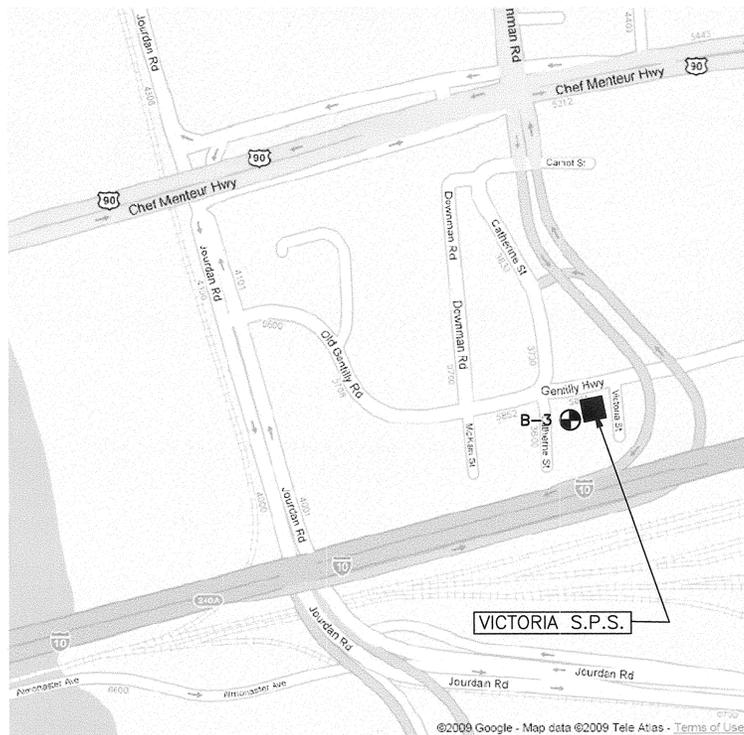

3620 VICTORIA STREET
 LOCATION MAP - VICTORIA S.P.S.
 AREA MAP NO SCALE

GENERAL NOTES:

1. THE CONTRACTOR SHALL VISIT THE SITE AND FAMILIARIZE HIMSELF WITH EXISTING SITE CONDITIONS IN ORDER TO OBTAIN A FULL UNDERSTANDING OF WORK TO BE DONE.
2. PRIOR TO ANY DEMOLITION, CLEARING AND OR EXCAVATION (IF NEEDED), THE CONTRACTOR SHALL LOCATE ALL UNDERGROUND UTILITIES BY CALLING LOUISIANA ONE CALL AT 1-800-272-3020.
3. CONTRACTOR SHALL BE RESPONSIBLE FOR ANY AND ALL DAMAGES CAUSED TO EXISTING STRUCTURES AND UTILITIES DURING CONSTRUCTION AT NO ADDITIONAL COST TO THE SWBNO.
4. CONTRACTOR SHALL CONTACT PROJECT MANAGER'S OFFICE IMMEDIATELY CONCERNING ANY CONFLICTS THAT ARISE DURING THE COURSE OF CONSTRUCTION ACTIVITIES.
5. THE EXISTING PUMPING STATION SHALL REMAIN IN SERVICE AS LONG AS POSSIBLE DURING CONSTRUCTION OF THE NEW STATION. WHEN THE EXISTING STATION IS NO LONGER OPERABLE, THE CONTRACTOR SHALL PROVIDE TEMPORARY BY-PASS PUMPING IN ACCORDANCE WITH SECTION 13 OF THE SPECIFICATIONS.
6. THE CONTRACTOR SHALL NOTIFY THE SWBNO AND THE PROGRAM MANAGER IF THEY PLAN TO WORK ON A SWBNO HOLIDAY OR A WEEKEND DAY. THE SWBNO HAS THE FINAL AUTHORIZATION ON WORK PERFORMED THAT IS NOT ON REGULAR WORK DAYS.
7. THE CONTRACTOR SHALL BE RESPONSIBLE FOR DETERMINING THE EXACT LOCATION, DEPTH, AND SIZE OF ALL UNDERGROUND UTILITIES AND STRUCTURES AND SHALL BE LIABLE FOR ANY DAMAGE CAUSED BY FAILURE TO COMPLY WITH THESE INSTRUCTIONS. PRIOR TO COMMENCING CONSTRUCTION, THE CONTRACTOR SHALL PERFORM EXPLORATORY EXCAVATIONS (POT-HOLING) TO DETERMINE THE LOCATION OF EXISTING UTILITIES AFFECTED BY THIS CONSTRUCTION AND SHALL REPORT HIS FINDINGS TO THE BOARD ENGINEER. THE CONTRACTOR SHALL INCLUDE IN HIS BID, EXPLORATORY EXCAVATIONS FOR A MINIMUM OF FIVE (5) LOCATIONS, HAVING A DEPTH RANGING FROM FIVE FEET TO TWELVE FEET.
8. ALL WORK SHALL CONFORM TO THE CITY OF NEW ORLEANS DEPARTMENT OF PUBLIC WORKS (CNO-DPW), THE SEWERAGE AND WATER BOARD OF NEW ORLEANS(SWBNO), LOUISIANA DEPARTMENT OF PUBLIC HOSPITALS (DHH) AND OCCUPATIONAL SAFETY AND HEALTH ADMINISTRATION (OSHA) STANDARDS.
9. THE CONTRACTOR IS RESPONSIBLE FOR REMOVAL OF DIRT AND DEBRIS FROM STREETS AND ROADWAYS AND PROJECT SITE GENERATED BY CONSTRUCTION ACTIVITIES.
10. THE CONTRACTOR IS RESPONSIBLE FOR REPAIRING ALL DAMAGE TO ADJACENT PAVEMENT AND FENCING WHICH RESULTS FROM THE CONTRACTOR'S CONSTRUCTION ACTIVITIES AT NO ADDITIONAL COST TO THE SWBNO.
11. CONTRACTOR SHALL CLEAN AND PAINT ALL EXPOSED SURFACES OF MECHANICAL EQUIPMENT, PIPING, PIPE SUPPORTS, AND OTHER ELEMENTS IN ACCORDANCE WITH SECTION 11 OF THE SPECIFICATIONS.
12. BUILDING SIZES AND MECHANICAL EQUIPMENT LAYOUTS INDICATED ON THESE DRAWINGS ARE BASED ON GORMAN-RUPP PUMPS AND BALDOR MOTORS. CONTRACTOR SHALL VERIFY PUMP STATION DIMENSIONS WITH EQUIPMENT MANUFACTURER'S SHOP DRAWINGS TO ENSURE PROPER FIT WITHIN THE STRUCTURE.
13. CONTRACTOR SHALL PROTECT ADJACENT PROPERTY AND IMPROVEMENTS FROM DAMAGE AND REPLACE ANY PORTIONS DAMAGED THROUGH HIS OPERATION AT HIS OWN EXPENSE. ALL REPAIR WORK SHALL BE TO THE SATISFACTION OF THE SWBNO.
14. CONTRACTOR SHALL RE-GRADE ALL AREAS ALTERED BY CONSTRUCTION ACTIVITIES TO PROVIDE POSITIVE DRAINAGE. ALL WORK SHALL BE IN A MANNER ACCEPTABLE TO THE SWBNO.
15. CONTRACTOR SHALL PROVIDE A MINIMUM OF 48 HOURS ADVANCE NOTICE TO THOSE AFFECTED BY CONSTRUCTION ACTIVITIES THAT MAY DISRUPT WATER, SEWER, OR OTHER UTILITY SERVICES. UTILITY SERVICES SHALL BE PROMPTLY REPAIRED AND SHALL NOT REMAIN OUT OF SERVICE OVERNIGHT.
16. CONTRACTOR SHALL AT ALL TIMES CONDUCT HIS OPERATION TO ENSURE MINIMAL INCONVENIENCE TO THE GENERAL PUBLIC, ADJACENT PROPERTY OWNERS, AND BUSINESSES. CONTRACTOR SHALL PROVIDE AND MAINTAIN ACCESS TO ALL PROPERTIES AND TRAFFIC FLOW IN ROADWAYS AT ALL TIMES.
17. ALL GRASS AREAS ALTERED SHALL BE SEEDED, FERTILIZED, WATERED, AND MAINTAINED BY THE CONTRACTOR UNTIL FINAL ACCEPTANCE OF THE PROJECT. CONTRACTOR SHALL WATER DAILY FROM SEEDING UNTIL 2 WEEKS AFTER GERMINATION.
18. THE CONTRACTOR SHALL CONTACT THE FOLLOWING ENTITIES AT LEAST FIVE (5) WORKING DAYS PRIOR TO BEGINNING CONSTRUCTION ACTIVITIES:
 SEWERAGE AND WATER BOARD OF NEW ORLEANS
 BKI: DENNIS GARRARD 504-486-5901
 LOUISIANA ONE CALL - 1-800-272-3020
19. ALL MISCELLANEOUS METAL WORK, INCLUDING PIPE SUPPORTS AND BRACKETS TO BE INSTALLED WITHIN THE WET WELL SHALL BE MANUFACTURED ENTIRELY OF TYPE 316 STAINLESS STEEL. LIKEWISE, ALL FASTENERS, INCLUDING ANCHOR BOLTS INSTALLED WITHIN THE WET WELL SHALL BE MANUFACTURED OF STAINLESS STEEL. THREADS OF ALL STAINLESS STEEL FASTENERS SHALL BE TREATED WITH AN ANTI-SEIZE COMPOUND FORMULATED FOR USE WITH STAINLESS STEEL, SUCH AS "PURE NICKEL SPECIAL ANTI SEIZE COMPOUND", MANUFACTURED BY "NEVER-SEEZ", OR EQUAL.
20. COMPLETED INSTALLATION SHALL COMPLY WITH ALL APPLICABLE LAWS, LOCAL CODES, AND THE LATEST EDITION OF THE NATIONAL ELECTRICAL CODE.
21. ALL ELECTRICAL EQUIPMENT SHALL BE FURNISHED AND INSTALLED OR RELOCATED TO EXISTING FACILITIES, IN ACCORDANCE WITH SECTION 15 OF THE SPECIFICATIONS.
22. NAMEPLATES CONTAINING PERTINENT DATA SHALL BE INSTALLED ON ALL THE EQUIPMENT THAT IS INSTALLED BY THE CONTRACTOR.
23. TESTING SHALL BE PERFORMED BY QUALIFIED TESTING AGENCIES AND FIELD SERVICE COMPANIES AS NECESSARY TO AUGMENT THE CONTRACTOR'S OWN CAPABILITIES. TESTING AND REPORTING METHODS SHALL COMPLY WITH APPLICABLE CITY OF NEW ORLEANS STANDARDS. ALL TEST RESULTS SHALL BE PUBLISHED ON THE CONTRACTOR'S OR TESTING COMPANY'S LETTERHEAD OR TEST FORMS BEARING THE LEGAL NAME AND ADDRESS OF THE COMPANY.
24. THE NEW STRUCTURES SHOWN ARE TO BE TIED INTO EXISTING PIPING. THE CONTRACTOR SHALL FIELD VERIFY ALL EXISTING CONDITIONS SHOWN ON THE DRAWINGS THAT RELATE TO NEW WORK. THE CONTRACTOR SHALL NOTIFY THE ENGINEER OF ANY DISCREPANCIES PRIOR TO FABRICATION OR CONSTRUCTION.
25. CITY OF NEW ORLEANS DEPARTMENT OF PUBLIC WORKS (CNO-DPW) STANDARD DRAWINGS ARE AVAILABLE FROM THE CNO-DPW ENGINEERING DIVISION, CITY HALL, 1300 PERDIDO STREET, ROOM 6W03, NEW ORLEANS, LOUISIANA 70012, OR ONLINE AT www.nola.gov.




DESIGN ENGINEERING INC.
 3330 West Esplanade Ave. 5
 Suite 205
 Metairie, LA 70002
 (504) 836-2155

REV.	DATE	DESCRIPTION	BY
SEWERAGE AND WATER BOARD OF NEW ORLEANS			
CONTRACT 3668 HURRICANE KATRINA RELATED 404 HAZARD MITIGATION GRANT PROGRAM REPLACEMENT OF VICTORIA SEWAGE PUMPING STATION			
LOCATION MAP/GENERAL NOTES			
DR. TH/BD			
TRC. --			
CK. DS/CW			
AP. JH			
SCALE: AS SHOWN			
DATE: JANUARY 2012	SET NO.		SHEET NO. 2

GENERAL SUPERINTENDENT
 DWG. No. 12039-W-63


PRINTED May 31, 2013 - 8:59am FILENAME - J:\6005.1-GOSHEP-2013\Contract 3668 - Victoria SPS_SHT 3_VIC_EXSITE.dwg

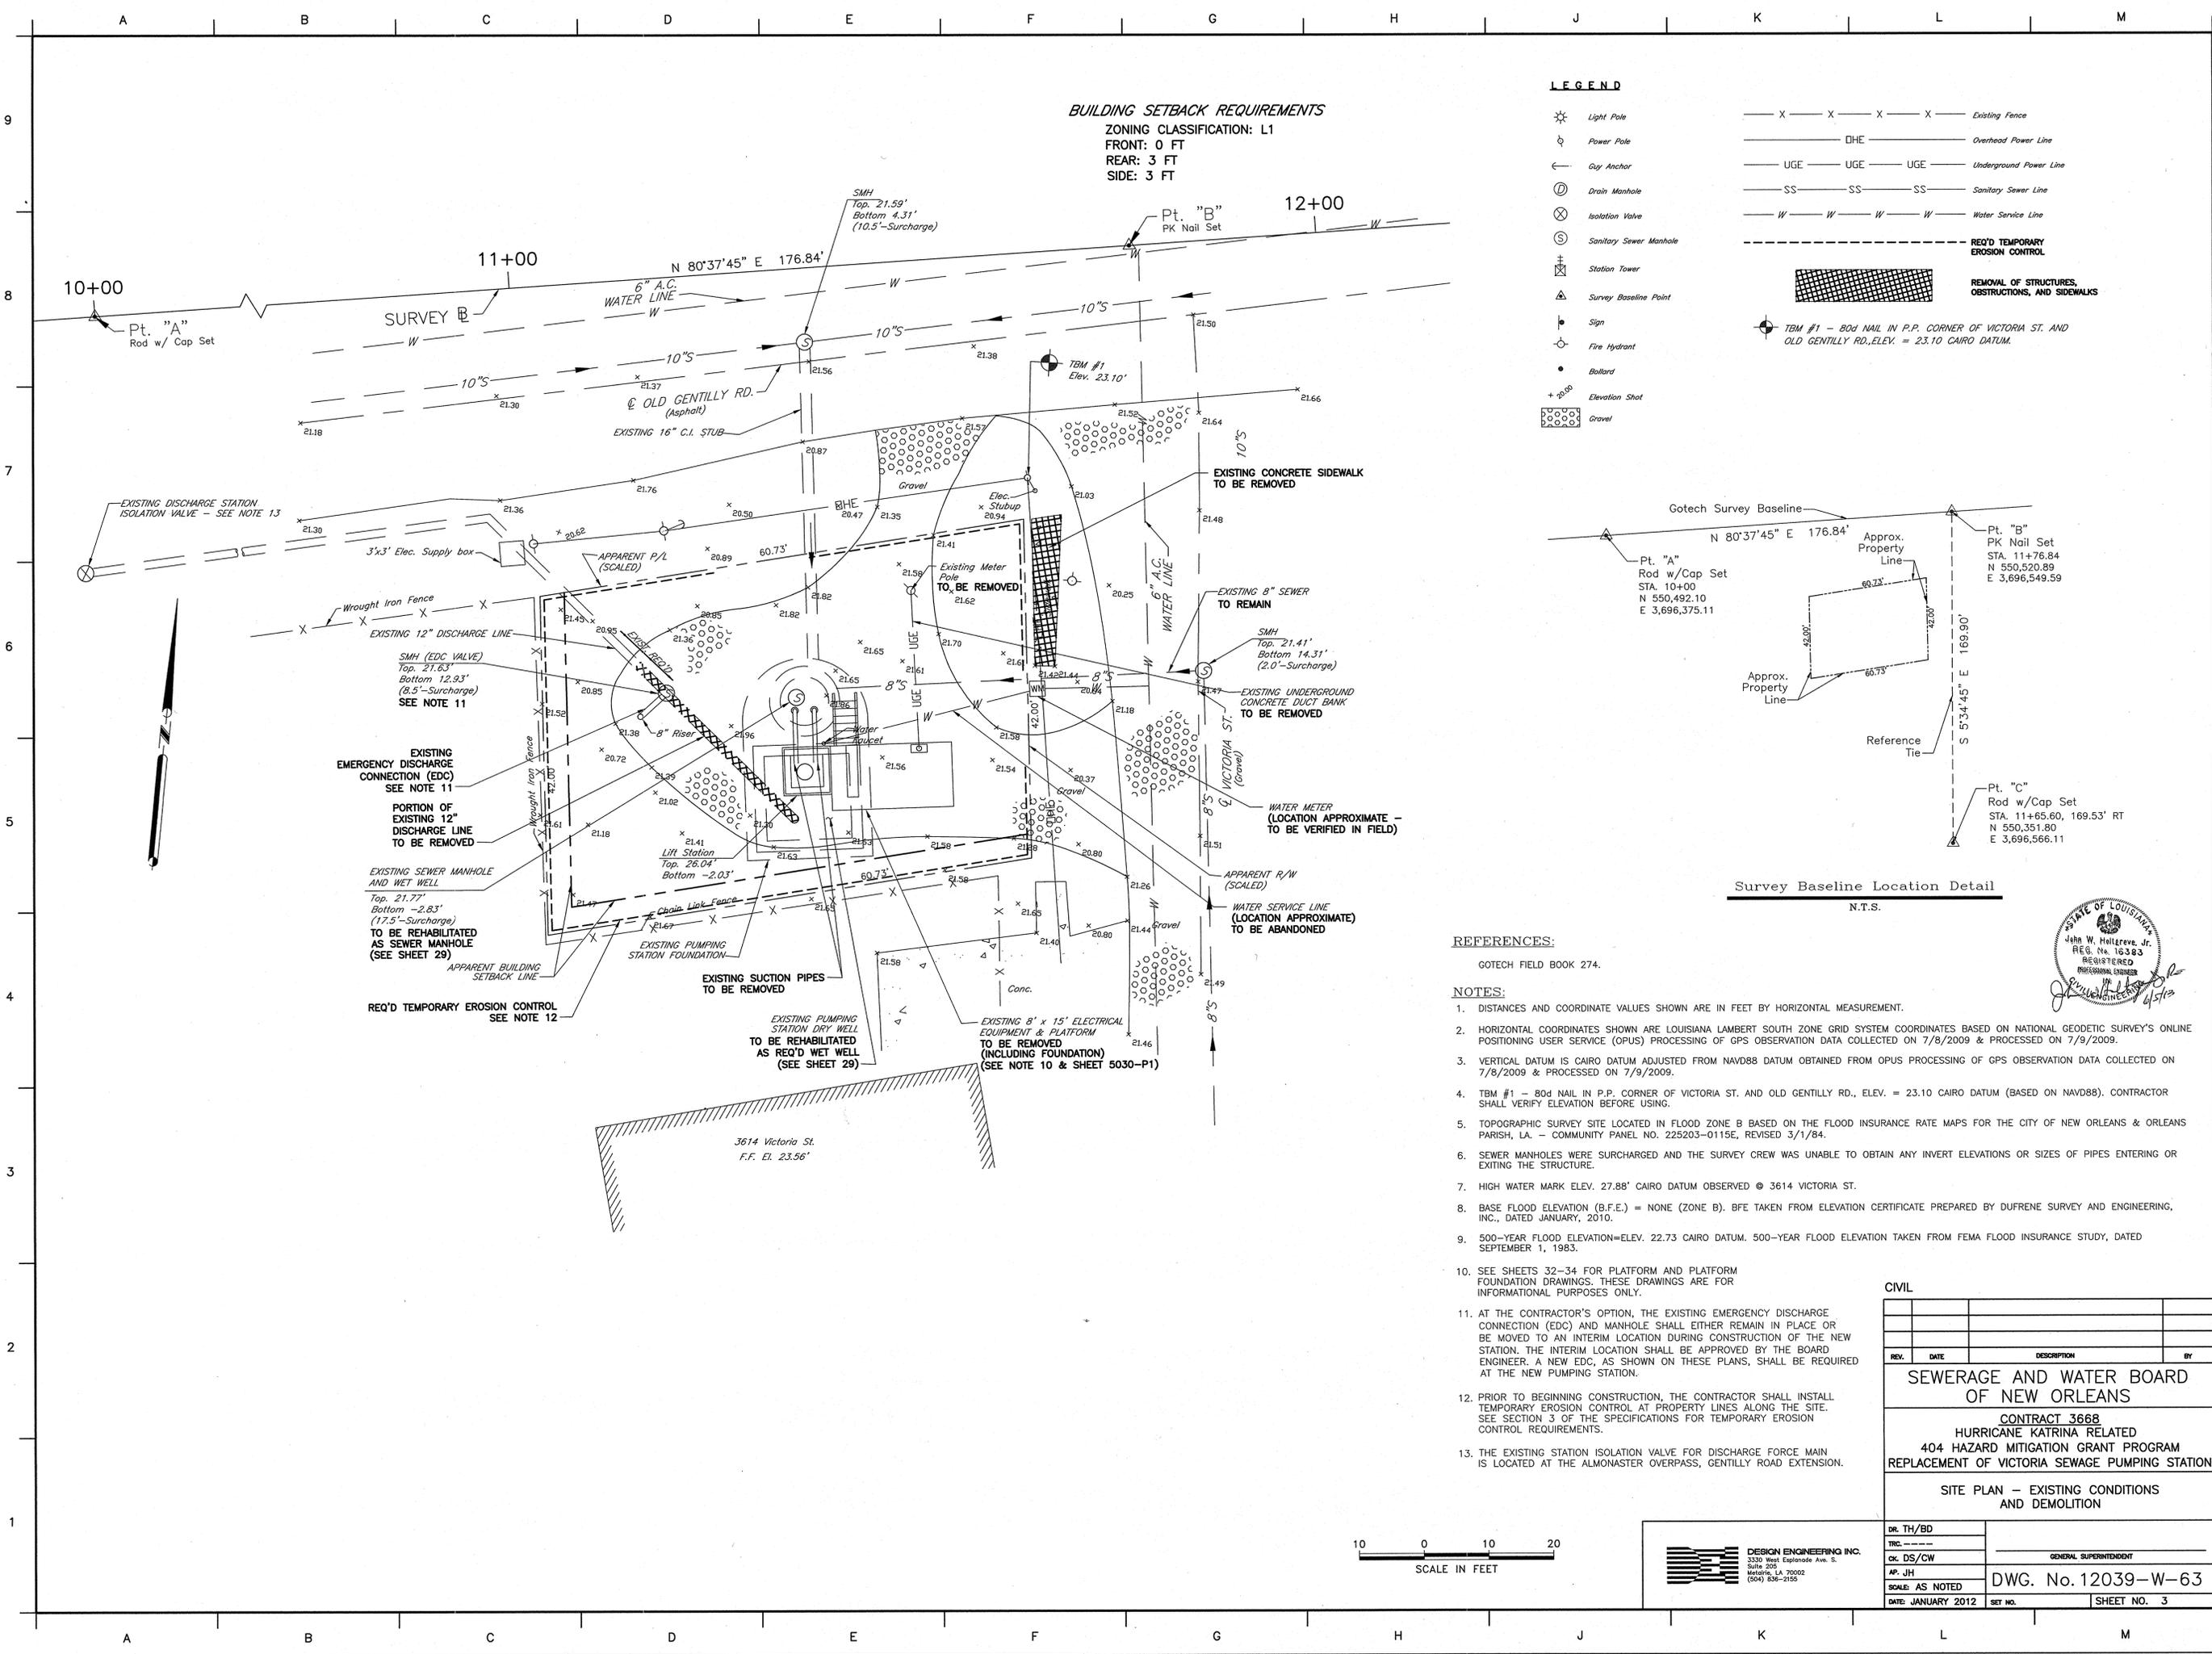

BUILDING SETBACK REQUIREMENTS
 ZONING CLASSIFICATION: L1
 FRONT: 0 FT
 REAR: 3 FT
 SIDE: 3 FT

LEGEND

- ☼ Light Pole
- ⊕ Power Pole
- ← Guy Anchor
- ⊙ Drain Manhole
- ⊗ Isolation Valve
- ⊙ Sanitary Sewer Manhole
- ⊕ Station Tower
- △ Survey Baseline Point
- ⊕ Sign
- ⊕ Fire Hydrant
- Bollard
- + Elevation Shot
- ⊙ Gravel
- X — X — X — X — Existing Fence
- DHE — Overhead Power Line
- UGE — UGE — UGE — Undergroud Power Line
- SS — SS — SS — Sanitary Sewer Line
- W — W — W — W — Water Service Line
- REQ'D TEMPORARY EROSION CONTROL
- REMOVAL OF STRUCTURES, OBSTRUCTIONS, AND SIDEWALKS
- ⊕ TBM #1 - 80d NAIL IN P.P. CORNER OF VICTORIA ST. AND OLD GENTILLY RD., ELEV. = 23.10 CAIRO DATUM.

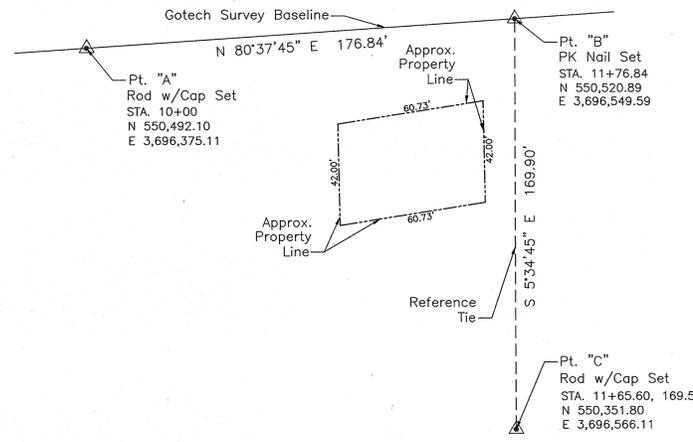

REFERENCES:

GOTECH FIELD BOOK 274.

NOTES:

1. DISTANCES AND COORDINATE VALUES SHOWN ARE IN FEET BY HORIZONTAL MEASUREMENT.
2. HORIZONTAL COORDINATES SHOWN ARE LOUISIANA LAMBERT SOUTH ZONE GRID SYSTEM COORDINATES BASED ON NATIONAL GEODETIC SURVEY'S ONLINE POSITIONING USER SERVICE (OPUS) PROCESSING OF GPS OBSERVATION DATA COLLECTED ON 7/8/2009 & PROCESSED ON 7/9/2009.
3. VERTICAL DATUM IS CAIRO DATUM ADJUSTED FROM NAVD88 DATUM OBTAINED FROM OPUS PROCESSING OF GPS OBSERVATION DATA COLLECTED ON 7/8/2009 & PROCESSED ON 7/9/2009.
4. TBM #1 - 80d NAIL IN P.P. CORNER OF VICTORIA ST. AND OLD GENTILLY RD., ELEV. = 23.10 CAIRO DATUM (BASED ON NAVD88). CONTRACTOR SHALL VERIFY ELEVATION BEFORE USING.
5. TOPOGRAPHIC SURVEY SITE LOCATED IN FLOOD ZONE B BASED ON THE FLOOD INSURANCE RATE MAPS FOR THE CITY OF NEW ORLEANS & ORLEANS PARISH, LA. - COMMUNITY PANEL NO. 225203-0115E, REVISED 3/1/84.
6. SEWER MANHOLES WERE SURCHARGED AND THE SURVEY CREW WAS UNABLE TO OBTAIN ANY INVERT ELEVATIONS OR SIZES OF PIPES ENTERING OR EXITING THE STRUCTURE.
7. HIGH WATER MARK ELEV. 27.88' CAIRO DATUM OBSERVED @ 3614 VICTORIA ST.
8. BASE FLOOD ELEVATION (B.F.E.) = NONE (ZONE B). BFE TAKEN FROM ELEVATION CERTIFICATE PREPARED BY DUFRENE SURVEY AND ENGINEERING, INC., DATED JANUARY, 2010.
9. 500-YEAR FLOOD ELEVATION=ELEV. 22.73 CAIRO DATUM. 500-YEAR FLOOD ELEVATION TAKEN FROM FEMA FLOOD INSURANCE STUDY, DATED SEPTEMBER 1, 1983.
10. SEE SHEETS 32-34 FOR PLATFORM AND PLATFORM FOUNDATION DRAWINGS. THESE DRAWINGS ARE FOR INFORMATIONAL PURPOSES ONLY.
11. AT THE CONTRACTOR'S OPTION, THE EXISTING EMERGENCY DISCHARGE CONNECTION (EDC) AND MANHOLE SHALL EITHER REMAIN IN PLACE OR BE MOVED TO AN INTERIM LOCATION DURING CONSTRUCTION OF THE NEW STATION. THE INTERIM LOCATION SHALL BE APPROVED BY THE BOARD ENGINEER. A NEW EDC, AS SHOWN ON THESE PLANS, SHALL BE REQUIRED AT THE NEW PUMPING STATION.
12. PRIOR TO BEGINNING CONSTRUCTION, THE CONTRACTOR SHALL INSTALL TEMPORARY EROSION CONTROL AT PROPERTY LINES ALONG THE SITE. SEE SECTION 3 OF THE SPECIFICATIONS FOR TEMPORARY EROSION CONTROL REQUIREMENTS.
13. THE EXISTING STATION ISOLATION VALVE FOR DISCHARGE FORCE MAIN IS LOCATED AT THE ALMONASTER OVERPASS, GENTILLY ROAD EXTENSION.

CIVIL


REV.	DATE	DESCRIPTION	BY

SEWERAGE AND WATER BOARD OF NEW ORLEANS

CONTRACT 3668
HURRICANE KATRINA RELATED
404 HAZARD MITIGATION GRANT PROGRAM
REPLACEMENT OF VICTORIA SEWAGE PUMPING STATION

SITE PLAN - EXISTING CONDITIONS AND DEMOLITION


DR. TH/BD	
TRC. ---	
CK. DS/CW	GENERAL SUPERINTENDENT
AP. JH	DWG. No. 12039-W-63
SCALE: AS NOTED	
DATE: JANUARY 2012	SHEET NO. 3

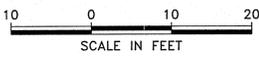

DESIGN ENGINEERING INC.
 3330 West Esplanade Ave. S.
 Suite 205
 Metairie, LA 70002
 (504) 886-2155



PRINTED May 31, 2013 - 9:02am FILENAME - J:\6005.1-GOSHEP-2013\Contract 3668 - Victoria SPS\SHT 5_VIC_EXSITE-FENCE-DET.dwg

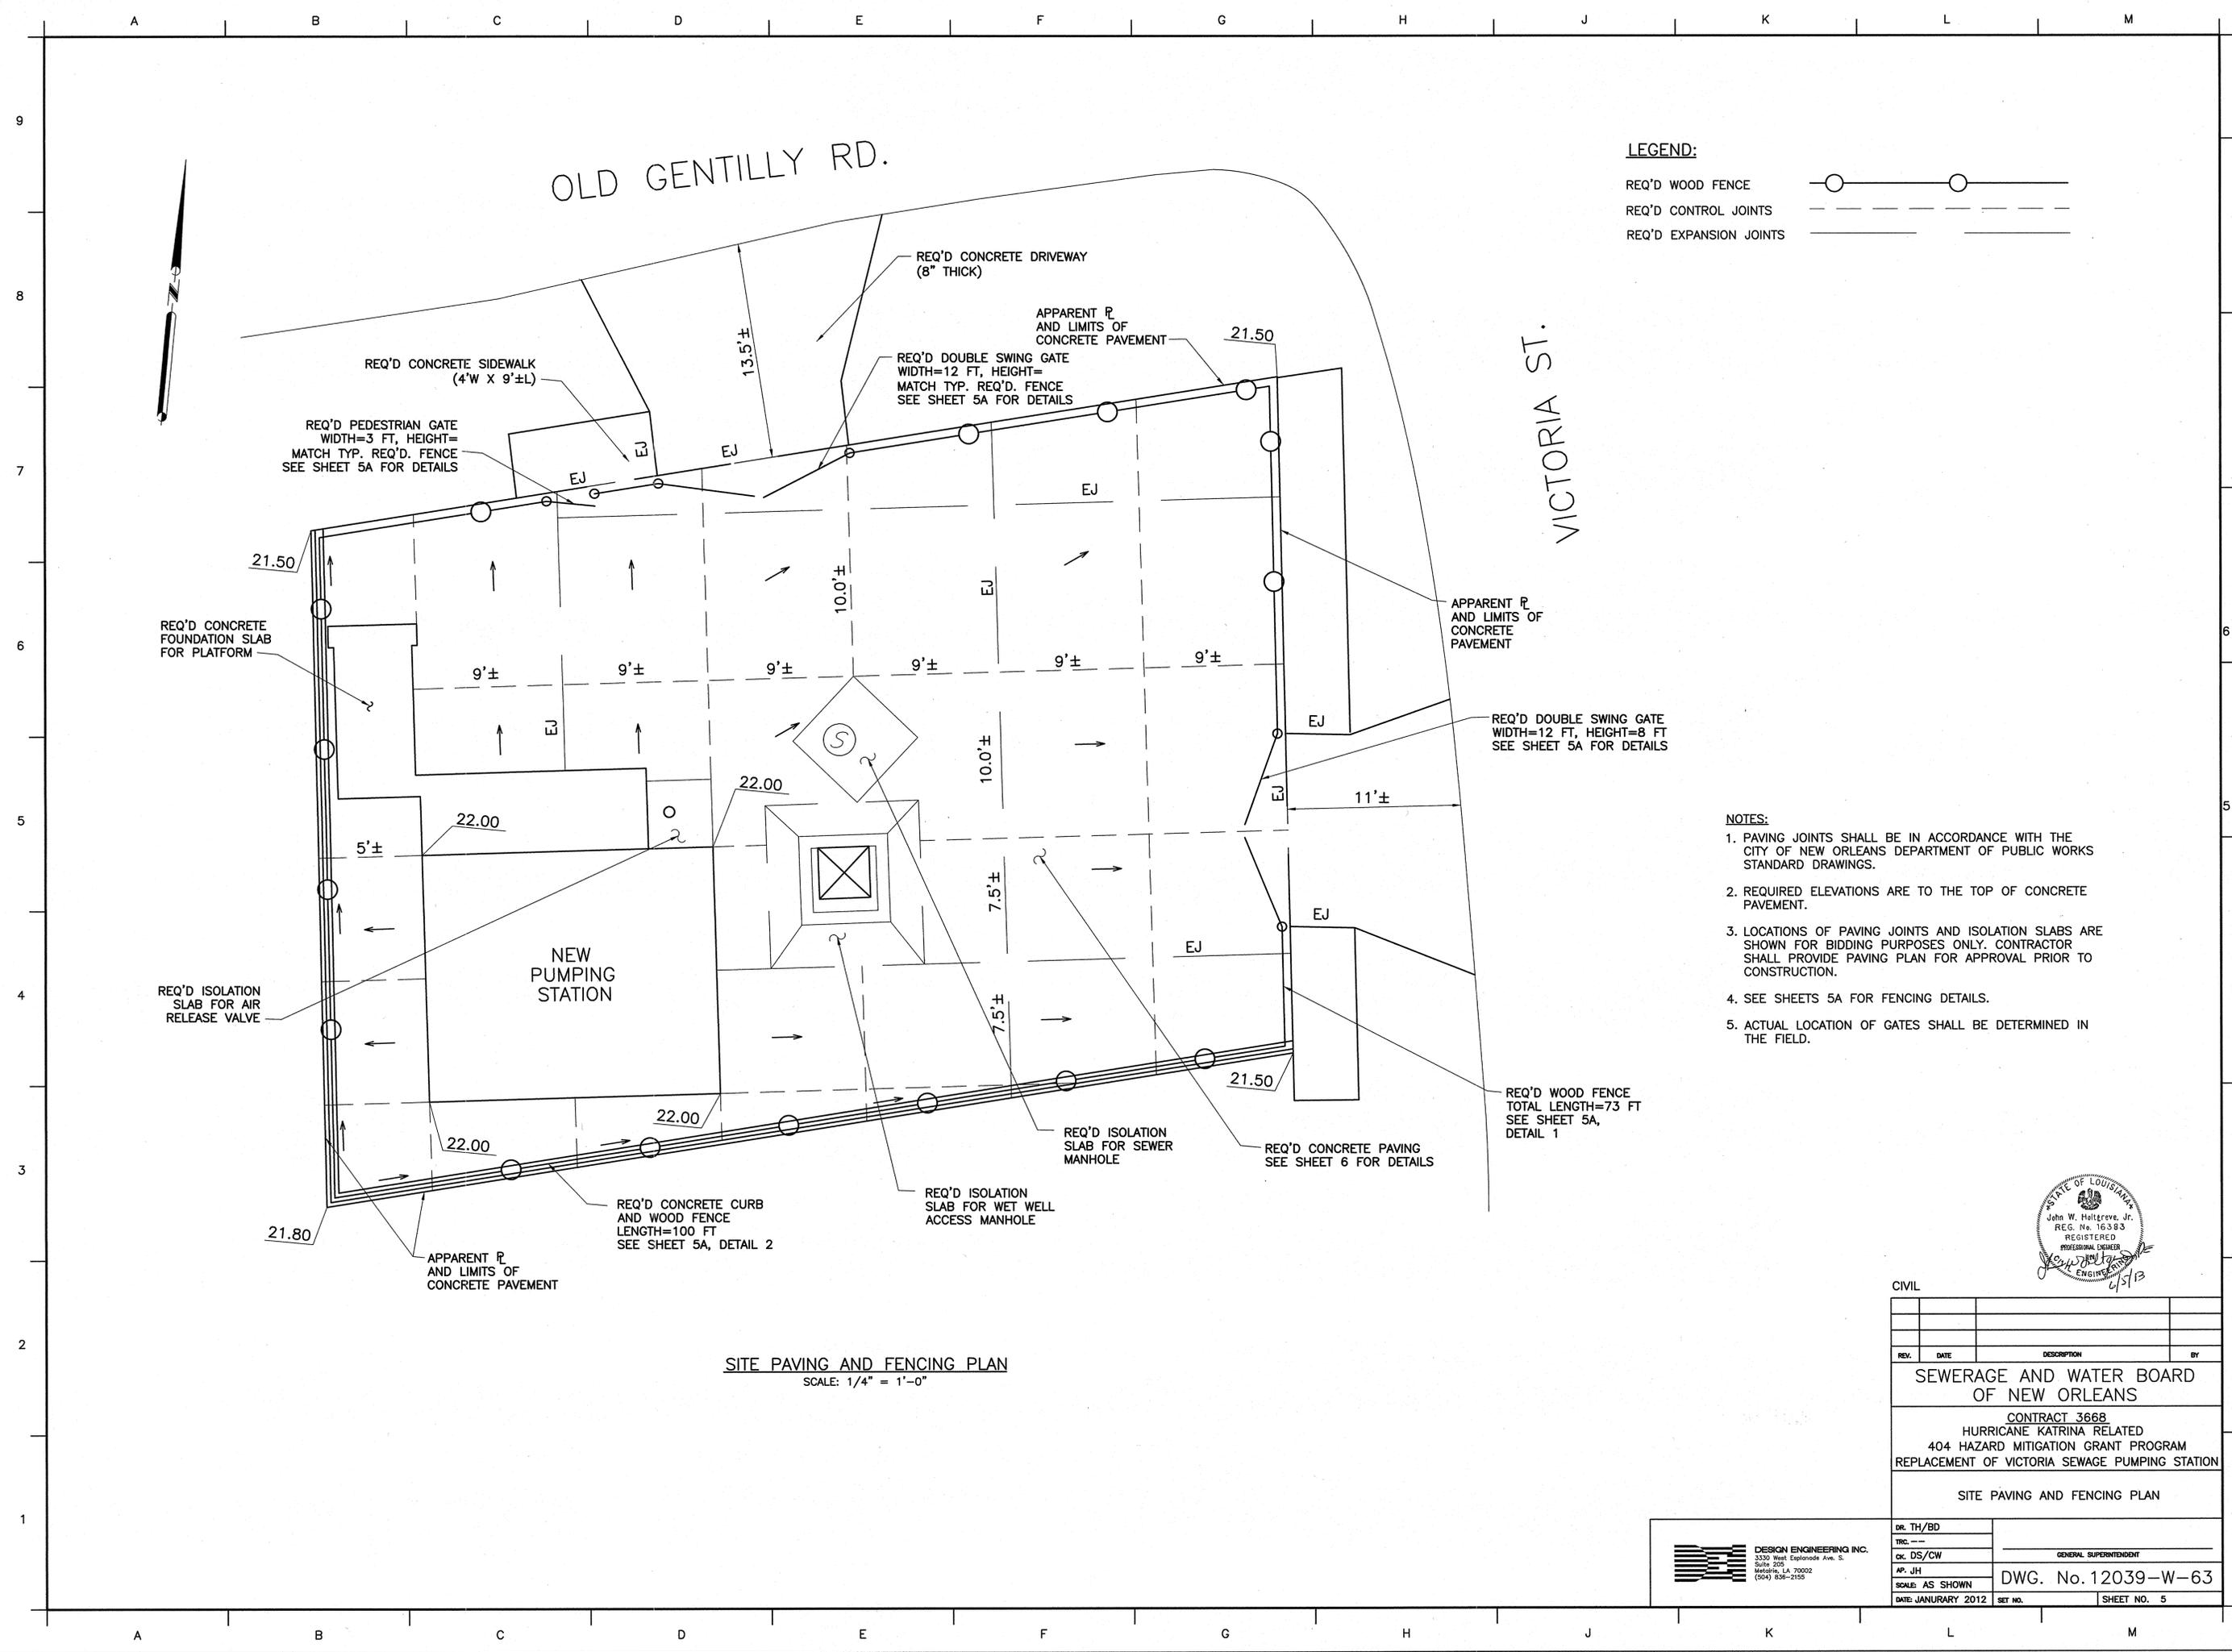

LEGEND:
 REQ'D WOOD FENCE
 REQ'D CONTROL JOINTS
 REQ'D EXPANSION JOINTS

- NOTES:**
1. PAVING JOINTS SHALL BE IN ACCORDANCE WITH THE CITY OF NEW ORLEANS DEPARTMENT OF PUBLIC WORKS STANDARD DRAWINGS.
 2. REQUIRED ELEVATIONS ARE TO THE TOP OF CONCRETE PAVEMENT.
 3. LOCATIONS OF PAVING JOINTS AND ISOLATION SLABS ARE SHOWN FOR BIDDING PURPOSES ONLY. CONTRACTOR SHALL PROVIDE PAVING PLAN FOR APPROVAL PRIOR TO CONSTRUCTION.
 4. SEE SHEETS 5A FOR FENCING DETAILS.
 5. ACTUAL LOCATION OF GATES SHALL BE DETERMINED IN THE FIELD.



SITE PAVING AND FENCING PLAN
 SCALE: 1/4" = 1'-0"



CIVIL			
REV.	DATE	DESCRIPTION	BY
SEWERAGE AND WATER BOARD OF NEW ORLEANS			
CONTRACT 3668 HURRICANE KATRINA RELATED 404 HAZARD MITIGATION GRANT PROGRAM REPLACEMENT OF VICTORIA SEWAGE PUMPING STATION			
SITE PAVING AND FENCING PLAN			


DESIGN ENGINEERING INC. 3330 West Esplanade Ave. S. Suite 205 Metairie, LA 70002 (504) 885-0155	DR. TH/BD	
	TRC. ---	
	CK. DS/CW	GENERAL SUPERINTENDENT
	AP. JH	DWG. No. 12039-W-63
SCALE: AS SHOWN	DATE: JANUARY 2012	SHEET NO. 5

PRINTED May 31, 2013 - 9:04am FILENAME - J:\6005.1-GOSHEP-2013\Contract 3668 - Victoria SPS\SH 5A_VIC_EXSITE-FENCE-DET.dwg

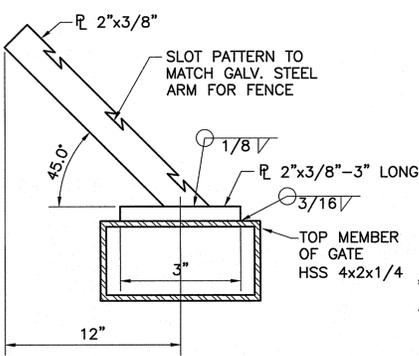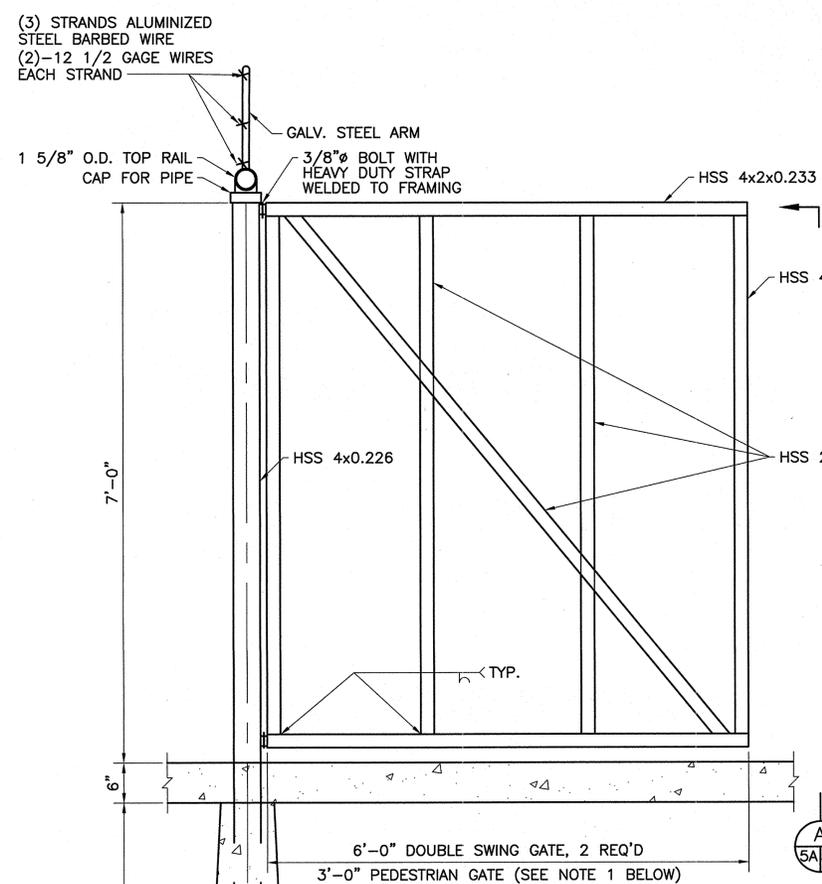


NOTES:
 1. ONLY ONE VERTICAL MEMBER, HSS 2x2x0.233, SHALL BE REQUIRED FOR THE 3'-0\"/>

DETAIL OF GATE

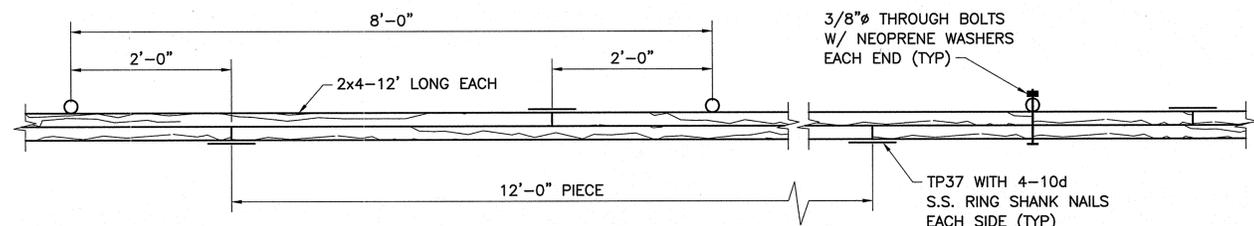

PLAN

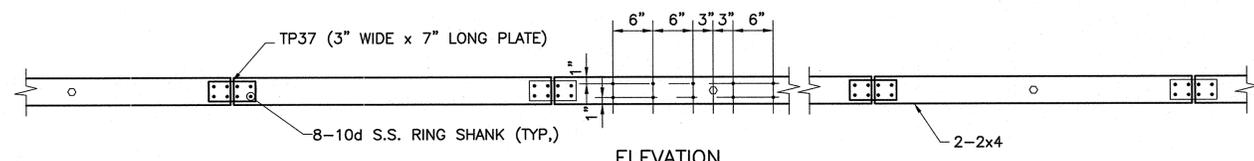


ELEVATION

TYPICAL RAIL SPLICE LOCATION


SCALE: 1" = 1'-0"

WOOD FENCE NOTES:

- OVERALL HEIGHT OF FENCE: 8' (7' WOOD SLAT, 1' OF BARBED WIRE)
- LINE POST: HSS GALV. PIPE, 2.375" O.D., 0.154" THICKNESS, SET NOT LESS THAN 36" IN CONC. AS SHOWN
- CORNER POST: HSS GALV. PIPE, 2.875" O.D., 0.203" THICKNESS, SET NOT LESS THAN 42" IN CONC. AS SHOWN
- GATE POST: HSS GALV. PIPE, 4.00" O.D., 0.226" THICKNESS, SET NOT LESS THAN 42" IN CONC. AS SHOWN
- BARBED WIRE: (3) STRANDS OF ALUMINIZED STL. SET ON GALV. STL. ARMS. USE A 4 POINT PATTERN BARBED WIRE ON 3" CENTERS, (2) 12-1/2" GA WIRES PER STRAND. GALV. STEEL ARM SHALL NOT EXTEND BEYOND PROPERTY LINE (P/L).
- TOP RAIL: 1-5/8" O.D. GALV. PIPE
- BRACING (CORNER & GATE POSTS): 1-5/8" O.D. GALV. PIPE
- DIAGONAL BRACE (GATE): HSS GALV. TUBE 4x2x0.233
- GATES SHALL BE PROVIDED WITH 1/2" KEPPER BARS, FORMED LATCH AND PADLOCK EYE.
- SLATS: RED CEDAR WITH A CHAMFERED TOP, TREATED WITH WATER REPELLENT PRESERVATIVE, WITH STAINLESS STEEL FASTENERS.
- RAILS: TWO (2) 2-INCH x 4 INCH x 12-FOOT PRESSURE TREATED NO. 2 PRIME, OR BETTER, SOUTHERN PINE LUMBER
- GATE FRAME: HSS GALVANIZED TUBE 2x2x0.233.

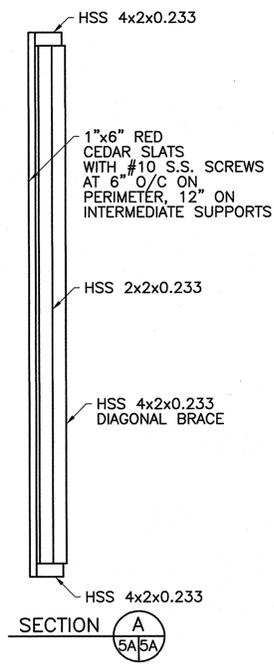


SECTION A-A

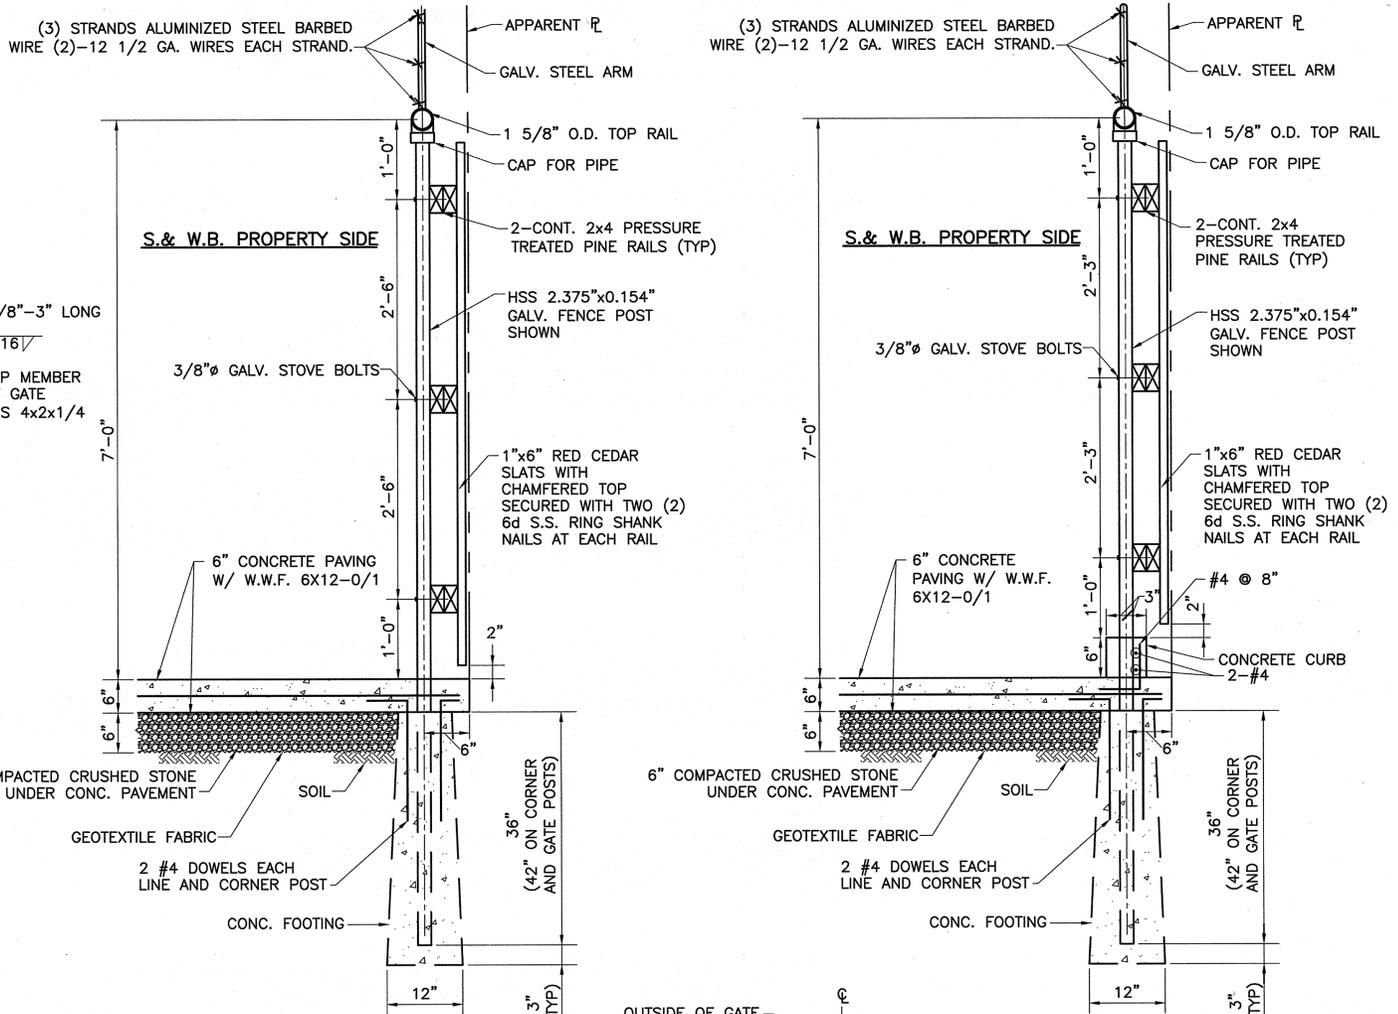

DETAIL 1
TYPICAL SECURITY FENCE
 (ALONG NORTH & EAST SIDES OF SITE)
 SCALE: 1" = 1'-0"

DETAIL 2
TYPICAL SECURITY FENCE WITH NEW CONCRETE CURB
 (ALONG SOUTH & WEST SIDES OF SITE)
 SCALE: 1" = 1'-0"

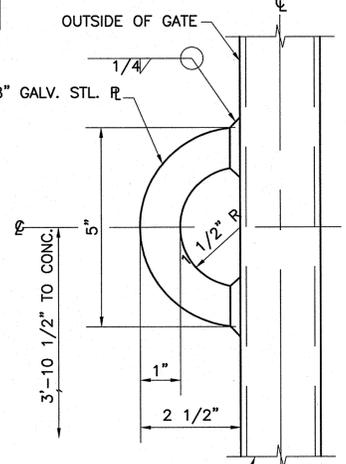

DETAIL OF PAD EYES FOR CHAIN LOCK



REV.	DATE	DESCRIPTION	BY

CIVIL

SEWERAGE AND WATER BOARD OF NEW ORLEANS


CONTRACT 3668
 HURRICANE KATRINA RELATED
 404 HAZARD MITIGATION GRANT PROGRAM
 REPLACEMENT OF VICTORIA SEWAGE PUMPING STATION

WOOD FENCING DETAILS

DR. TH/BD
 TRC. ---
 CK. DS/CW
 AP. JH
 SCALE: AS NOTED
 DATE: JANUARY 2012

GENERAL SUPERINTENDENT
DWG. No. 12039-W-63
 SHEET NO. 5A

PRINTED May 31, 2013 - 9:04am FILENAME - J:\6005.1-GOSHEP-2013\Contract 3668 - Victoria SPS\SHT 6_VIC_Misc Site Det.dwg

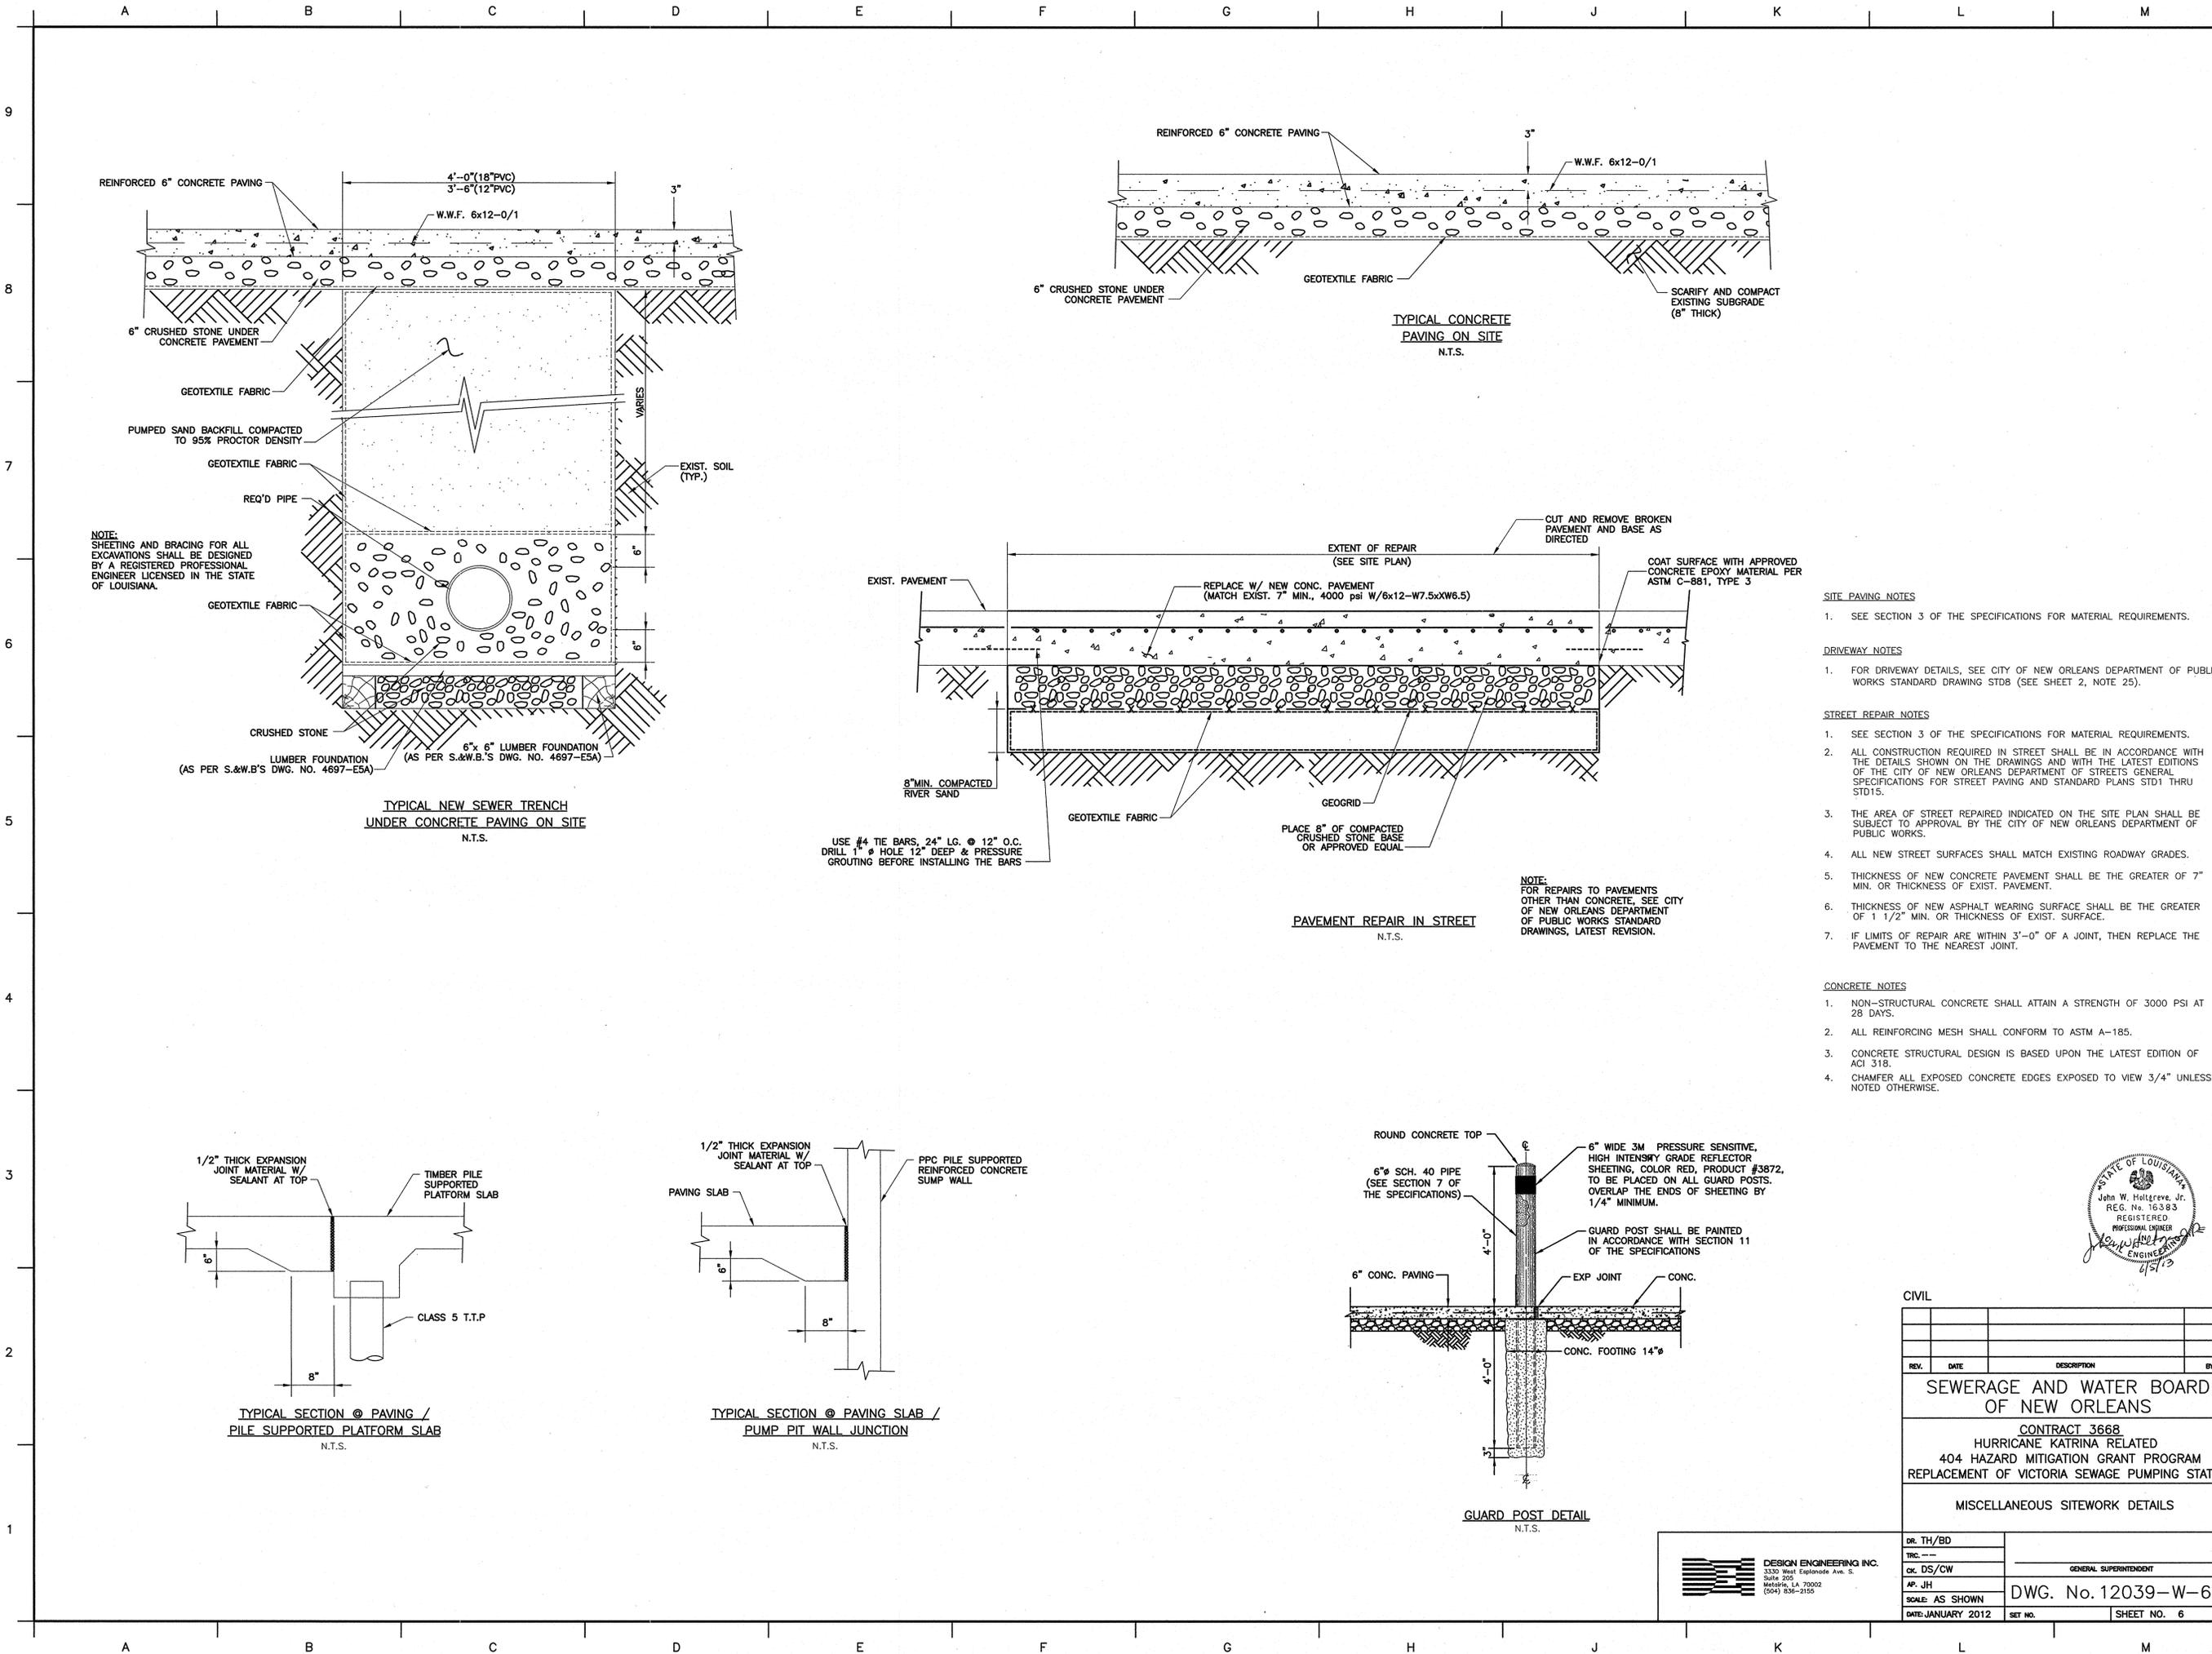

- SITE PAVING NOTES**
- SEE SECTION 3 OF THE SPECIFICATIONS FOR MATERIAL REQUIREMENTS.
- DRIVEWAY NOTES**
- FOR DRIVEWAY DETAILS, SEE CITY OF NEW ORLEANS DEPARTMENT OF PUBLIC WORKS STANDARD DRAWING STD8 (SEE SHEET 2, NOTE 25).
- STREET REPAIR NOTES**
- SEE SECTION 3 OF THE SPECIFICATIONS FOR MATERIAL REQUIREMENTS.
 - ALL CONSTRUCTION REQUIRED IN STREET SHALL BE IN ACCORDANCE WITH THE DETAILS SHOWN ON THE DRAWINGS AND WITH THE LATEST EDITIONS OF THE CITY OF NEW ORLEANS DEPARTMENT OF STREETS GENERAL SPECIFICATIONS FOR STREET PAVING AND STANDARD PLANS STD1 THRU STD15.
 - THE AREA OF STREET REPAIRED INDICATED ON THE SITE PLAN SHALL BE SUBJECT TO APPROVAL BY THE CITY OF NEW ORLEANS DEPARTMENT OF PUBLIC WORKS.
 - ALL NEW STREET SURFACES SHALL MATCH EXISTING ROADWAY GRADES.
 - THICKNESS OF NEW CONCRETE PAVEMENT SHALL BE THE GREATER OF 7" MIN. OR THICKNESS OF EXIST. PAVEMENT.
 - THICKNESS OF NEW ASPHALT WEARING SURFACE SHALL BE THE GREATER OF 1 1/2" MIN. OR THICKNESS OF EXIST. SURFACE.
 - IF LIMITS OF REPAIR ARE WITHIN 3'-0" OF A JOINT, THEN REPLACE THE PAVEMENT TO THE NEAREST JOINT.
- CONCRETE NOTES**
- NON-STRUCTURAL CONCRETE SHALL ATTAIN A STRENGTH OF 3000 PSI AT 28 DAYS.
 - ALL REINFORCING MESH SHALL CONFORM TO ASTM A-185.
 - CONCRETE STRUCTURAL DESIGN IS BASED UPON THE LATEST EDITION OF ACI 318.
 - CHAMFER ALL EXPOSED CONCRETE EDGES EXPOSED TO VIEW 3/4" UNLESS NOTED OTHERWISE.



CIVIL			
REV.	DATE	DESCRIPTION	BY
SEWERAGE AND WATER BOARD OF NEW ORLEANS			
CONTRACT 3668 HURRICANE KATRINA RELATED 404 HAZARD MITIGATION GRANT PROGRAM REPLACEMENT OF VICTORIA SEWAGE PUMPING STATION			
MISCELLANEOUS SITEWORK DETAILS			
DR. TH/BD	GENERAL SUPERINTENDENT		
TRC. --			
CK. DS/CW			
AP. JH	DWG. No. 12039-W-63		
SCALE: AS SHOWN	DATE: JANUARY 2012	SHEET NO.	SHEET NO. 6

DESIGN ENGINEERING INC.
3330 West Esplanade Ave. S.
Suite 205
Metairie, LA 70002
(504) 836-2155

SEWER NOTES

SEWER NOTES

I. GENERAL

1. IT IS TO BE UNDERSTOOD THAT ALL REFERENCES TO "THE SEWERAGE AND WATER BOARD (S&WB) ENGINEER" THROUGHOUT THIS DOCUMENT SHALL REFER TO THE GENERAL SUPERINTENDENT OF THE S&WB OR HIS APPOINTED REPRESENTATIVE, AND ALL REFERENCES TO "THE S&WB INSPECTOR" THROUGHOUT THIS DOCUMENT SHALL REFER TO THE S&WB INSPECTOR AS APPOINTED BY THE S&WB ENGINEER. THE S&WB INSPECTOR SHALL REPRESENT THE S&WB ENGINEER IN HIS/HER ABSENCE. IT IS ALSO TO BE UNDERSTOOD THAT ALL REFERENCES TO S&WB DRAWINGS AND SPECIFICATIONS REFER TO THE LATEST EDITION OR REVISION.

2. THE CONTRACTOR SHALL HAVE AN INDIVIDUAL WITH A WASTEWATER COLLECTION CLASS IV LICENSE, OBTAINED THROUGH THE LOUISIANA DEPARTMENT OF HEALTH AND HOSPITALS, ON SITE AT ALL TIMES DURING INSTALLATION OF THE SEWER LINES AND APPURTENANCES.

3. THE CONTRACTOR SHALL FURNISH ALL LABOR, SUPERVISION, MATERIALS, AND EQUIPMENT REQUIRED FOR THE INSTALLATION OF NEW SEWER MAINS, MANHOLES, HOUSE CONNECTIONS, ETC., REQUIRED BY THE PROJECT DRAWINGS AND SPECIFICATIONS.

4. ALL WORKMANSHIP AND MATERIALS SHALL CONFORM TO THE GENERAL SPECIFICATIONS OF THE S&WB. ANY MODIFICATION FROM THE DESIGN DRAWINGS MUST BE APPROVED BY THE S&WB ENGINEER PRIOR TO CONSTRUCTION.

5. PRIOR TO THE INSTALLATION OF ANY S&WB FACILITIES, THE ENTIRE AREA WITHIN THE PUBLIC RIGHT-OF-WAY, INCLUDING THE ENTIRE WIDTH OF ANY SERVITUDES ADJACENT TO THE FRONT PROPERTY LINE, PLUS AN ADDITIONAL 3 FT. MUST BE FILLED TO THE FINISHED GRADE.

6. ALL ELEVATIONS SHOWN ON THE DRAWINGS REFER TO CAIRO DATUM IN WHICH 0.00 FT. NGVD IS EQUAL TO 20.43 FT. CAIRO DATUM.

7. IT IS TO BE UNDERSTOOD THAT WHEREVER SAND IS STIPULATED IN THE SPECIFICATIONS OR DRAWINGS, IT SHALL REFER TO FINEST MISSISSIPPI RIVER SAND OR ANY NATURAL SAND DEPOSIT MEETING THE REQUIREMENTS OF ASHTO A-3 OR ASTM-SP.

8. THE CONTRACTOR SHALL NOTIFY THE GENERAL SUPERINTENDENT (625 ST. JOSEPH ST. N.O. LA 70165), WITH COPIES TO THE CHIEF OF ENGINEERING (8800 S. CLAIBORNE AVE N.O. LA 70118), AND THE CHIEF OF CONSTRUCTION ADMINISTRATION AND INSPECTION (8800 S. CLAIBORNE AVE N.O. LA 70118) OF THE S&WB IN WRITING NOT LESS THAN THREE NOR MORE THAN TEN DAYS IN ADVANCE OF STARTING THE PROJECT SO AS TO SCHEDULE THE INSPECTION OF ANY S&WB WORK. FAILURE TO DO SO PRIOR TO STARTING THIS WORK SHALL REQUIRE THE CONTRACTOR TO EXPOSE THE BEDDING ON ALL PIPE, OR ANY OTHER CONCEALED WORK PREVIOUSLY INSTALLED IN ORDER TO OBTAIN THE APPROVAL OF THE S&WB INSPECTOR. ANY WORK PERFORMED WITHOUT A S&WB INSPECTOR'S APPROVAL WILL NOT BE ACCEPTED BY THE S&WB NOR TIED INTO THE S&WB'S COLLECTION SYSTEM.

9. THE LOCATION OF EXISTING UTILITIES SHOWN ON THE DRAWINGS SHOULD BE CONSIDERED APPROXIMATE. THE CONTRACTOR SHALL VERIFY THE LOCATION OF ALL EXISTING STRUCTURE INVERTS AND LOCATION OF ALL EXISTING UTILITIES PRIOR TO THE START OF WORK, AND SHALL BE RESPONSIBLE FOR ANY NEGLIGENCE ON HIS PART IN PROTECTING THEM. THE LOCATION OF SEWER AND WATER HOUSE CONNECTIONS CAN BE OBTAINED FROM THE S&WB.

10. ALL S&WB MAINTAINED SEWER WORK PERFORMED BY THE CONTRACTOR WILL BE SUBJECT TO THE APPROVAL OF THE S&WB INSPECTOR. THE CONTRACTOR SHALL PROVIDE THE S&WB INSPECTOR FULL ACCESS TO THE WORK THROUGHOUT CONSTRUCTION AND ABIDE BY ANY JUSTIFIABLE S&WB INSPECTOR'S REQUEST TO EXPOSE ANY AND ALL WORK INSTALLED BY THE CONTRACTOR.

11. BACKFILL MATERIAL FOR ALL UTILITIES SHALL BE SAND EITHER COMPACTED MECHANICALLY IN 6 IN. LIFTS OR FLOODED IN 3 FT. LIFTS. COMPACTION SHALL BE PERFORMED TO 95% MAXIMUM DRY DENSITY, NEAR OPTIMUM WATER CONTENT, AND SHALL MEET THE COMPACTION CHARACTERISTICS OF ASTM D-1557.

12. SPECIFICATIONS FOR SEWER FORCE MAIN PIPE SHALL BE JOB SPECIFIC.

II. PIPE MATERIAL

1. MATERIAL FOR SEWER MAINS SHALL BE SOLID WALL PVC PIPE, MANUFACTURED IN ACCORDANCE WITH ASTM D-3034 SPECIFICATIONS AND TO A SDR (STRENGTH DIMENSION RATIO) OF 26 WITH ELASTOMERIC GASKETS. THE ELASTOMERIC GASKETS AND RETAINER RINGS SHALL BE INSTALLED BY THE MANUFACTURER IN ACCORDANCE WITH ASTM D-3212 AND F-477.

2. THE FITTINGS FOR SOLID WALL PVC PIPE SHALL BE THE SAME INSIDE DIAMETER AS THE SOLID WALL PVC WITH AN SDR OF 35.

3. PVC SEWER MAINS, SIZES 18 IN. THROUGH 27 IN. SHALL BE SOLID WALL PVC PIPE CONFORMING TO ASTM F-679.

4. THE MAXIMUM ALLOWABLE COMPRESSION FOR INSTALLED PVC SEWER PIPE IS 7.5 PERCENT (7.5%) OF ITS ORIGINAL VERTICAL INSIDE DIAMETER. PIPE EXCEEDING THIS ALLOWABLE COMPRESSION SHALL BE REMOVED AND REPLACED WITH NEW PIPE, REINSTALLED AT THE CONTRACTOR'S EXPENSE.

5. AT POINTS OF TIE-INS TO THE EXISTING SYSTEM, THE NEW PIPE MATERIAL SHOULD MATCH THE EXISTING. IF THE OLD MATCH IS NOT AVAILABLE, THE EXISTING MATERIAL, THE CONNECTION SHALL BE MADE WITH THE USE OF A COUPLING AND BUSHING ADAPTER INTENDED FOR THAT PURPOSE, ARC (MISSION RUBBER CO.), FERROCO, OR EQUAL, CONFORMING TO ASTM C-425.

6. DUCTILE IRON PIPE SHALL BE USED WHERE SPECIFIED ON THE CONSTRUCTION DRAWINGS AND SHALL CONFORM TO SECTION "DUCTILE IRON" OF THE S&WB 7260 WATER NOTES EXCEPT THAT THE INTERIOR LINING SHALL BE CERAMIC EPOXY, PROTECTO 401, OR APPROVED EQUAL, AND MUST BE FACTORY INSTALLED WITH 40 MILS NOMINAL THICKNESS.

III. SEWER MAIN INSTALLATION

1. THE SEWER MAIN MUST BE LAID IN A SEPARATE TRENCH FROM ALL OTHER UTILITIES. THE MINIMUM ALLOWABLE HORIZONTAL DISTANCE BETWEEN THE SEWER MAIN AND THE WATER MAIN SHALL BE 6 FT., AND A MINIMUM VERTICAL SEPARATION OF 18 IN. AS STIPULATED IN LOUISIANA ADMINISTRATIVE CODE TITLE FIFTY-ONE (51) PUBLIC HEALTH-SANITARY CODE PART XII WATER SUPPLIES. THE MINIMUM ALLOWABLE HORIZONTAL DISTANCE BETWEEN THE SEWER MAIN AND OTHER UTILITIES SHALL BE 3 FT., AND A MINIMUM VERTICAL CLEARANCE OF 12 IN. ABOVE OR 12 IN. BELOW OTHER UTILITIES. FOR PAYMENT PURPOSES, DEPTHS OF SEWER MAINS SHALL BE DETERMINED BY THE AVERAGE MEASUREMENTS FROM INVERTS TO THE TOP OF CASTINGS AT FINISHED GRADE OF CONNECTING MANHOLES. ALL DIMENSIONS BETWEEN UTILITIES SHALL BE MEASURED FROM OUTSIDE DIAMETER TO OUTSIDE DIAMETER.

2. SEWER MAINS AND INTERCONNECTING MANHOLES SHALL BE INSTALLED AT ELEVATIONS INDICATED ON THE PLANS UNLESS CHANGED BY THE S&WB ENGINEER. ALL MAINS MUST BE LAID CONTINUOUSLY FROM MANHOLE TO MANHOLE, LAID FROM THE LOW END OF THE SYSTEM WITH THE BELT FACING UPSTREAM, AND MUST BE OF THE SAME SIZE PIPE DIAMETER. THE MINIMUM DEPTH OF A SEWER MAIN SHALL BE 5.5 FT. FROM SURFACE TO INVERT.

3. INSTALLATION OF THE SOLID WALL PVC PIPE SHALL CONFORM TO SECTION D, "THE CONSTRUCTION OF SEWERS," OF THE GENERAL SPECIFICATIONS OF THE S&WB. THE TRENCH BOTTOM SHALL BE SMOOTH AND FREE FROM ROCKS, ROOTS, ETC. AFTER THE SHEETING AND/OR FOUNDATION LUMBER IS PLACED, THE PIPE SHALL BE LAID ON A SMOOTH BED OF APPROVED BEDDING MATERIAL. BEDDING AND FOUNDATIONS FOR MAINS AND STANDARD SHEETING AND BRACING SHALL COMPLY WITH S&WB DWG. NO. 4697-ESA. THE BEDDING MATERIAL SHALL BE EXTENDED UNDER, AROUND, AND OVER THE TOP OF THE PIPE AND COMPACTED IN LAYERS NOT GREATER THAN 6 IN. BY A MECHANICAL VIBRATING COMPACTOR APPROVED BY THE S&WB ENGINEER UNTIL A MINIMUM OF 95% STANDARD PROCTOR DENSITY IS ATTAINED AT OR NEAR OPTIMUM MOISTURE CONTENT FOR THE FULL WIDTH OF THE TRENCH. THE BEDDING MATERIAL SHALL BE CLASS I ANGULAR MATERIAL (1/4 IN. TO 1-1/2 IN.), ASTM D2321 OR ASTM C33. THE S&WB ENGINEER RESERVES THE RIGHT TO APPROVE THE TYPE OF BEDDING MATERIAL TO BE USED.

4. FILTER FABRIC SHALL BE INSTALLED AROUND THE BEDDING AND UNDER THE BACKFILL. IN ALL SEWER INSTALLATIONS AS SHOWN IN S&WB DWG. NO. 4697-ESA, AND CONFORM BY WEIGHT TO ASTM D1910. THE FILTER FABRIC SHALL BE DOTD CLASS C OR D, NON-WOVEN PERMIUM SHEETS OF PLASTIC YARN MIRAFI 170N, OR AN EQUAL APPROVED BY THE S&WB ENGINEER, CONSTRUCTED SO THE YARNS WILL RETAIN THEIR RELATIVE POSITION WITH RESPECT TO EACH OTHER. EDGES OF THE FABRIC SHALL BE FINISHED TO PREVENT THE OUTER YARN FROM PULLING AWAY FROM THE FABRIC. THE FABRIC SHALL BE INSTALLED AS FOLLOWS:

A. AFTER THE TRENCH IS EXCAVATED, THE FOUNDATION LUMBER SHALL BE PLACED IN THE BOTTOM OF THE TRENCH AS SHOWN ON THE STANDARD DRAWINGS. THE FILTER FABRIC SHALL BE CUT TO THE NEEDED WIDTH, INCLUDING ALLOWANCES FOR "LOOSE" PLACEMENT IN THE TRENCH, WITH A DOUBLE OVERLAP ON TOP OF THE BEDDING MATERIAL AFTER PLACEMENT. THE FABRIC SHALL BE LAID OVER THE FOUNDATION LUMBER IN THE TRENCH ALONG THE PIPES ALIGNMENT WITH AN 18 IN. MINIMUM OVERLAP AT THE ENDS OF SUBSEQUENT LENGTHS. CARE SHOULD BE TAKEN TO PLACE THE FABRIC TIGHTLY AGAINST THE SOIL SO THAT NO VOIDS OCCUR OUTSIDE THE FABRIC. WRINKLES OR FOLDS SHOULD BE AVOIDED. THE SIDES OF THE FABRIC WHICH WILL BE USED AS A DOUBLE-TOP OVERLAP SHOULD TEMPORARILY BE PINNED TO THE SIDES OF THE TRENCH.

B. AFTER INSTALLING THE FABRIC, AN INITIAL 6 IN. LAYER OF BEDDING MATERIAL SHALL BE PLACED AND COMPACTED TO THE PROPER GRADE BEFORE PLACING THE SEWER PIPE. THE REMAINDER OF THE BEDDING MATERIAL SHALL THEN BE PLACED AROUND AND ABOVE THE PIPE AND COMPACTED. COMPACTION IS REQUIRED TO SEAT THE FABRIC AND BEDDING MATERIAL AGAINST THE TRENCH WALL AND TO REDUCE SETTLEMENT.

C. AFTER COMPACTION, THE TWO EDGES OF THE FILTER FABRIC SHALL BE UNFASTENED AND OVERLAPPED FOR THE FULL WIDTH OF THE TRENCH ON TOP OF THE BEDDING MATERIAL. THE BACKFILL MATERIAL SHALL THEN BE PLACED ON TOP OF THE FILTER FABRIC AND COMPACTED.

IV. MANHOLES

1. MANHOLES SHALL CONFORM TO SECTION D OF THE GENERAL SPECIFICATIONS AND S&WB DWG. NOS. D-870. SHORT SECTIONS OF PIPE WITH BELL FITTINGS AND WATER STOPS, AS RECOMMENDED BY THE MANUFACTURER AND AS SHOWN ON S&WB DWG. NO. 1178-SD, SHALL BE USED AS CONNECTORS FOR BRICK MANHOLES. AS AN ALTERNATIVE, A SAND IMPREGNATED PVC STUB, APPROVED BY THE S&WB ENGINEER, MAY BE USED AND GROUTED IN PLACE USING A TYPE THREE HIGH EARLY STRENGTH CEMENT, OR QUICK SETTING EMBOCO, OR SIMILAR MATERIAL APPROVED BY THE S&WB ENGINEER. KOR-N-SEAL BOOTS, OR APPROVED EQUAL AS SHOWN ON S&WB DWG. NO. 8178-SD, SHALL BE USED FOR PRECAST MANHOLE PIPE CONNECTIONS.

2. MANHOLE STEPS SHALL CONFORM TO S&WB DWG. NO. D-1359.

3. ABANDONED SEWER MAINS MUST BE PLUGGED IN THE MANHOLE. WALLS OF ABANDONED MANHOLES SHALL BE REMOVED TO A MINIMUM OF 2 FT. BELOW FINISHED GRADE AND THE ABANDONED MANHOLES MUST BE FILLED WITH SAND AND FLOODED. CASTINGS AND COVERS ARE TO BE REMOVED AND RETURNED TO THE S&WB CENTRAL YARD, 2900 PEOPLES AVE N.O. LA 70122.

4. ALL MANHOLE FOUNDATION SLABS SHALL BE PLACED ON A 6 IN. LAYER OF CRUSHED STONE OR APPROVED EQUAL BEDDING MATERIAL IN ACCORDANCE WITH S&WB DWG. NO. D-870.

V. HOUSE CONNECTIONS

1. HOUSE CONNECTIONS SHALL BE INSTALLED USING 6 IN. SOLID WALL SDR 26 PVC PIPE EXTENDED TO THE PROPERTY LINE AS SHOWN ON S&WB DWG. NO. 6312-ES. THE USE OF SADDLES WILL NOT BE PERMITTED; ALL SUCH CONNECTIONS SHALL BE MADE WITH THE USE OF APPROVED FITTINGS. ALL PIPE AND FITTINGS SHALL BE THE SAME MATERIAL AS THE SEWER MAIN UNLESS OTHERWISE APPROVED BY THE S&WB ENGINEER. HOUSE CONNECTIONS SHALL BE MADE WITH A MINIMUM OF 3.5 FT. OF COVER, MEASURED FROM THE GUTTER LINE AND FROM THE GROUND SURFACE AT THE PROPERTY LINE. THE HOUSE CONNECTION SHALL END AT THE PROPERTY LINE OR EXTEND THROUGH ANY PROPOSED SERVITUDES ADJACENT TO THE PROPERTY LINE WITH A RUBBER GASKETED PLASTIC CAP. HOUSE CONNECTIONS SHALL NOT REQUIRE BRACING, FOUNDATION LUMBER, OR BEDDING. THE LOCATION OF ALL SEWER HOUSE CONNECTIONS SHALL BE IMPRINTED ON THE CURB WITH AN "S", 3 IN. HIGH AND 3/4 IN. DEEP AS SHOWN ON S&WB DWG. NO. 6312-ES.

VI. TESTING AND INSPECTION

1. ALL INSTALLATION OF SEWER MAINS AND RELATED APPURTENANCES WILL BE PERFORMED UNDER THE INSPECTION OF, AND TO THE SATISFACTION OF, THE S&WB INSPECTOR THROUGHOUT THE COURSE OF THE WORK.

2. INFILTRATION RATE FOR NEWLY INSTALLED GRAVITY MAINS SHALL BE ZERO GALLONS. INFILTRATION TEST RATES FOR FORCE MAINS SHALL NOT EXCEED A RATE OF 250 GALLONS PER IN. OF DIAMETER PER MILE, PER 24 HOURS, SHALL BE CONDUCTED BY THE CONTRACTOR AND OBSERVED BY THE S&WB. THIS TEST SHALL BE PERFORMED ONLY AFTER THE BACKFILLED TRENCH HAS REMAINED FLOODED FOR AT LEAST 12 HOURS PRIOR TO THE TEST. THE TRENCH SHALL REMAIN FLOODED DURING THE TEST. THE CONTRACTOR SHALL FURNISH ALL MATERIAL, LABOR AND EQUIPMENT NECESSARY FOR THIS TEST. IF AN INFILTRATION TEST IS NOT PERFORMED PRIOR TO PAVING, AN INFILTRATION TEST WILL BE PERFORMED BY THE S&WB ENGINEER. ANY DETECTABLE LEAK SHALL BE REPAIRED BY THE CONTRACTOR AT THE CONTRACTOR'S EXPENSE. THE INFILTRATION TEST IS TO BE PERFORMED BY THE CONTRACTOR AND SHALL BE WITNESSED BY THE S&WB INSPECTOR.

3. AT THE COMPLETION OF BACKFILLING, AND PRIOR TO FINAL ACCEPTANCE OF THE SEWER, 100% OF THE SEWER MAIN MUST BE MANDRELED. THIS MANDREL WORK SHALL BE WITNESSED BY THE S&WB INSPECTOR AND PERFORMED BY THE CONTRACTOR AT NO DIRECT PAY. THE S&WB WILL PROVIDE THE MANDRELS FOR ALL TESTS AND THE CONTRACTOR SHALL PLACE THE PULL LINES IN THE MAINS. THE CONTRACTOR WILL HAVE THE OPTION OF PASSING THE MANDRELS AT ANY TIME AFTER FINAL BACKFILL OF THE TRENCHES BUT PRIOR TO FINAL ACCEPTANCE. IT IS REQUIRED THAT A S&WB REPRESENTATIVE AND THE CONTRACTOR WITNESS THE ACTUAL MANDRELING TEST(S).

4. THE SEWER LINE WILL BE CLEANED AND VIDEOED PRIOR TO THE INSTALLATION OF THE WEARING COURSE. IT IS REQUIRED THAT AN S&WB REPRESENTATIVE AND THE CONTRACTOR PHYSICALLY EYE-WITNESS THE ACTUAL CLEANING AND TV/VIDEO TEST(S).

5. THE CONTRACTOR WILL BE REQUIRED TO REPAIR, AT HIS OWN EXPENSE AND IN AN APPROVED MANNER, ALL DEFECTS IN WORKMANSHIP OR MATERIAL DISCLOSED BY THESE INSPECTIONS PRIOR TO OBTAINING FINAL ACCEPTANCE. THE CONTRACTOR SHALL ALSO BEAR ALL COST ASSOCIATED WITH THE RE-TESTING, INCLUDING ANY COST INCURRED BY THE S&WB.

VII. FINAL ACCEPTANCE

1. BEFORE FINAL INSPECTION OF THE SYSTEM, THE CONTRACTOR SHALL SUBMIT AN "AS-BUILT" DRAWING TO THE BOARD SHOWING ANY CHANGES IN LINE OR GRADE FROM THE ORIGINAL DRAWINGS, AS WELL AS SHOWING THE LOCATION OF ALL HOUSE CONNECTIONS, IN ACCORDANCE WITH S&WB REQUIREMENTS. IF WILL THE CONTRACTOR'S RESPONSIBILITY TO CERTIFY THAT THE "AS-BUILT" DRAWINGS ARE CORRECT, ANY INACCURACY AS DETERMINED BY THE S&WB IN THE "AS-BUILT" DRAWINGS SHALL BE CORRECTED AT THE COST OF THE CONTRACTOR.

2. THE CONTRACTOR MUST CONTACT THE S&WB TO SET A DATE FOR FINAL INSPECTION. IN THE EVENT THE CONTRACTOR CALLS FOR AN INSPECTION AND THE WORK IS NOT ADEQUATELY COMPLETE, A NEW INSPECTION DATE WILL THEN BE SET AT THE DISCRETION OF THE S&WB INSPECTOR.

3. FINAL ACCEPTANCE OF THE SYSTEM WILL BE SUBJECT TO A 1-YEAR MAINTENANCE PERIOD FOLLOWING FINAL ACCEPTANCE OF THE PROJECT BY THE S&WB.

CIVIL

REV.	DATE	DESCRIPTION	BY

SEWERAGE AND WATER BOARD OF NEW ORLEANS

CONTRACT 3667
HURRICANE KATRINA RELATED
404 HAZARD MITIGATION GRANT PROGRAM
REPLACEMENT OF VICTORIA SEWAGE PUMPING STATION


SEWER NOTES

DR. TH/BD	
TRC. ---	
CK. DS/CW	GENERAL SUPERINTENDENT
AP. JH	DWG. No. 12039-W-63
SCALE: NONE	
DATE: JANUARY 2012	SET NO. SHEET NO. 7



PRINTED May 31, 2013 - 9:05am FILENAME - J:\6005.1-COSHEP-2013\Contract 3668 - Victoria SPS\SHT 7_VIC_Sew Dr Wat Notes.dwg

PRINTED Sep 27, 2013 - 8:48am FILENAME - j:\6005.1-(CONFORMED DRAWINGS)\Contract 3668 - Victoria SFS\ARCHITECTURAL\SH1_8_VIC_ARCH_FRAME.dwg

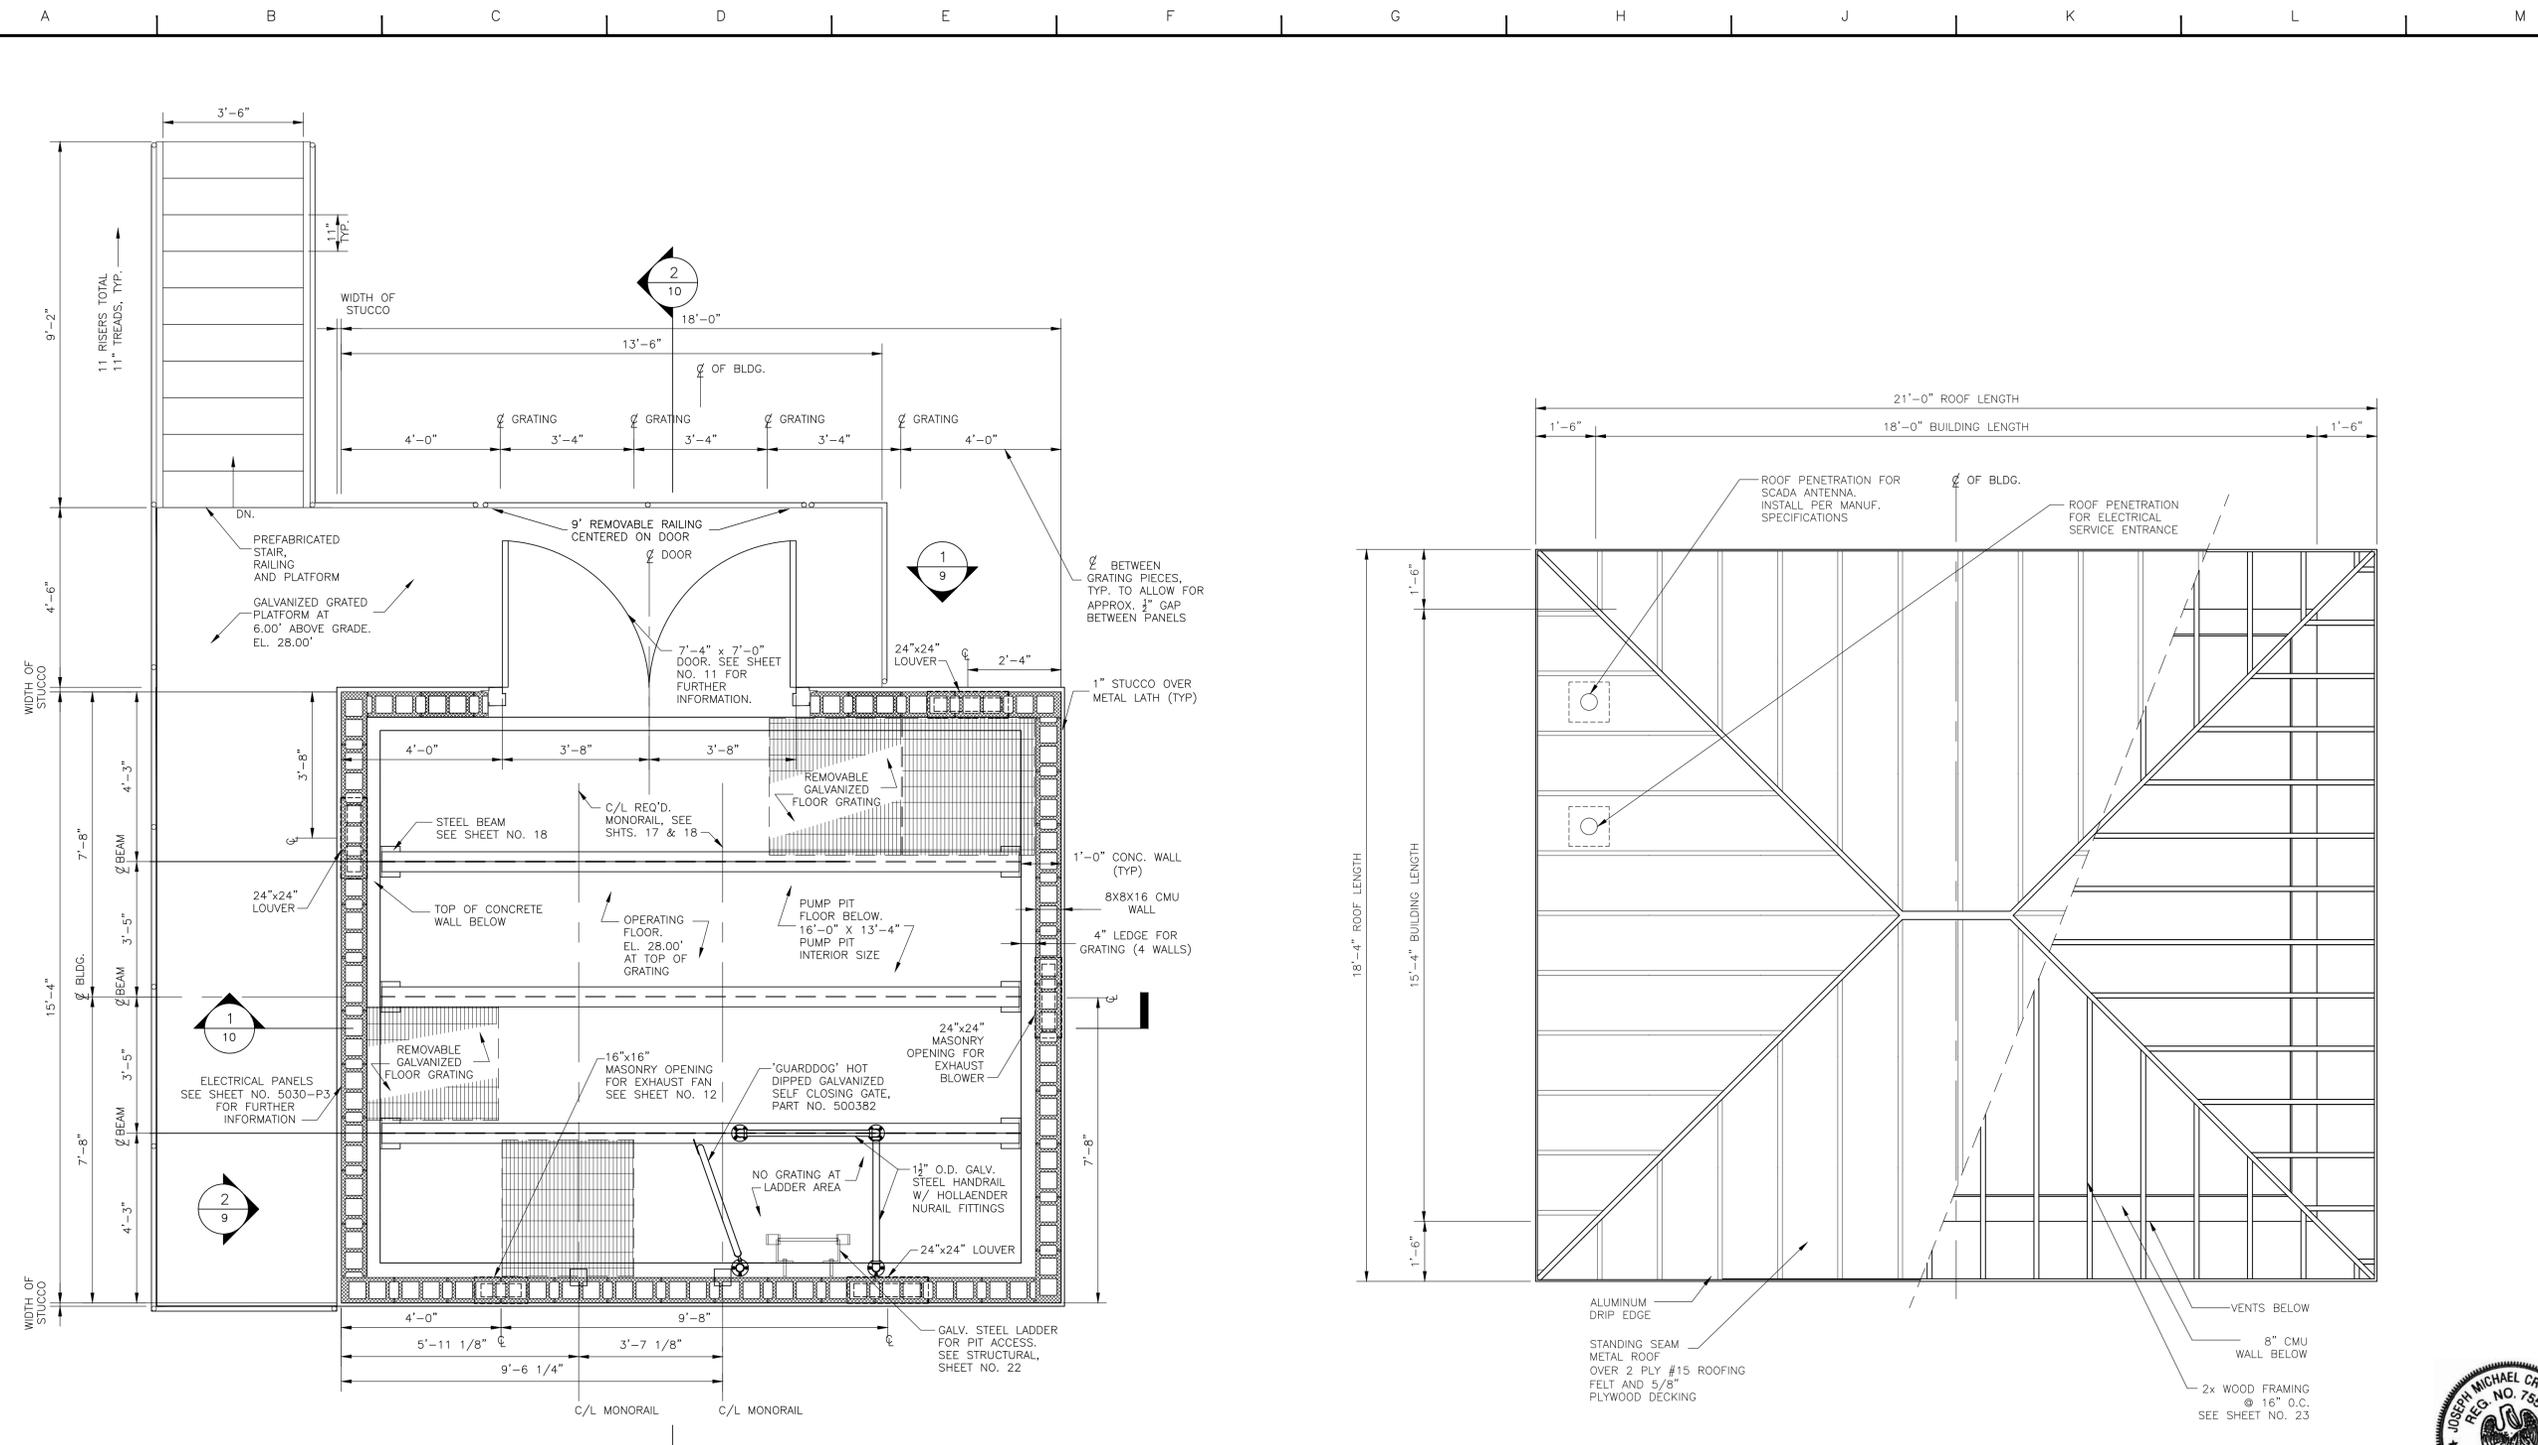

1 OPERATING FLOOR / ARCHITECTURAL FRAMING PLAN
1/2" = 1'-0"

2 COMBINED ROOF AND FRAMING PLAN
1/2" = 1'-0"




ARCHITECTURAL **Perez.**

REV.	DATE	DESCRIPTION	BY
SEWERAGE AND WATER BOARD OF NEW ORLEANS			
CONTRACT 3668 HURRICANE KATRINA RELATED 404 HAZARD MITIGATION GRANT PROGRAM REPLACEMENT OF VICTORIA SEWAGE PUMPING STATION			
FLOOR FRAMING AND ROOF PLANS			
DR. JW			
TRC. ---			
CK. DW			GENERAL SUPERINTENDENT
AP. DW			
SCALE: AS NOTED		DWG. No. 12039-W-63	
DATE: SEPTEMBER 2013	SET NO.		SHEET NO. 8

DESIGN ENGINEERING INC.
3330 West Esplanade Ave. S.
Suite 205
Metairie, LA 70002
(504) 836-2155

PRINTED May 30, 2013 - 3:03pm FILENAME - J:\6005.1-GOSHEP-2013\Contract 3668 - Victoria SPS_ARCHITECTURAL\SH_T 9_VIC_BLDG_ELEV.dwg

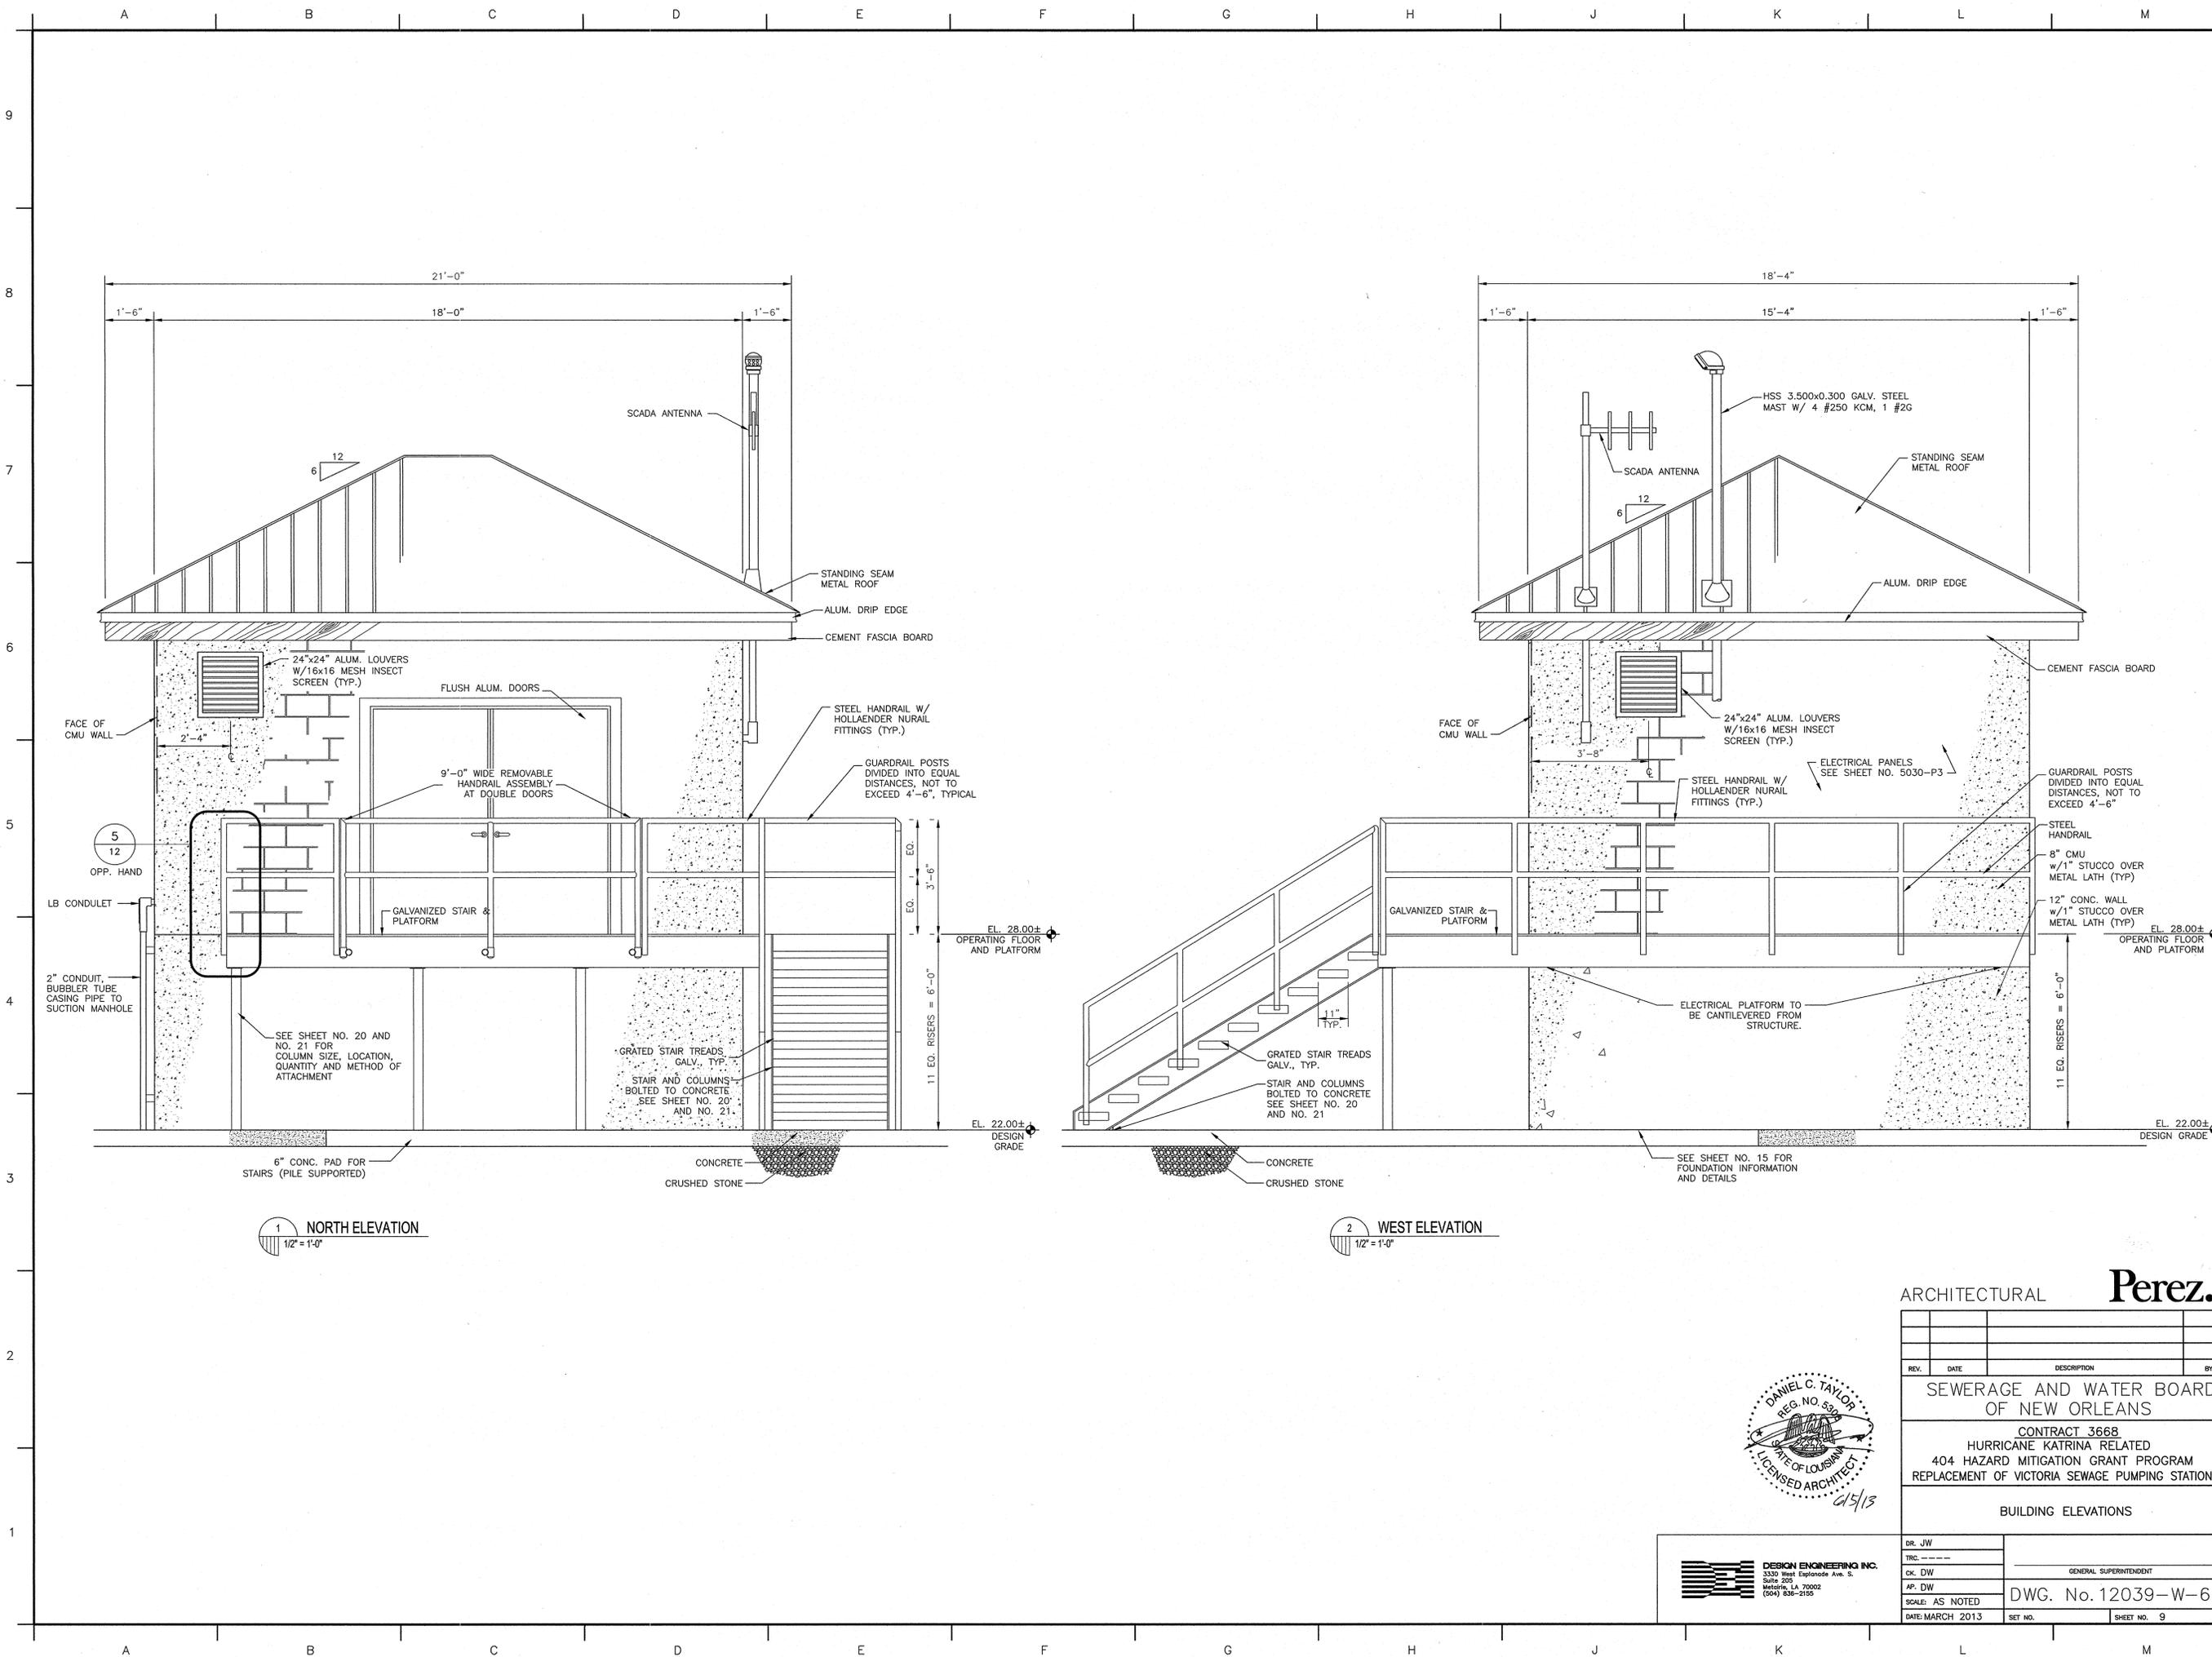

ARCHITECTURAL **Perez.**

SEWERAGE AND WATER BOARD
OF NEW ORLEANS
CONTRACT 3668
HURRICANE KATRINA RELATED
404 HAZARD MITIGATION GRANT PROGRAM
REPLACEMENT OF VICTORIA SEWAGE PUMPING STATION


BUILDING ELEVATIONS




DESIGN ENGINEERING INC.
3330 West Esplanade Ave. S.
Suite 205
Metairie, LA 70002
(504) 886-2155

DR. JW	GENERAL SUPERINTENDENT
TRC. ---	
CK. DW	
AP. DW	
SCALE: AS NOTED	DWG. No. 12039-W-63
DATE: MARCH 2013	SHEET NO. 9

PRINTED May 30, 2013 - 3:04pm FILENAME - J:\6005.1-GOSHEP-2013\Contract 3668 - Victoria SPS\ARCHITECTURAL\SH10_VIC_BLDG_SEC.dwg

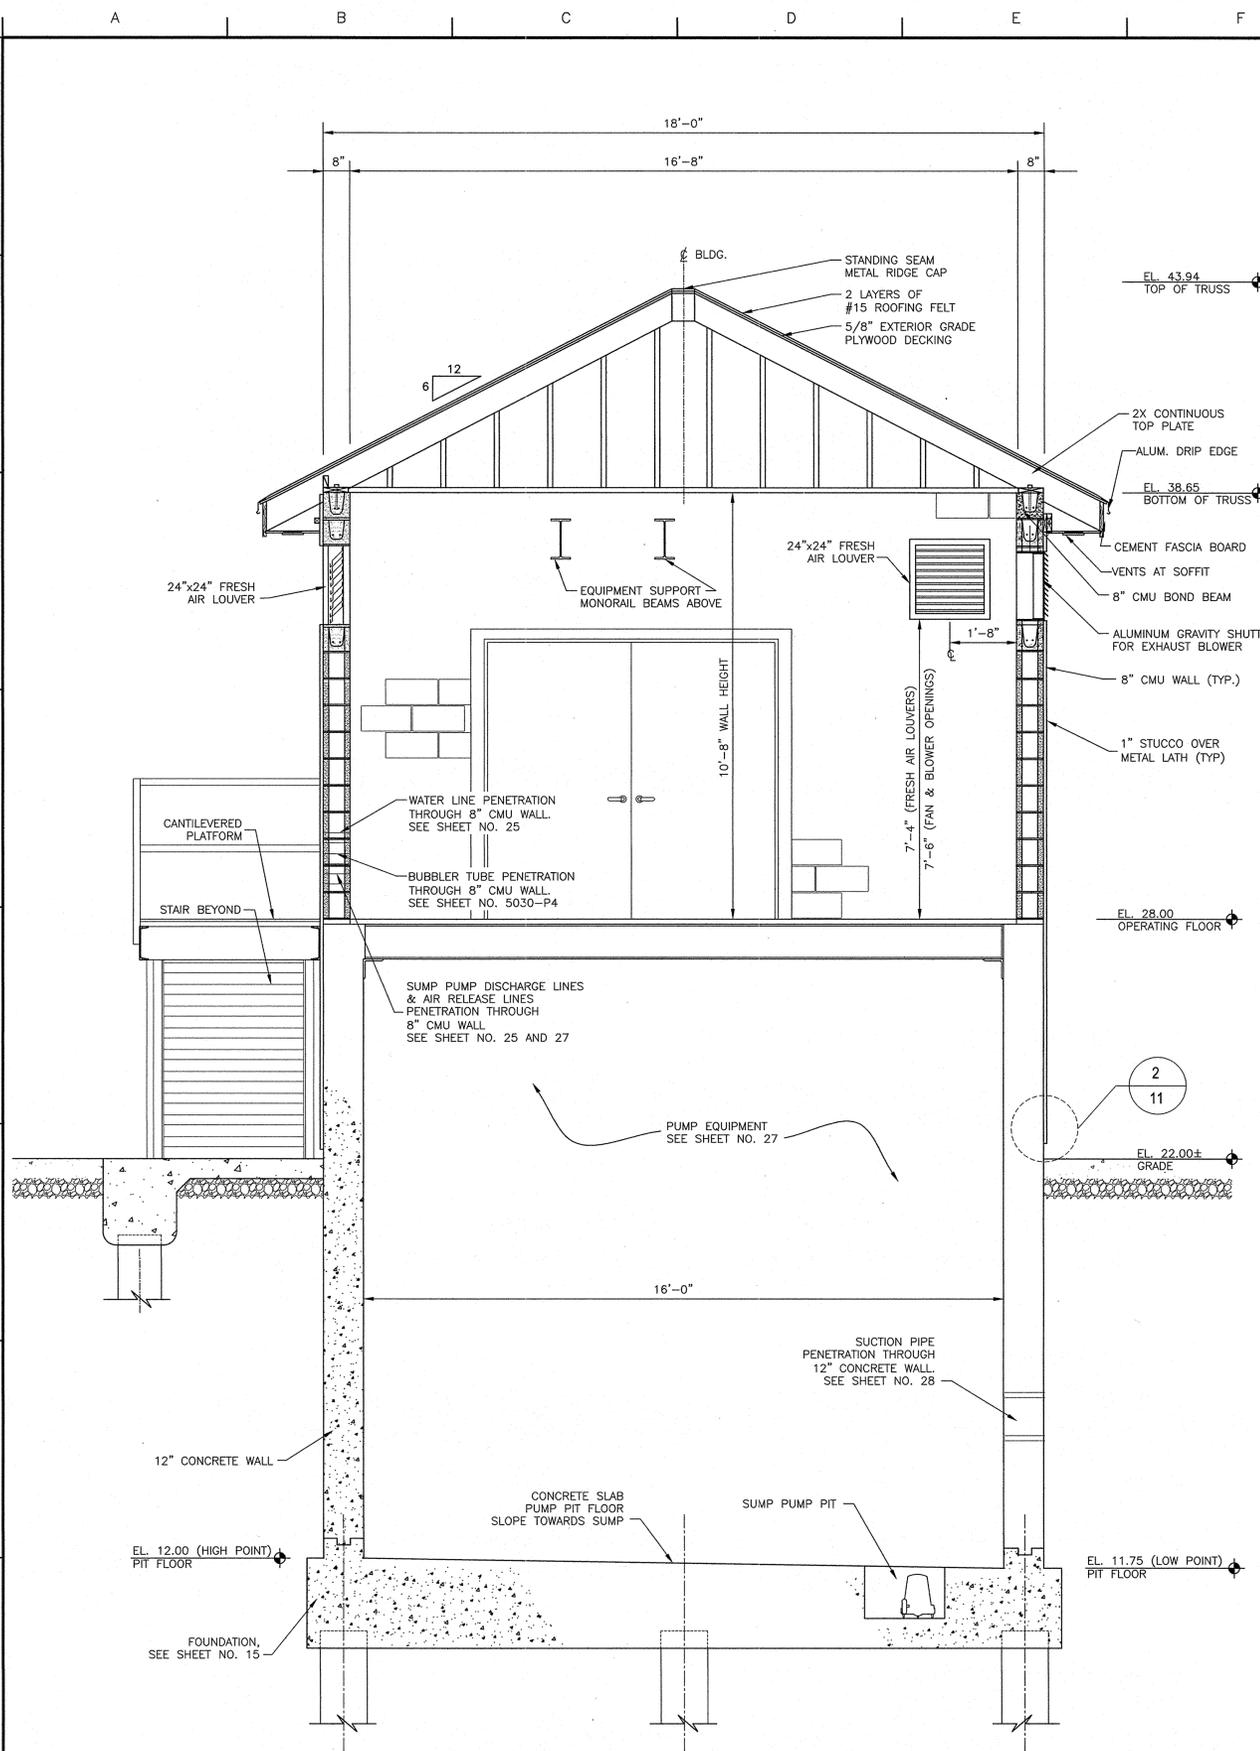

1 LONGITUDINAL SECTION OF BUILDING
1/2" = 1'-0"

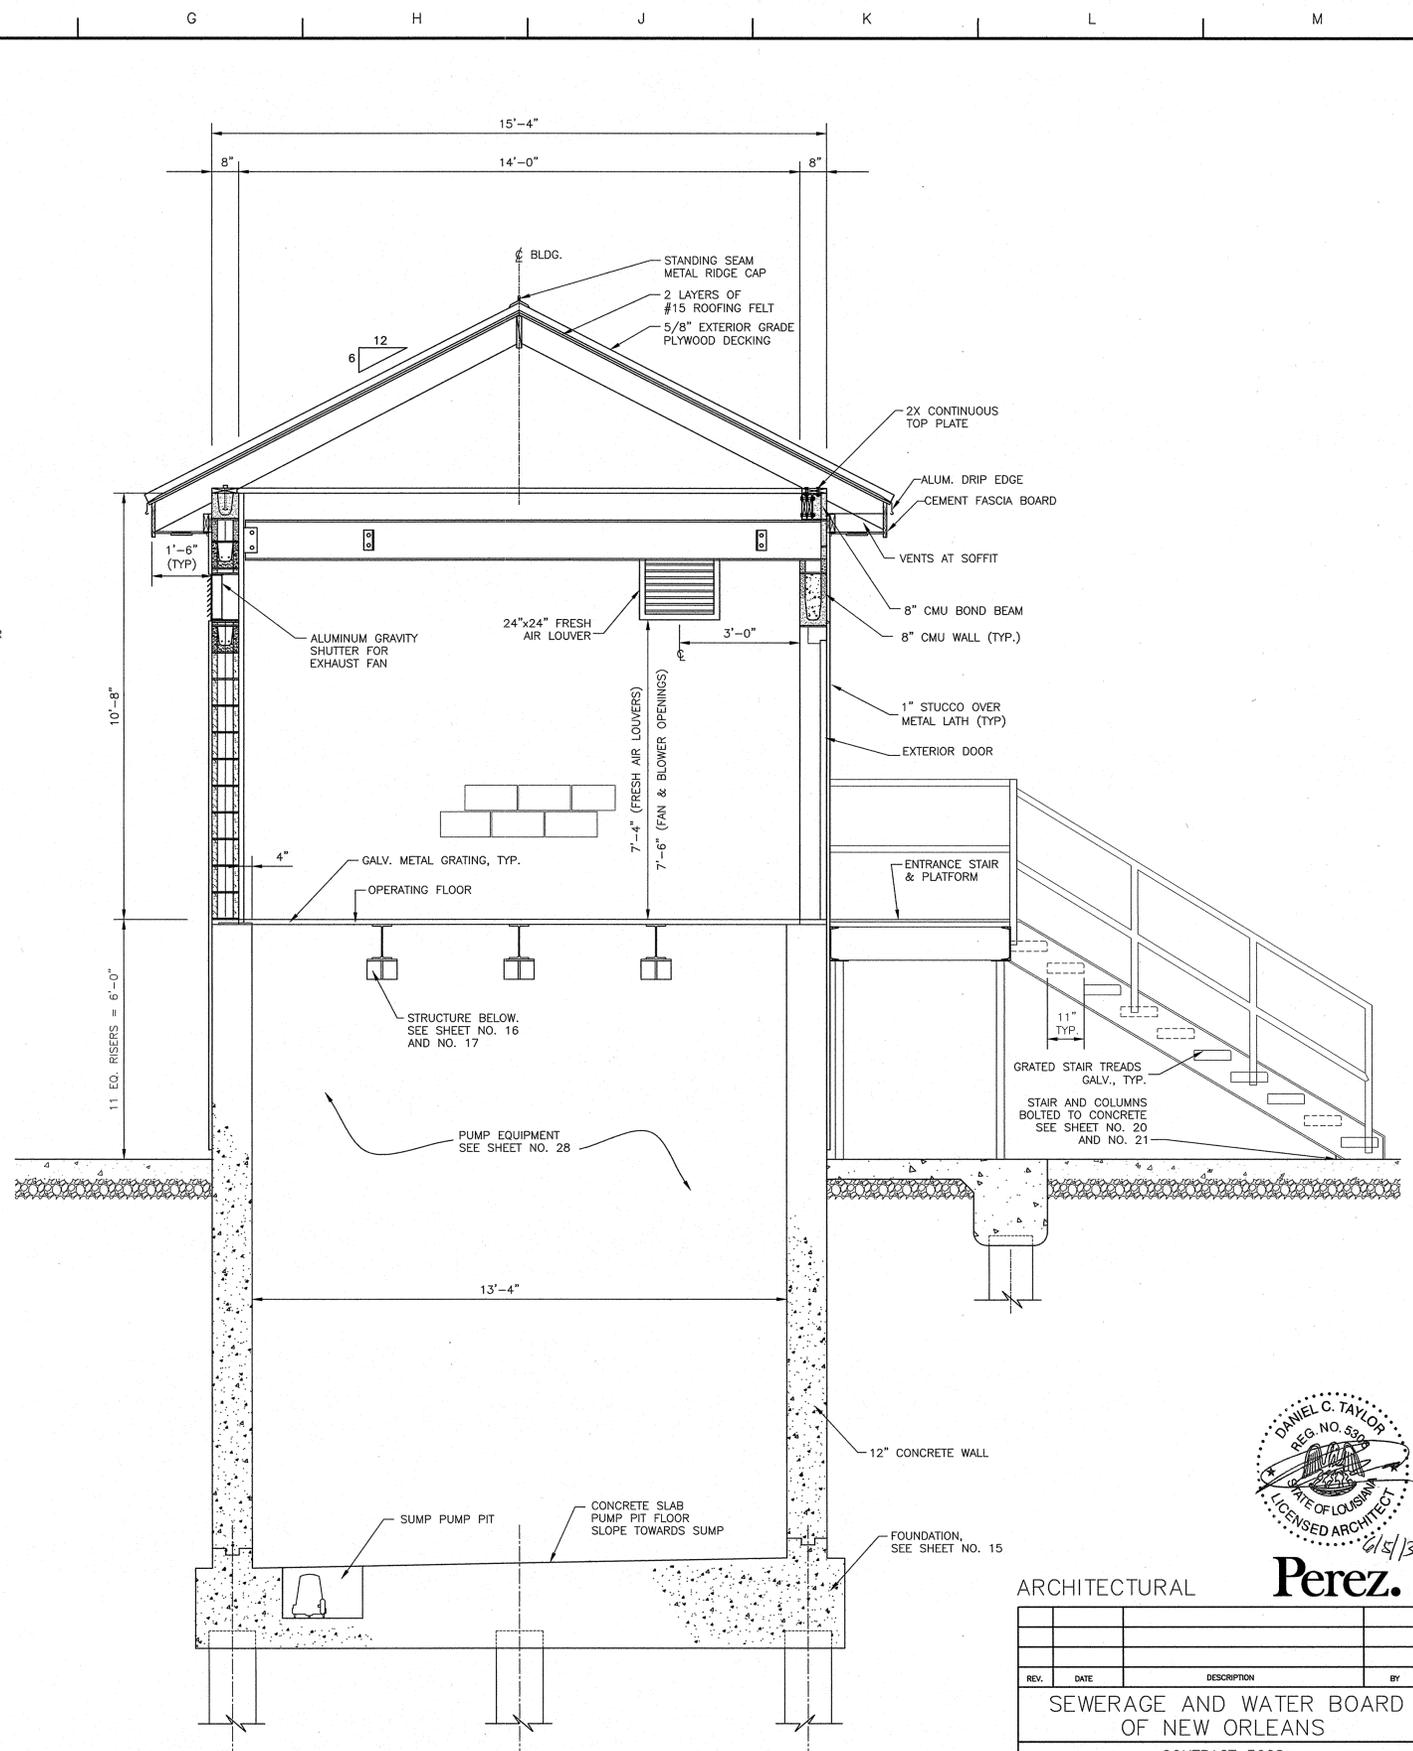

2 CROSS SECTION OF BUILDING
1/2" = 1'-0"



Perez.

ARCHITECTURAL


REV.	DATE	DESCRIPTION	BY
SEWERAGE AND WATER BOARD OF NEW ORLEANS			
CONTRACT 3668 HURRICANE KATRINA RELATED 404 HAZARD MITIGATION GRANT PROGRAM REPLACEMENT OF VICTORIA SEWAGE PUMPING STATION			
BUILDING SECTIONS			

DR. JW	GENERAL SUPERINTENDENT
TRC. ---	
CK. DW	
AP. DW	
SCALE: AS NOTED	DWG. No. 12039-W-63
DATE: MARCH 2013	SHEET NO. 10




A B C D E F G H J K L M


9
8
7
6
5
4
3
2
1

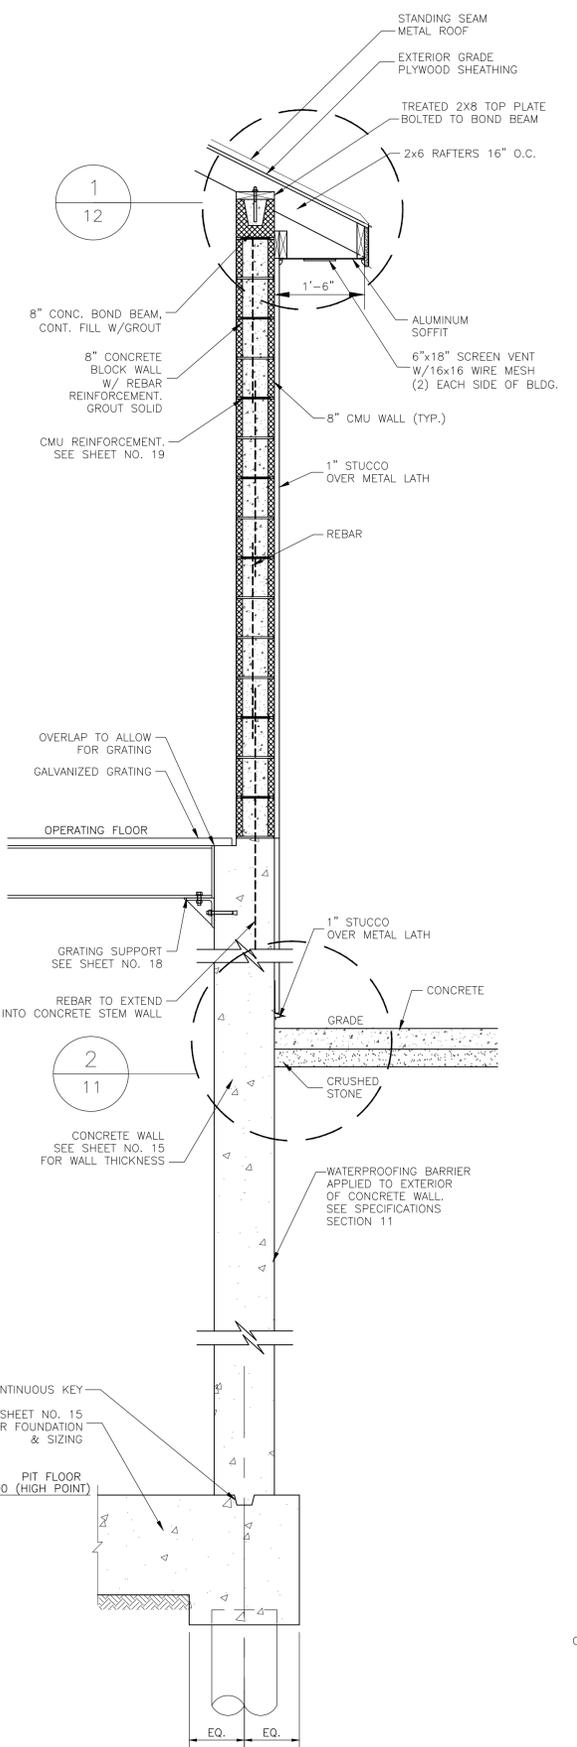


1 TYPICAL ROOF AND WALL DETAIL
1/4" = 1'

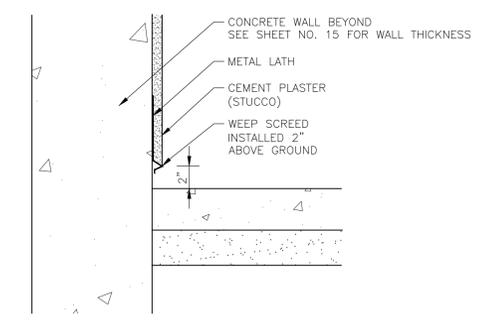


2 STUCCO BASE DETAIL
1 1/2" = 1'

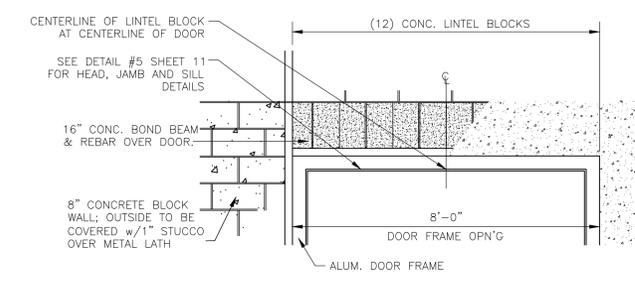


3 DOOR FRAME AND LINTEL DETAIL
1/2" = 1'

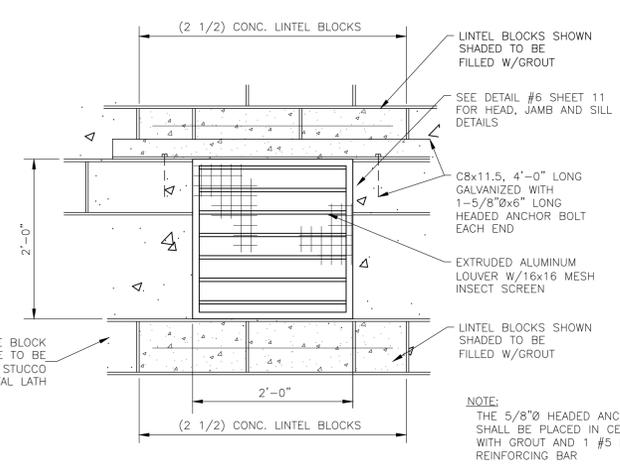


4 ENLARGED LOUVER ELEVATION
1" = 1'

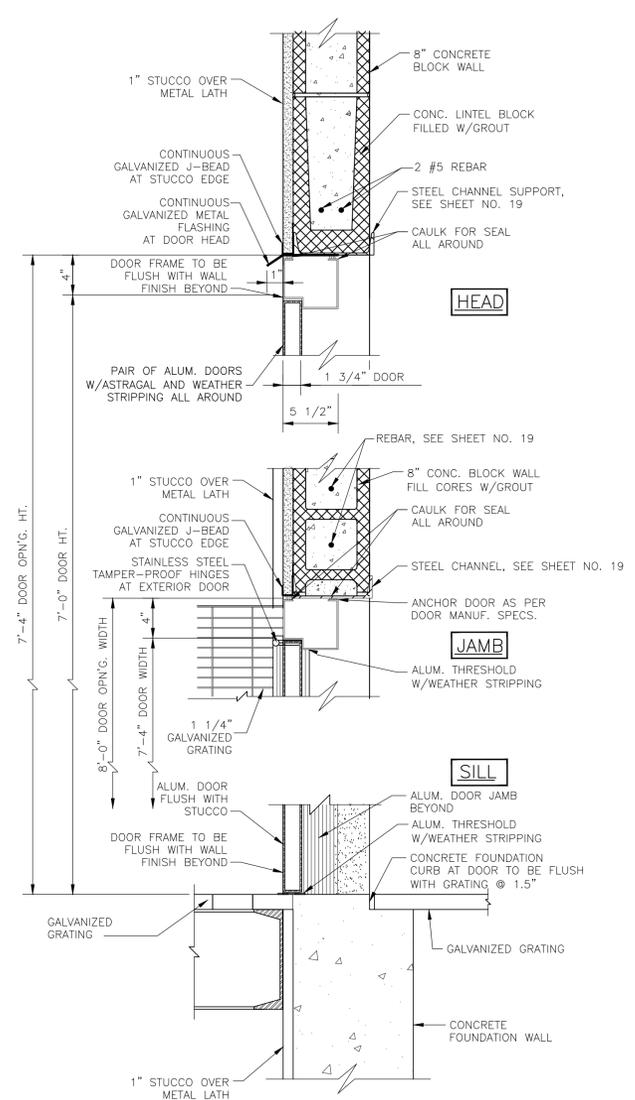

5 TYPICAL DOOR FRAME DETAIL
1 1/2" = 1'

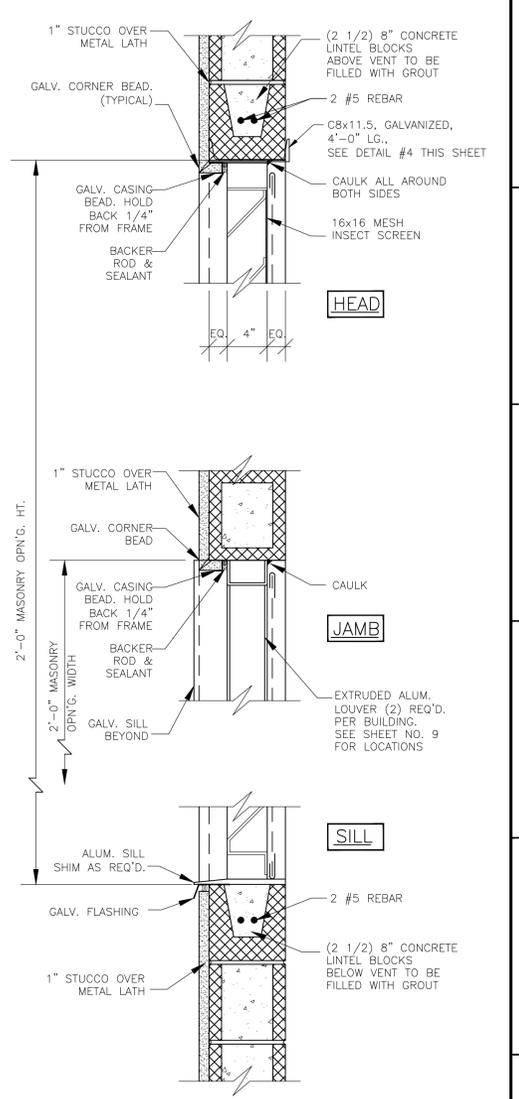

6 LOUVER DETAIL
1 1/2" = 1'

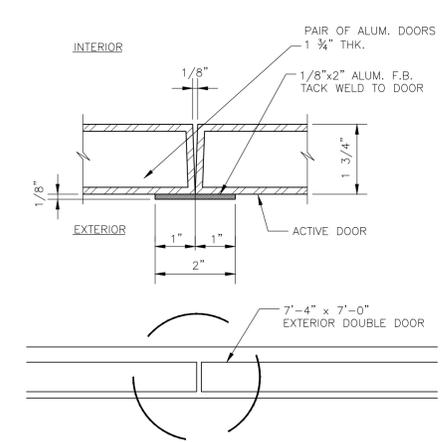

7 ASTRAGAL DETAIL
6" = 1'



Perez.


ARCHITECTURAL

REV.	DATE	DESCRIPTION	BY
SEWERAGE AND WATER BOARD OF NEW ORLEANS			
CONTRACT 3668 HURRICANE KATRINA RELATED 404 HAZARD MITIGATION GRANT PROGRAM REPLACEMENT OF VICTORIA SEWAGE PUMPING STATION			
ARCHITECTURAL DETAILS			
DR. JW			
TRC. ---			GENERAL SUPERINTENDENT
CK. DW			
AP. DW			
SCALE: AS NOTED		DWG. No. 12039-W-63	
DATE: SEPTEMBER 2013	SET NO.		SHEET NO. 11


DESIGN ENGINEERING INC.
3330 West Esplanade Ave. S.
Suite 205
Metairie, LA 70002
(504) 836-2155

A B C D E F G H J K L M


9
8
7
6
5
4
3
2
1

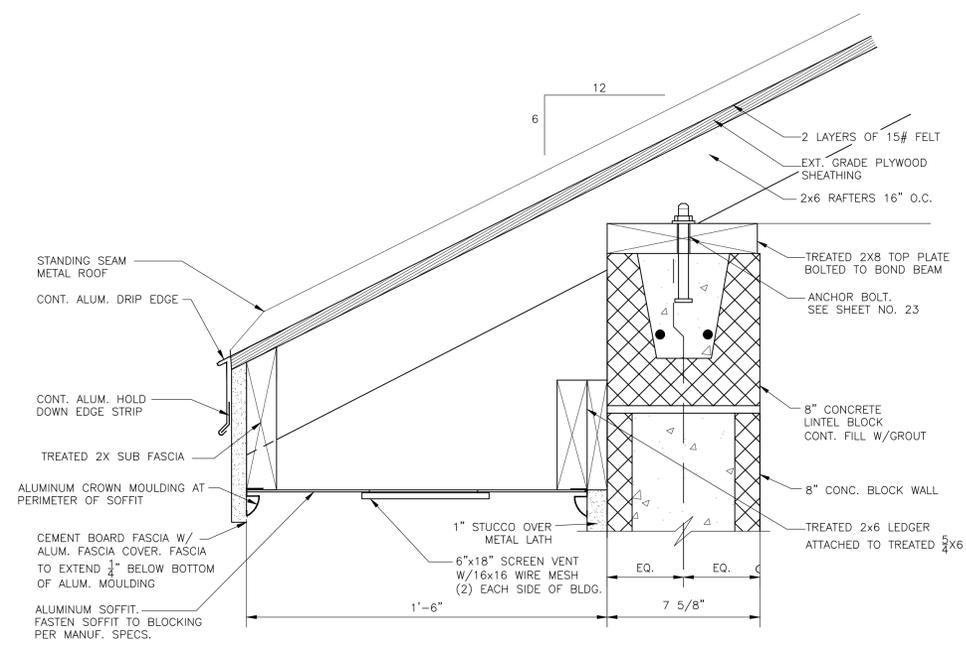

1 STANDING SEAM METAL ROOF SOFFIT DETAIL
3" = 1'

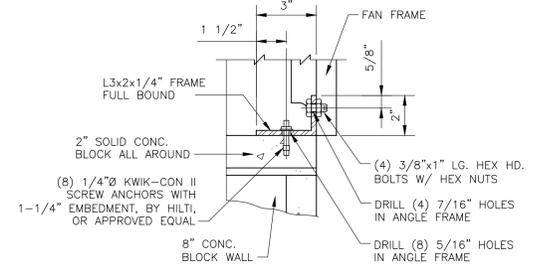


2 FAN CONNECTION DETAIL
3" = 1'

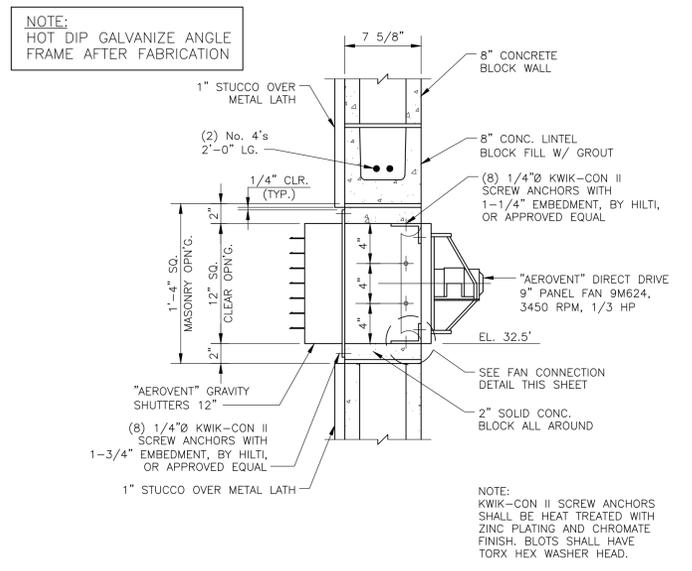

NOTE:
HOT DIP GALVANIZE ANGLE
FRAME AFTER FABRICATION


3 EXHAUST FAN AND SHUTTER DETAIL
1 1/2" = 1'

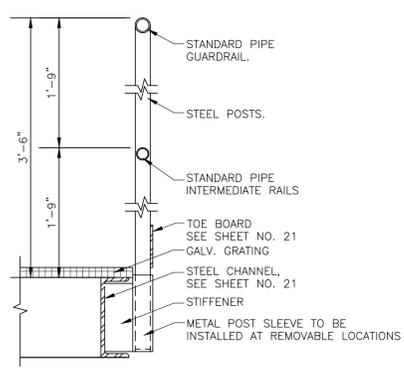

NOTE: SEE STRUCTURAL DETAILS, SHEET 21, FOR MORE INFORMATION

5 TYPICAL GUARDRAIL DETAIL
1 1/2" = 1'

NOTE:
KWIK-CON II SCREW ANCHORS
SHALL BE HEAT TREATED WITH
ZINC PLATING AND CHROMATE
FINISH. BLOTS SHALL HAVE
TORX HEX WASHER HEAD.

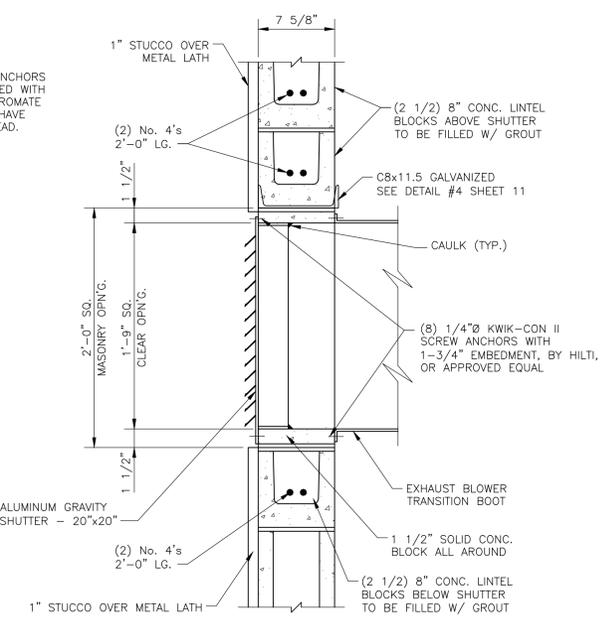

6 EXHAUST BLOWER AND SHUTTER DETAIL
1 1/2" = 1'

4 NOT USED



Perez.



ARCHITECTURAL

REV.	DATE	DESCRIPTION	BY
SEWERAGE AND WATER BOARD OF NEW ORLEANS			
CONTRACT 3668 HURRICANE KATRINA RELATED 404 HAZARD MITIGATION GRANT PROGRAM REPLACEMENT OF VICTORIA SEWAGE PUMPING STATION			
ARCHITECTURAL DETAILS			
DR. JW			
TRC. ---			
CK. DW			GENERAL SUPERINTENDENT
AP. DW			
SCALE: AS NOTED			DWG. No. 12039-W-63
DATE: SEPTEMBER 2013	SET NO.		SHEET NO. 12

DESIGN ENGINEERING INC.
3330 West Esplanade Ave. 5,
Suite 205
Metairie, LA 70002
(504) 836-2155

A B C D E F G H J K L M

PRINTED May 31, 2013 9:06am FILENAME -- U:\6005.1-COSHEP-2013\Contract 3668 - Victoria SPS\SH13_VIC_BORING.dwg

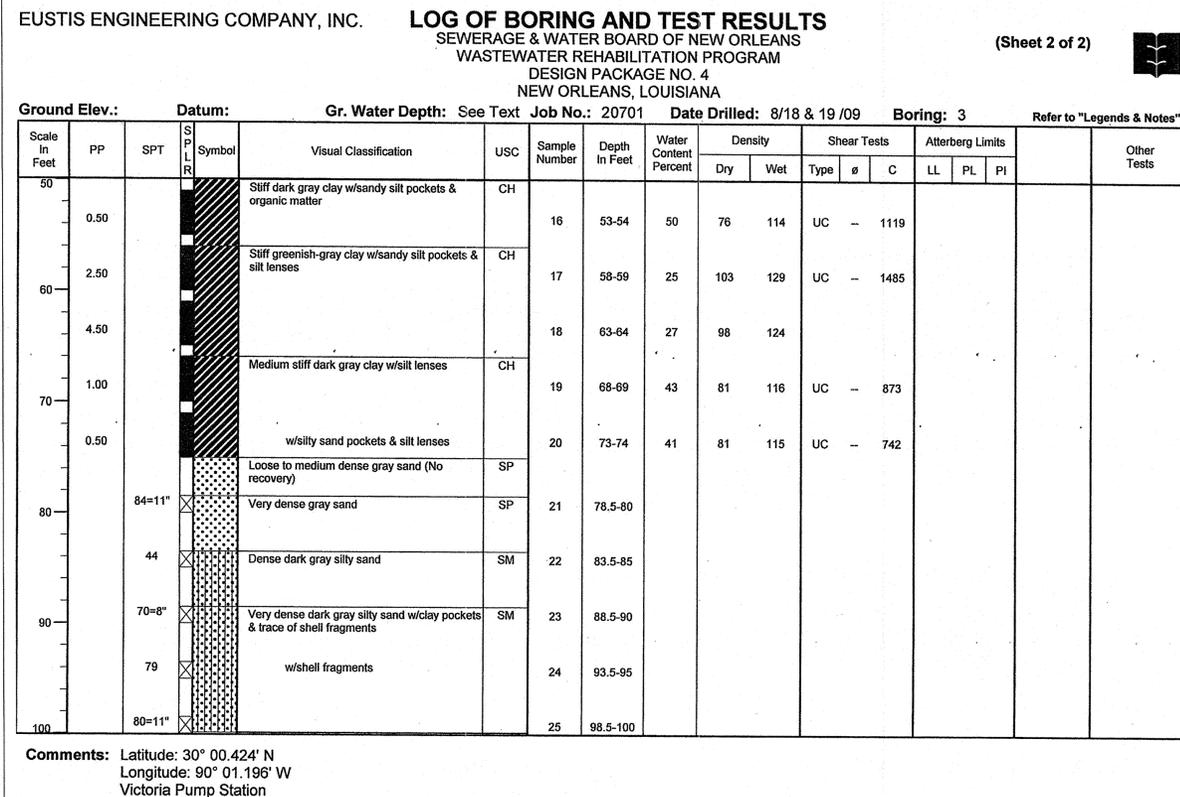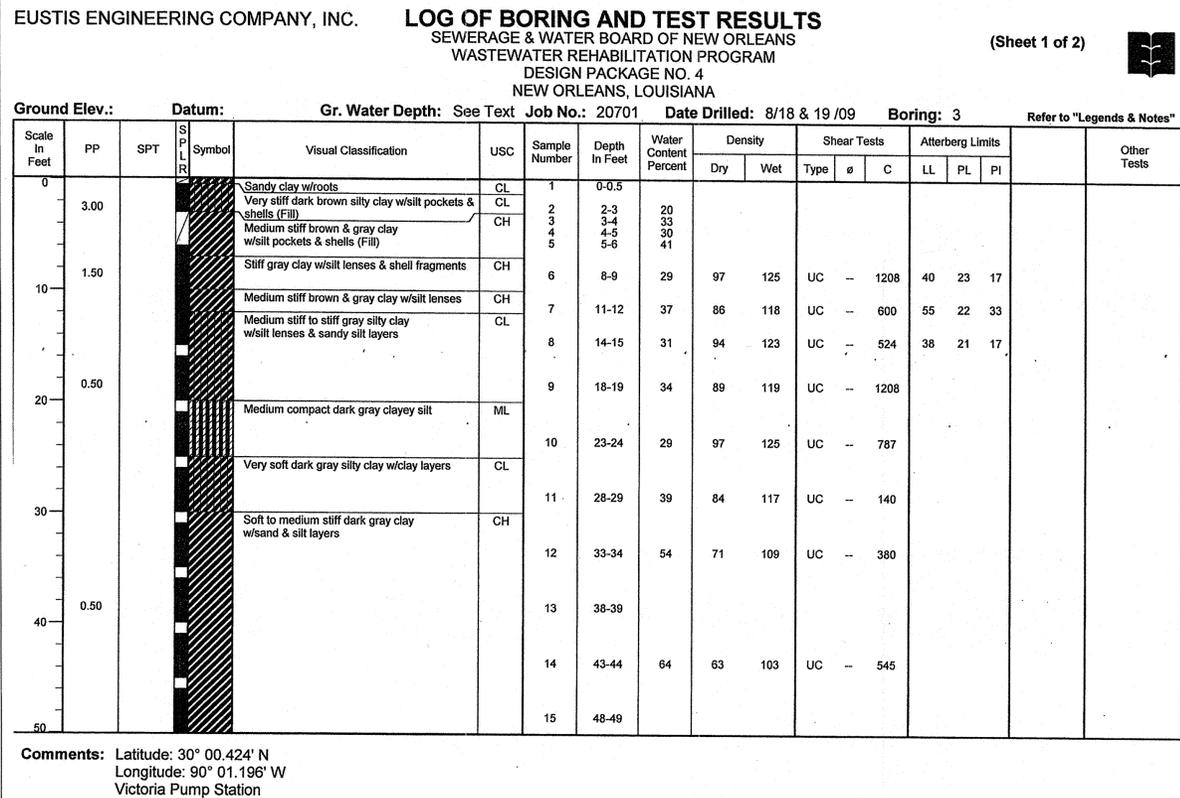

LEGEND AND NOTES FOR LOG OF BORING AND TEST RESULTS

PP Pocket penetrometer: Resistance in tons per square foot

SPT Standard Penetration Test: Number of blows of a 140-lb hammer dropped 30 inches required to drive 2-in. O.D., 1.4-in. I.D. sampler a distance of 1 foot into the soil after first seating it 6 inches

SPLR Type of Sampling: [Symbol] Shelby [Symbol] SPT [Symbol] Auger [Symbol] No sample

SYMBOL Clay [Symbol] Silt [Symbol] Sand [Symbol] Peat/Humus [Symbol] Shells [Symbol] Stone/Gravel

Predominant type shown heavy; Modifying type shown light

USC Unified Soil Classification

DENSITY Unit weight in pounds per cubic foot

SHEAR TESTS
 TYPE
 UC Unconfined compression shear
 OB Unconsolidated undrained triaxial compression shear on one specimen confined at the approximate overburden pressure
 UU Unconsolidated undrained triaxial compression shear
 CU Consolidated undrained triaxial compression shear
 DS Direct shear


φ Angle of internal friction in degrees
 c Cohesion in pounds per square foot

ATTERBERG LIMITS
 LL Liquid Limit
 PL Plastic Limit
 PI Plasticity Index

OTHER TESTS
 CON Consolidation
 PD Particle size distribution (sieve and/or hydrometer)
 k Coefficient of permeability in centimeters per second
 SP Swelling pressure in pounds per square foot

Other laboratory test results reported on separate figures

GENERAL NOTES
 (1) If a ground water depth is shown on the boring log, these observations were made at the time of drilling and were measured below the existing ground surface. These observations are shown on the boring logs. However, ground water levels may vary due to seasonal fluctuations and other factors. If important to construction, the depth to ground water should be determined by those persons responsible for construction immediately prior to beginning work.
 (2) While the individual logs of borings are considered to be representative of subsurface conditions at their respective locations on the dates shown, it is not warranted that they are representative of subsurface conditions at other locations and times.

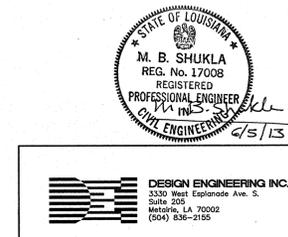

STRUCTURAL

REV.	DATE	DESCRIPTION	BY

SEWERAGE AND WATER BOARD OF NEW ORLEANS

CONTRACTS 3668
 HURRICANE KATRINA RELATED
 404 HAZARD MITIGATION GRANT PROGRAM
 REPLACEMENT OF VICTORIA SEWAGE PUMPING STATION

BORING LOGS

DR.	
TRC.	
CK.	
AP.	
SCALE: AS SHOWN	DWG. No. 12039-W-63
DATE: JANUARY 2012	SET NO. SHEET NO. 13

DESIGN ENGINEERING INC.
 3330 West Esplanade Ave. S.
 Suite 205
 Metairie, LA 70002
 (504) 835-2100

I. GENERAL NOTES:

- STRUCTURAL DESIGN IS IN ACCORDANCE WITH THE FOLLOWING:
NEW ORLEANS STANDARD BUILDING CODE 2007 W/ AMENDMENTS
INTERNATIONAL BUILDING CODE 2009
AMERICAN SOCIETY OF CIVIL ENGINEERS ASCE 7-05
AMERICAN CONCRETE INSTITUTE ACI 318-08
AMERICAN WELDING SOCIETY AWS D1.1-2004
AMERICAN INSTITUTE OF STEEL CONSTRUCTION 13TH EDITION
MASONRY STANDARD JOINT COMMITTEE TMS 402-08/ACI-530.1-8
- CONTRACTOR TO VERIFY EXISTING CONDITIONS, VERIFY DIMENSIONS, ELEVATIONS AND SHALL REPORT ANY INCONSISTENCIES TO THE BOARD ENGINEER.
- THE LOCATIONS OF UTILITIES AS SHOWN IS APPROXIMATE. ALL UNDERGROUND ELEVATIONS (PIPE, CONDUIT, ETC.) SHOWN ON THE DRAWINGS SHALL BE VERIFIED ON THE JOB SITE BY CONTRACTOR.
- ELEVATIONS ARE CAIRO DATUM ADJUSTED FROM NAVD88 DATUM OBTAINED FROM OPUS PROCESSING OF GPS OBSERVATION DATA COLLECTED ON JULY 8, 2009 AND PROCESSED ON JULY 9, 2009.
- ALL SHEETING AND BRACING REQUIRED FOR EXCAVATION SHALL BE THE RESPONSIBILITY OF THE CONTRACTOR & SHALL BE DESIGNED BY A REGISTERED LOUISIANA PROFESSIONAL ENGINEER.
- ALL FORMWORK AND TEMPORARY STRUCTURES SHALL BE DESIGNED IN ACCORDANCE WITH ASCE-37-02, DESIGN LOADS ON STRUCTURES DURING CONSTRUCTION.

II. PILE NOTES:

- ALL PILES SHALL BE PRESTRESSED CONCRETE PILES, UNLESS NOTED OTHERWISE.
- TENSION CONNECTORS SHALL BE PROVIDED AS SHOWN ON THE PLANS.
- CONCRETE STRENGTH SHALL BE 5000 PSI AT 28 DAYS.
- STRANDS SHALL BE LOW RELAXATION 270 KSI PER ASTM A416.
- TIMBER PILES SHALL BE IN CONFORMANCE WITH ASTM D25.
- PILE TIP ELEVATIONS ARE FINAL. PILE TIPS ARE DETERMINED BY USING A FACTOR OF SAFETY OF 3.0 NO LOAD TEST IS REQUIRED.
- CONTRACTOR SHALL PROBE @ PILE LOCATIONS TO ENSURE THERE ARE NO SUBSURFACE OBSTACLES.

III. STRUCTURAL STEEL NOTES:

- WIDE FLANGE BEAMS FOR OPERATING FLOOR SHALL BE ASTM A992 WITH MINIMUM YIELD STRENGTH OF 50 KSI. ALL OTHER STEEL SHALL CONFORM TO ASTM A36 WITH MINIMUM YIELD STRENGTH OF 36 KSI. STRUCTURAL PIPING SHALL CONFORM TO ASTM A53, GRADE B. STRUCTURAL TUBING SHALL CONFORM TO ASTM A500.
- WELDING SHALL BE ARC WELDING USING E70 ELECTRODES IN ACCORDANCE WITH AWS D1.1 AND MUST BE MADE WITH CERTIFIED WELDERS. REMOVE PAINT IN AREAS TO BE WELDED. ALL WELDS SHALL BE CONTINUOUS UNLESS NOTED OTHERWISE.
- BOLTS SHALL BE ASTM A325 AND ANCHOR BOLTS SHALL BE ASTM F1554, GRADE 55 KSI HEX HEADED NUTS & WASHERS. ANCHOR RODS AND ALL EXPOSED BOLTS, NUTS, AND WASHERS SHALL BE HOT-DIPPED GALVANIZED, UNLESS NOTED OTHERWISE.
- STRUCTURAL STEEL SHALL BE PAINTED IN ACCORDANCE WITH SECTION 11 OF THE SPECIFICATIONS UNLESS SHOWN ON DRAWINGS TO BE HOT-DIPPED GALVANIZED OR STAINLESS STEEL. STAINLESS STEEL BOLTS SHALL BE MADE FROM ALLOY 304 OR 316 WITH ASTM F593 NUTS.
- TO PREVENT CORROSION BY MOISTURE BETWEEN STEEL SURFACES IN CONTACT, ALL SUCH CONTACTS SHALL BE SEALED WATERTIGHT BY RUNNING A CONTINUOUS 1/8" FILLET WELD ALONG ALL EDGES OF THE CONTACT, UNLESS OTHERWISE NOTED.

IV. MASONRY NOTES:

- CONCRETE MASONRY UNITS SHALL CONFORM TO ASTM C90 OR APPROVED EQUAL. MORTAR FOR MASONRY SHALL CONFORM TO FOLLOWING REQUIREMENTS:
MORTAR SHALL BE TYPE M OR S WITH A MINIMUM AVERAGE COMPRESSIVE STRENGTH OF 1800 PSI.
JOINT REINFORCEMENT SHALL CONFORM TO ASTM A951 AND SHALL EITHER BE TRUSS TYPE OR LADDER TYPE.
- REINFORCING BARS/TIE RODS ARE REQUIRED ON EACH SIDE OF OPENING:
OPENINGS OF 4'-0" OR SMALLER = 1 #5 EACH SIDE
OPENINGS OF 4'-0" OR LARGER = 2 #5 EACH SIDE
- GROUT SHALL CONFORM TO ASTM C476. GROUT PLACEMENT SHALL BE ACCORDING TO MINIMUM SPACE REQUIREMENTS AS PER FOLLOWING TABLE:

GROUT TYPE	MAX. GROUT POUR HEIGHT (FEET)	MINIMUM GROUT SPACE DIMENSIONS OF HOLLOW LIMITS (INCH)
FINE	1	1 1/2 x 2
FINE	5	2 x 3
FINE	12	2 1/2 x 3
COARSE	1	1 1/2 x 3
COARSE	5	2 1/2 x 3
COARSE	12	3 x 3

V. TIMBER NOTES:

- WOOD FRAMING FABRICATION AND ERECTION SHALL CONFORM TO NATIONAL DESIGN SPECIFICATIONS.
- FRAMING SHALL BE OF SOUTHERN PINE NO. 2 DENSE. TIMBER SHALL HAVE A MINIMUM ALLOWABLE STRESSES AS FOLLOWS:

DESCRIPTION	2x6	2x10
EXTREME FIBER STRESS IN BENDING F _b	1,450	1,200
TENSION PARALLEL TO GRAIN F _t	775	625
HORIZONTAL SHEAR F _v	175	175
MODULUS OF ELASTICITY E	1,750,000	1,650,000

- PRESERVATIVE TREATED TIMBER SHALL CONFORM TO THE REQUIREMENTS OF APPLICABLE AWPA STANDARDS C1, C2, C9, C15, AND M4 FOR SPECIES, PRODUCT AND PRESERVATIVE AND END USE. PRESERVATIVES SHALL CONFORM TO AWPA P1/P13, P2, P5, P8 AND P9.
- TO MAINTAIN STRUCTURAL INTEGRITY IN FRAMING, STUDS IN EXTERIOR AND INTERIOR WALLS ARE PERMITTED TO BE DRILLED OR NOTCHED WITH FOLLOWING LIMITATIONS:
a) BORED HOLE SHALL BE MAXIMUM 2" IN 2x6 STUDS AND NOT LESS THAN 5/8" FROM EDGE.
b) NOTCH SHALL NOT EXCEED 1 3/8" FOR 2x6 STUDS. NOTCH AND HOLE SHALL NOT BE AT SAME LOCATION. IN CASE HOLE OR NOTCH SIZE EXCEEDS THESE LIMITATIONS, THEN PROVIDE DOUBLE STUDS. SIZE OF BORE AND NOTCH SHALL NOT EXCEED BY MORE THAN 50% OF SIZE CALLED OUT.
- ALL CONNECTIONS ARE DETAILED USING COMMON NAILS - CONTRACTOR CAN USE OTHER NAILS WITH EQUIVALENT STRENGTH EXCEPT CALLED OUT OTHERWISE. CONTRACTOR SHALL SUBMIT SHOP DRAWINGS FOR ALL CONNECTIONS FOR APPROVAL.

VI. ROOFING NOTES:

- ALL ROOFING METAL SHALL BE GAGE METAL THICKNESS AND COATING PER SPECIFICATIONS.

VII. CONCRETE NOTES:

- ALL STRUCTURAL CONCRETE SHALL ATTAIN A STRENGTH OF 4000 PSI AT 28 DAYS.
- ALL REINFORCING BARS SHALL CONFORM TO ASTM A-615 GRADE 60 PROVIDE CORNER BARS @ ALL CORNERS
- REINFORCING BARS SHALL BE BENT AS SHOWN ON THE DRAWINGS AND SHALL BE DETAILED, FABRICATED AND PLACED IN ACCORDANCE WITH THE ACI 315. ALL ACCESSORIES SHALL BE PLASTIC TIPPED.
- CONCRETE STRUCTURAL DESIGN IS BASED UPON THE LATEST EDITION OF ACI 318.
- CHAMFER ALL EXPOSED CONCRETE EDGES EXPOSED TO VIEW 3/4" UNLESS NOTED OTHERWISE.
- COAT INTERIOR OF PRECAST CONC. MANHOLE AND WET WELL WITH PROTECTIVE COATING. (SEE SPEC'S SECTION 14)
- PRIME PIT FLOOR WITH ONE COAT OF PPG AMERLOCK SEALER. FINISH WITH ONE COAT OF PPG AMERLOCK 400GFK-COLOR OXIDE RED. PREPARE SURFACE AND COAT IN ACCORDANCE w/MANUFACTURE'S RECOMMENDATIONS. (SEE SPEC'S SECTION 11).
- REINFORCING BARS AT PIPE AND OTHER MISCELLANEOUS OPENING: WHEN OPENING SIZE IS EQUAL OR SMALLER THAN BAR SPACING, REBARS IN BOTH DIRECTIONS SHALL BE MOVED AROUND TO RUN CONTINUOUS. FOR PIPE OPENINGS LARGER THAN BAR SPACING, CURTAIL BARS RUNNING INTO OPENING, AND ADD EXTRA EQUAL NUMBER OF BARS EACH SIDE OF OPENING. AREA OF ADDED BARS SHALL EQUAL OF EXCEED CURTAILED BARS.

NOTES:

- USE THE BASIC TABLE IF ALL OF THE FOLLOWING CONDITIONS ARE MET:
A) CENTER TO CENTER BAR SPACING LATERALLY IS AT LEAST 3 BAR DIAMETERS.
B) DISTANCE FROM THE CENTER OF A BAR TO THE NEAREST CONCRETE SURFACE MUST BE AT LEAST 2 BAR DIAMETERS.
- THE ALTERNATE TABLE MAY BE USED IF ALL OF THE FOLLOWING CONDITIONS ARE MET:
A) CENTER TO CENTER BAR SPACING LATERALLY IS AT LEAST 5 BAR DIAMETERS.
B) DISTANCE FROM THE CENTER OF A BAR TO THE NEAREST CONCRETE SURFACE MUST BE AT LEAST 2.5 BAR DIAMETERS.
- IF CONCRETE COVER OR EDGE DISTANCE IS LESS THAN 1 BAR DIAMETER OR THE CENTER TO CENTER BAR SPACING LATERALLY IS LESS THAN 3 DIAMETERS, SEE ACI 318 FOR APPROPRIATE GUIDANCE.
- TOP BARS ARE HORIZONTAL BARS AND BARS INCLINED LESS THAN 45 DEGREES WITH RESPECT TO A HORIZONTAL PLANE WHICH ARE PLACED SUCH THAT MORE THAN 12 INCHES OF CONCRETE IS CAST IN THE MEMBER BELOW THE BAR.
- THE TABLES SHOWN ABOVE ARE FOR NORMAL WEIGHT CONCRETE AND UNCOATED REINFORCING BARS. IF EPOXY COATED BARS ARE USED, SEE ACI 318 FOR ADDITIONAL CONSIDERATIONS.


REINFORCEMENT EMBEDMENT AND SPLICE TABLE - 4000 PSI

BAR SIZE	BASIC TABLE		ALTERNATE TABLE	
	MINIMUM EMBEDMENT LENGTH, INCHES	MINIMUM LAP LENGTH, INCHES	MINIMUM EMBEDMENT LENGTH, INCHES	MINIMUM LAP LENGTH, INCHES
	TOP BARS	OTHER	TOP BARS	OTHER
3	18	14	15	12
4	25	19	20	15
5	31	24	25	19
6	36	28	29	22
7	54	41	43	33
8	61	47	49	38
9	69	53	55	42
10	78	60	62	48
11	86	66	69	53


POST-INSTALLED ANCHOR BOLT DETAILS

LOCATION	TYPE	SIZE	ALLOWABLE LOADS IN LBS	
			TENSION	SHEAR
MONORAIL COLUMN AND PLATFORM FRAMING	HIT-RE 500 ADHESIVE ANCHOR CARBON STEEL	3/4"Øx6 3/4"	10,755	17,840
EXHAUST BLOWER AND SAFETY CHAIN LADDER	HIT-ICE/HIT-HY 150 STAINLESS STEEL	1/2"Øx4 1/4"	1,785	2,020
LADDER	KWIK BOLT 3 STAINLESS STEEL	1/2"Øx4 3/4"	2,510	3,580
GATE VALVE	KWIK BOLT 3 STAINLESS STEEL	5/8"Øx4"	3,340	4,870
C8x11.5 AT LADDER	KWIK BOLT 3 CARBON STEEL	3/4"Øx4 3/4"	5,285	7,325

THE BOLTS ARE DESIGNED USING ABOVE FORCES FROM HILTI 2008 CATALOG. CONTRACTOR MAY PROVIDE ALTERNATE BOLTS WITH EQUAL OR HIGHER STRENGTH. CARBON STEEL BOLTS SHALL HAVE ELECTRO DEPOSITED ZINC COATING.

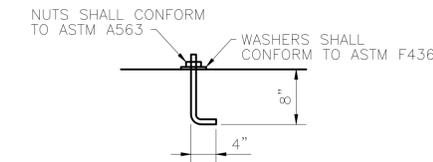


TYPICAL CAST IN PLACE ANCHOR BOLT DETAIL
NOT TO SCALE

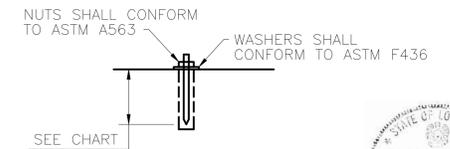


POST INSTALLED ANCHOR BOLT DETAIL
NOT TO SCALE

CROSS REFERENCES

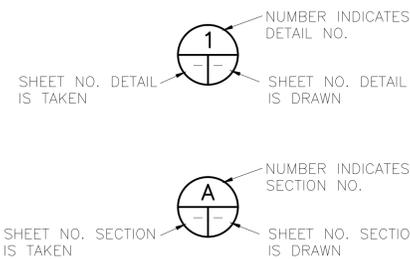

BUILDING IS DESIGNED FOR THE FOLLOWING LOADING:

- | | | | |
|------------------|-------------------|---|---------|
| 1.) ROOF | LIVE LOAD | = | 20 PSF |
| FIRST FLOOR | LIVE LOAD | = | 200 PSF |
| | PUMP PIT FLOOR | = | 250 PSF |
| 2.) WIND LOADING | BASIC WIND SPEED | = | 130 MPH |
| | EXPOSURE | = | B |
| | IMPORTANCE FACTOR | = | 1.15 |

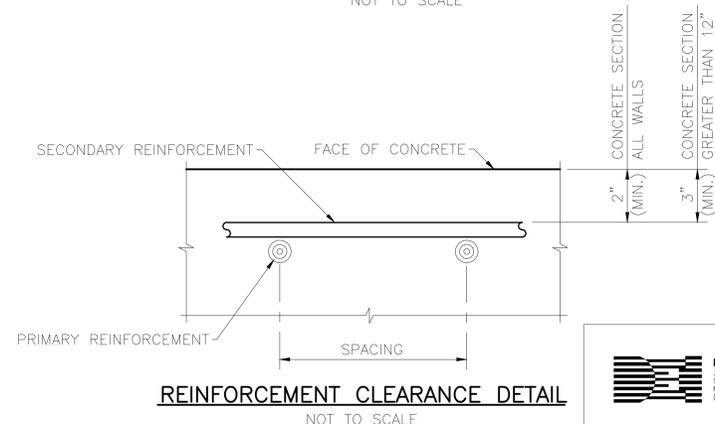

DESIGN ENGINEERING INC.
3330 West Esplanade Ave. S.
Suite 205
Metairie, LA 70002
(504) 836-2155




STRUCTURAL

REV.	DATE	DESCRIPTION	BY
SEWERAGE AND WATER BOARD OF NEW ORLEANS			
CONTRACT 3668 HURRICANE KATRINA RELATED 404 HAZARD MITIGATION GRANT PROGRAM REPLACEMENT OF VICTORIA SEWAGE PUMPING STATION			
STRUCTURAL NOTES			
DR: MZ	GENERAL SUPERINTENDENT		
TRC: --	DWG. No. 12039-W-63		
CK: MS/AR	DATE: SEPTEMBER 2013		
AP: JH	SHEET NO. 14		
SCALE: AS SHOWN	SHEET NO. 14		

PRINTED Sep 26, 2013 11:06am FILENAME J:\6005.1-(CONFORMED DRAWINGS)\Contract 3668 - Victoria SPS\SH1 14_VIC_STRUC NOTES.dwg

PRINTED May 31, 2013 9:08am FILENAME - J:\6005.1-GOSHEP-2013\Contract 3668 - Victoria SPS\SH15_VIC_FOUND.dwg

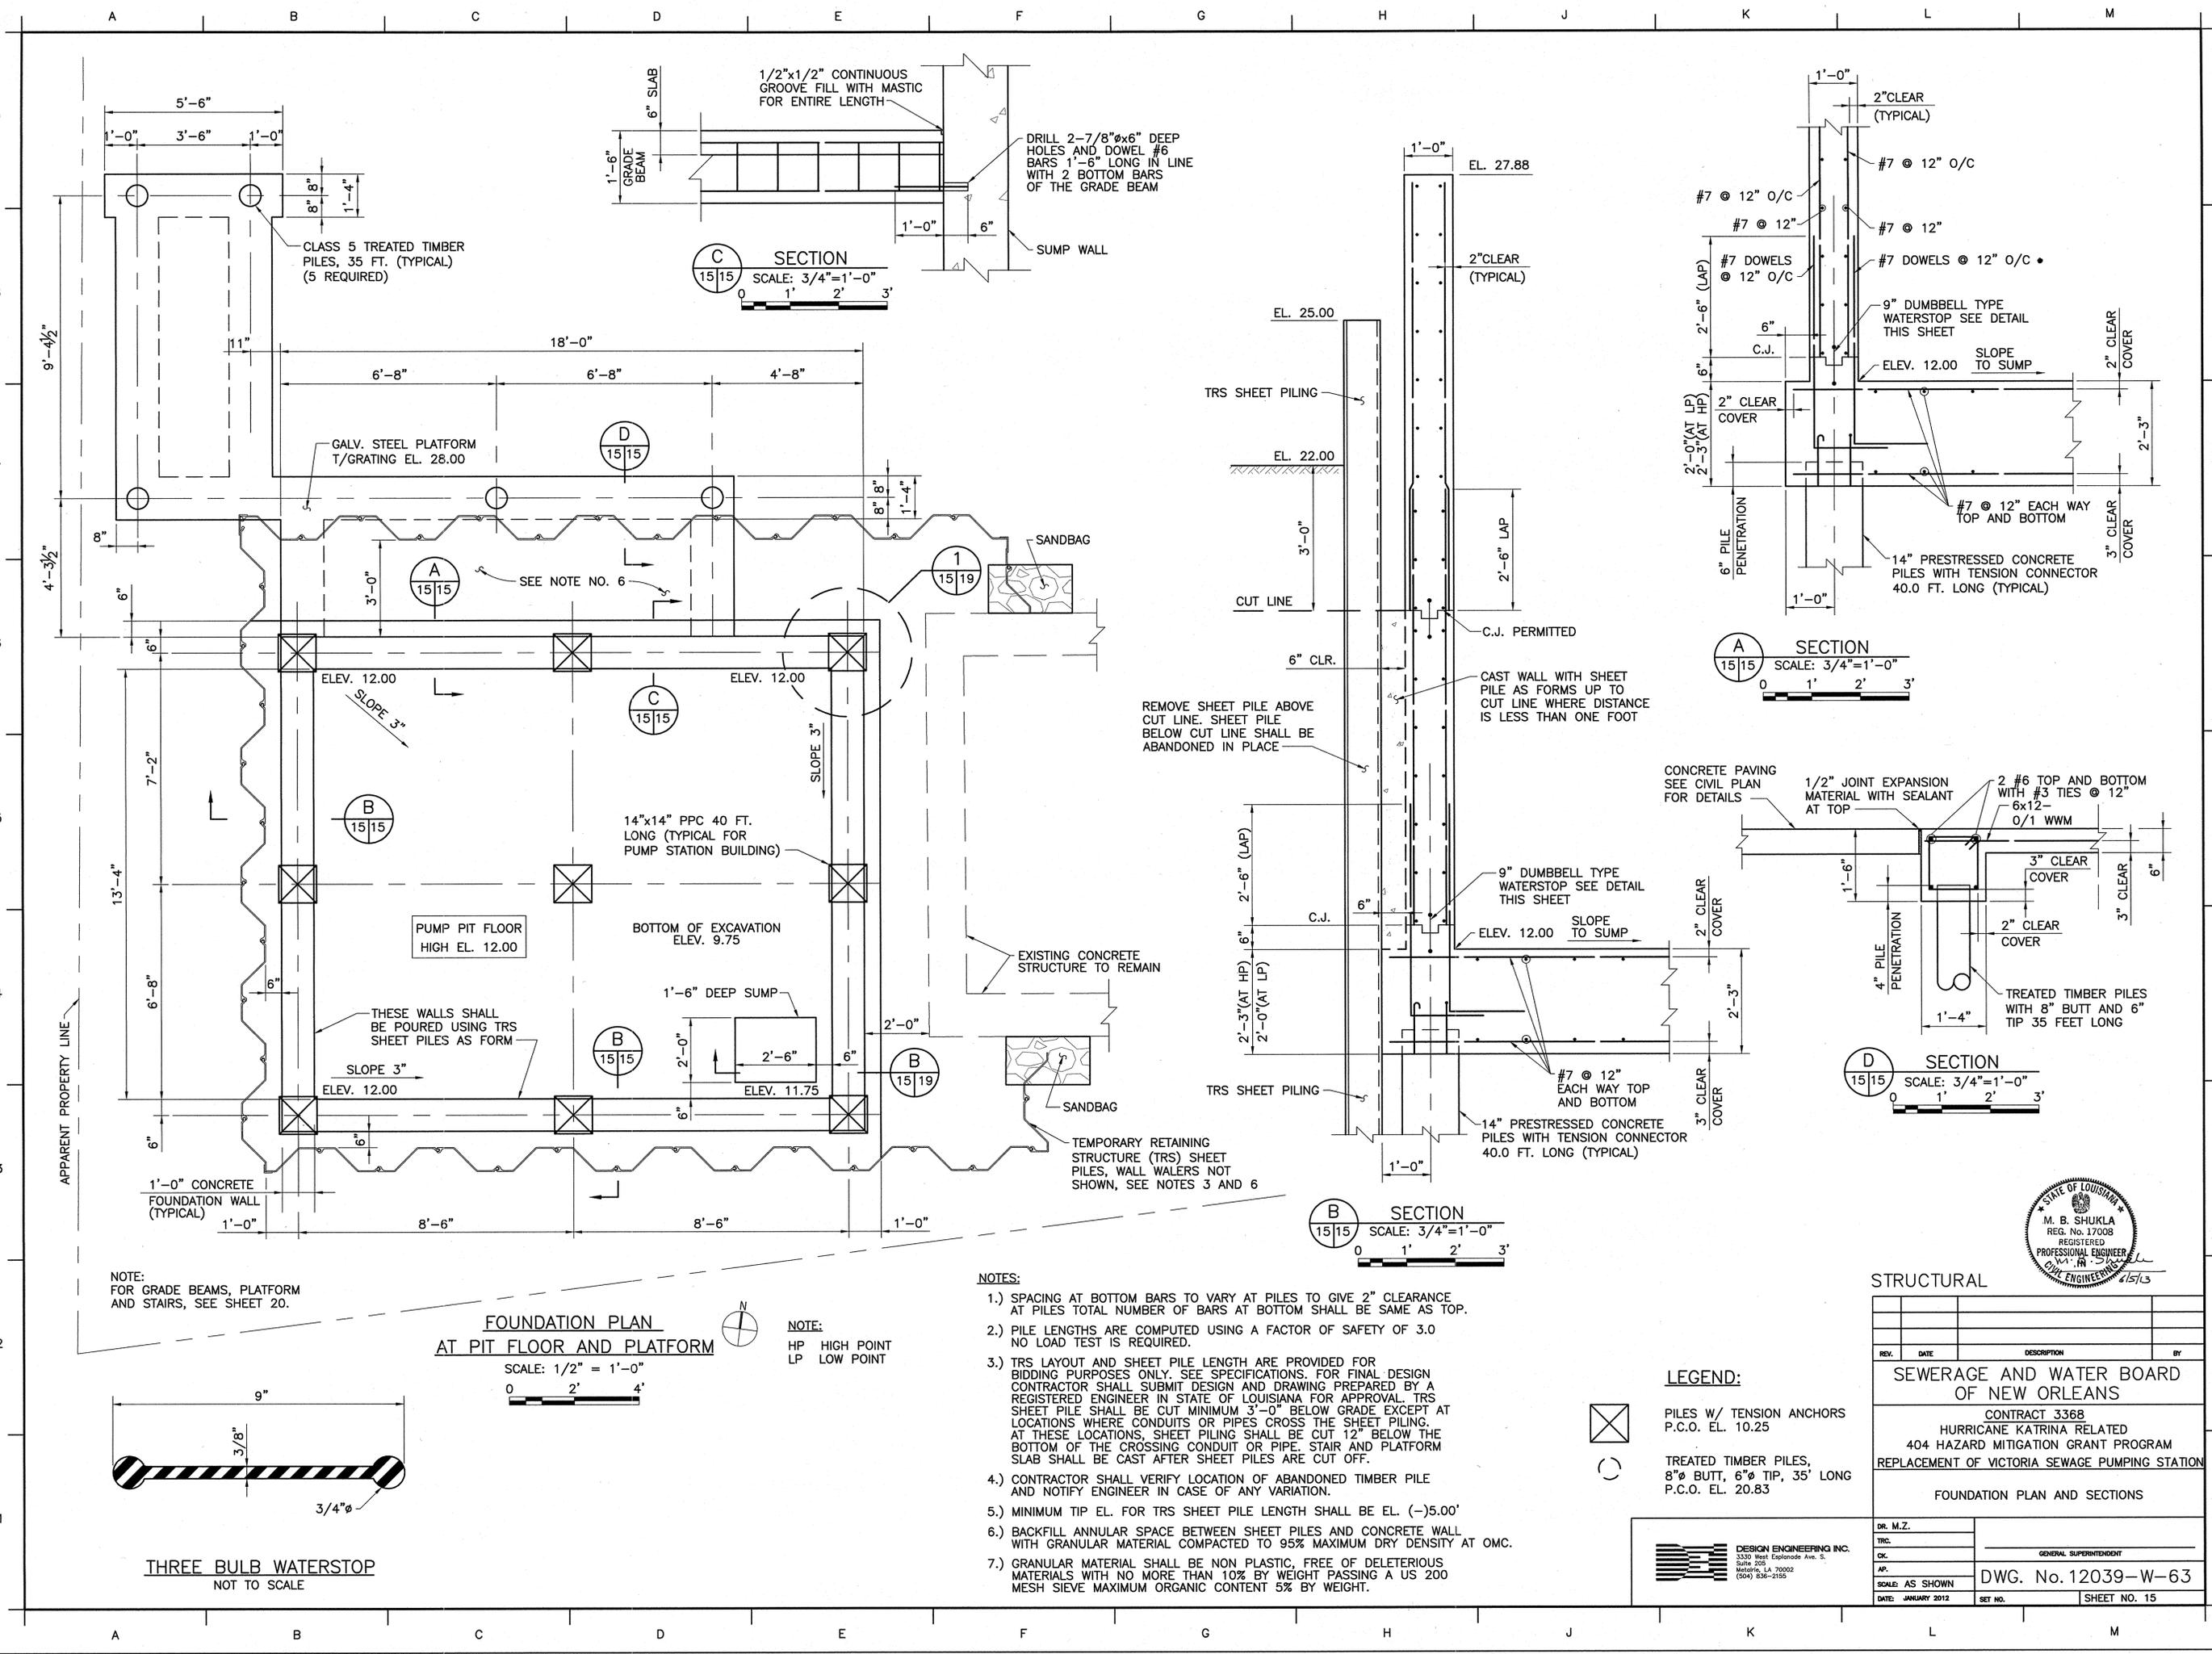

FOUNDATION PLAN
AT PIT FLOOR AND PLATFORM

SCALE: 1/2" = 1'-0"
0 2' 4'

NOTE:
HP HIGH POINT
LP LOW POINT

NOTES:

- 1.) SPACING AT BOTTOM BARS TO VARY AT PILES TO GIVE 2" CLEARANCE AT PILES TOTAL NUMBER OF BARS AT BOTTOM SHALL BE SAME AS TOP.
- 2.) PILE LENGTHS ARE COMPUTED USING A FACTOR OF SAFETY OF 3.0 NO LOAD TEST IS REQUIRED.
- 3.) TRS LAYOUT AND SHEET PILE LENGTH ARE PROVIDED FOR BIDDING PURPOSES ONLY. SEE SPECIFICATIONS. FOR FINAL DESIGN CONTRACTOR SHALL SUBMIT DESIGN AND DRAWING PREPARED BY A REGISTERED ENGINEER IN STATE OF LOUISIANA FOR APPROVAL. TRS SHEET PILE SHALL BE CUT MINIMUM 3'-0" BELOW GRADE EXCEPT AT LOCATIONS WHERE CONDUITS OR PIPES CROSS THE SHEET PILING. AT THESE LOCATIONS, SHEET PILING SHALL BE CUT 12" BELOW THE BOTTOM OF THE CROSSING CONDUIT OR PIPE. STAIR AND PLATFORM SLAB SHALL BE CAST AFTER SHEET PILES ARE CUT OFF.
- 4.) CONTRACTOR SHALL VERIFY LOCATION OF ABANDONED TIMBER PILE AND NOTIFY ENGINEER IN CASE OF ANY VARIATION.
- 5.) MINIMUM TIP EL. FOR TRS SHEET PILE LENGTH SHALL BE EL. (-)5.00'
- 6.) BACKFILL ANNULAR SPACE BETWEEN SHEET PILES AND CONCRETE WALL WITH GRANULAR MATERIAL COMPACTED TO 95% MAXIMUM DRY DENSITY AT OMC.
- 7.) GRANULAR MATERIAL SHALL BE NON PLASTIC, FREE OF DELETERIOUS MATERIALS WITH NO MORE THAN 10% BY WEIGHT PASSING A US 200 MESH SIEVE MAXIMUM ORGANIC CONTENT 5% BY WEIGHT.

LEGEND:


- ☒ PILES W/ TENSION ANCHORS P.C.O. EL. 10.25
- TREATED TIMBER PILES, 8"Ø BUTT, 6"Ø TIP, 35' LONG P.C.O. EL. 20.83

DESIGN ENGINEERING INC.
3330 West Esplanade Ave. S.
Suite 209
Metairie, LA 70002
(504) 885-2155


STRUCTURAL			
REV.	DATE	DESCRIPTION	BY
SEWERAGE AND WATER BOARD OF NEW ORLEANS			
CONTRACT 3368 HURRICANE KATRINA RELATED 404 HAZARD MITIGATION GRANT PROGRAM REPLACEMENT OF VICTORIA SEWAGE PUMPING STATION			
FOUNDATION PLAN AND SECTIONS			
DR. M.Z.			
TRC:			
DC:			
AP:			
SCALE: AS SHOWN		DWG. No. 12039-W-63	
DATE: JANUARY 2012		SHEET NO. 15	



PRINTED May 31, 2013 9:09am FILENAME - J:\6005.1-GOSHEP-2013\Contract 3668 - Victoria SPS\16_VIC_STRUC_FLOOR_PLAN.dwg

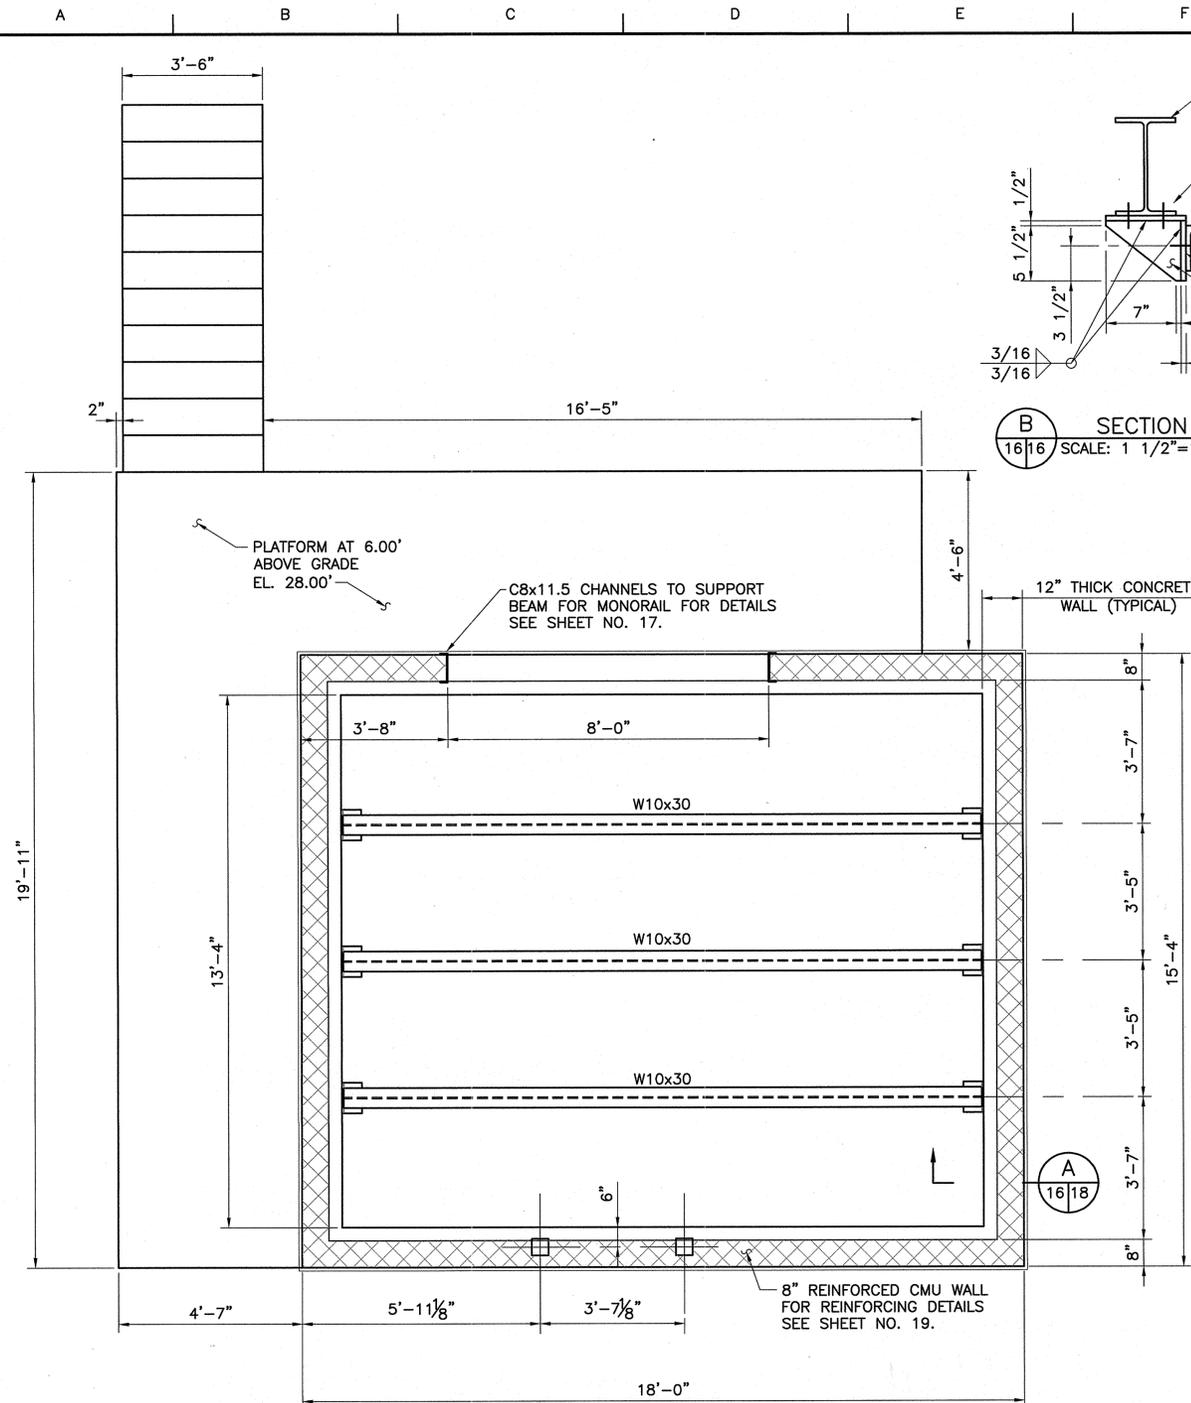


OPERATING FLOOR/FRAMING PLAN
SCALE: 1/2" = 1'-0"

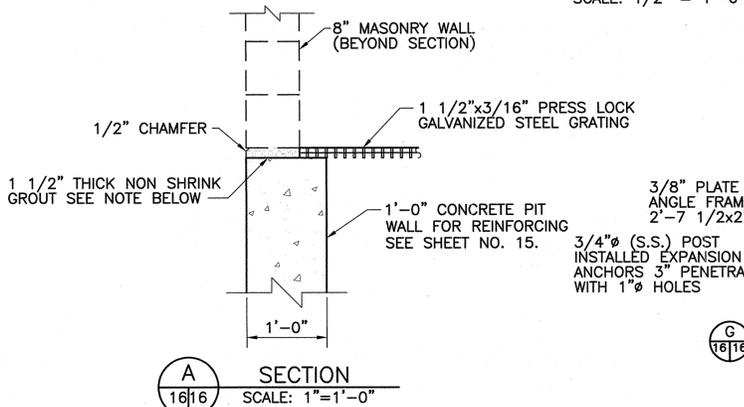

SECTION A
SCALE: 1" = 1'-0"


NOTE:
CONCRETE SURFACE SHALL BE CLEANED BEFORE POURING GROUT. GROUT SHALL BE PLACED AFTER THE CONCRETE WALL HAS CURED FOR A PERIOD OF 28 DAYS.

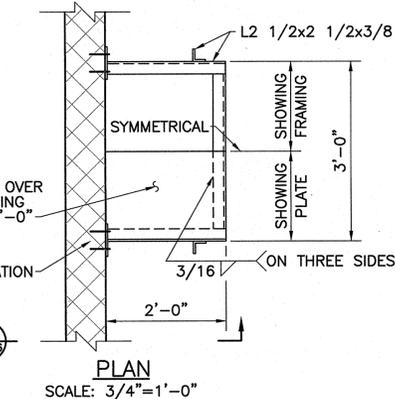


PLAN G
SCALE: 3/4" = 1'-0"

STAND DETAIL FOR EXHAUST BLOWER


NOTE:
1.) BOLT SIZE AND SPACING PER MANUFACTURER.
2.) BOLTS IN CMU WALL SHALL BE LOCATED A MINIMUM OF 1" AWAY FROM JOINTS.

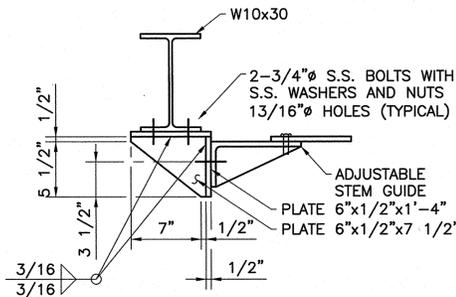


SECTION B
SCALE: 1 1/2" = 1'-0"

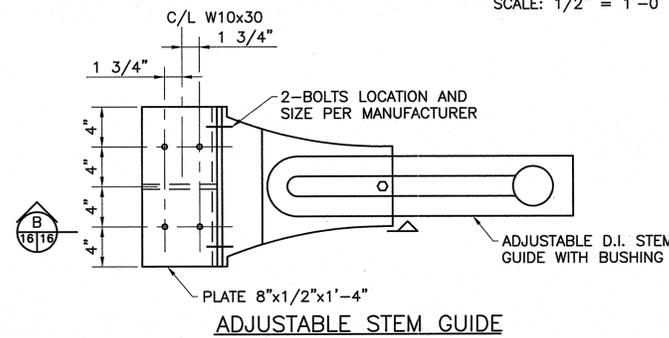

ADJUSTABLE STEM GUIDE AND BRACKET PLAN
SCALE: 1 1/2" = 1'-0"

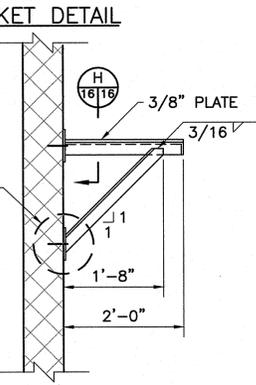



SECTION G
SCALE: 3/4" = 1'-0"

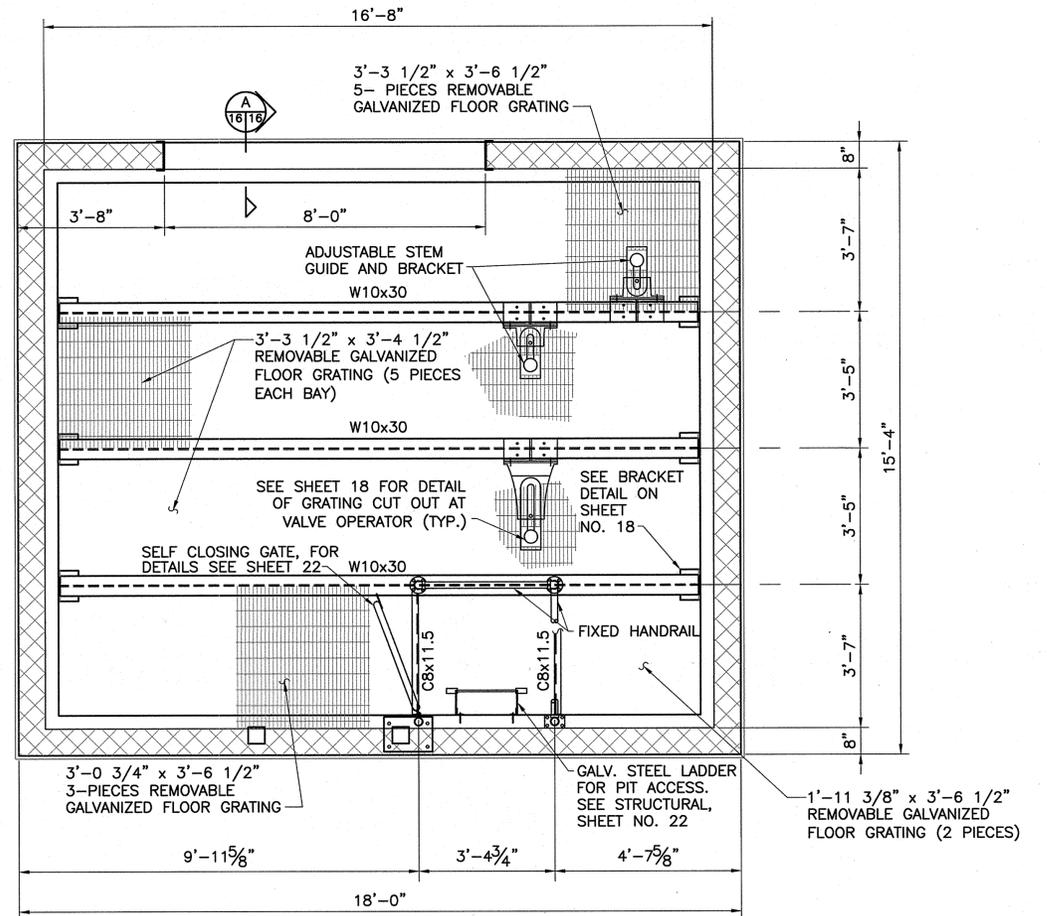

OPERATING FLOOR/GRATING PLAN
SCALE: 1/2" = 1'-0"

- NOTE:
- 1.) FLOOR BEAMS AND GRATING SHALL HAVE BOLTED CONNECTIONS (REMOVABLE TYPE). ALL BOLTS SHALL CONFORM TO ASTM A307. IF ANOTHER TYPE OF BOLTS ARE USED THE CONTRACTOR SHALL PROVIDE MANUFACTURER'S LITERATURE SHOWING BOLTS ARE REUSABLE TYPE.
 - 2.) THE OPERATING FLOOR SHALL CONSIST OF 20 PANELS, VARYING IN SIZE AS MARKED ON PLAN. SEE SPECIFICATIONS FOR GRATING DETAILS. PANELS SHALL BE ARRANGED TO MAINTAIN 1/2" GAP BETWEEN THEM FOR EASY REMOVAL.
 - 3.) ALL PIECES SHALL BE BANDED ON ALL FOUR SIDES, AND AT CUT-OUTS FOR MONORAIL COLUMNS AND HANDRAIL POSTS.
 - 4.) CUT OUT SHALL BE BANDED ON ALL FOUR SIDES AND LOCATED OVER NRS GATE VALVE OPERATING NUT.

SECTION H
SCALE: 3" = 1'-0"

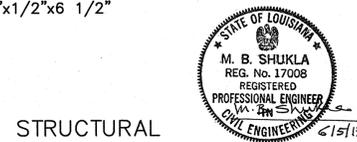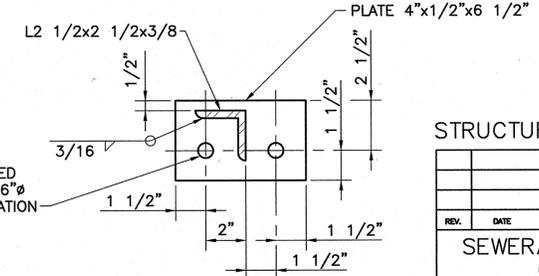

REV.	DATE	DESCRIPTION	BY

STRUCTURAL


SEWERAGE AND WATER BOARD OF NEW ORLEANS

CONTRACT 3668
HURRICANE KATRINA RELATED
404 HAZARD MITIGATION GRANT PROGRAM
REPLACEMENT OF VICTORIA SEWAGE PUMPING STATION

OPERATING FLOOR FRAMING AND GRATING PLAN


DR. MZ	
TRC	
CE	
AP	
SCALE: NONE	DWG. No. 12039-W-63
DATE: JANUARY 2012	SHEET NO. 16

PRINTED May 31, 2013 - 9:11am FILENAME - J:\6005.1-GOSHEP-2013\Contract 3688 - Victoria SPS\17_VIC_STRUC ROOF PLAN.dwg

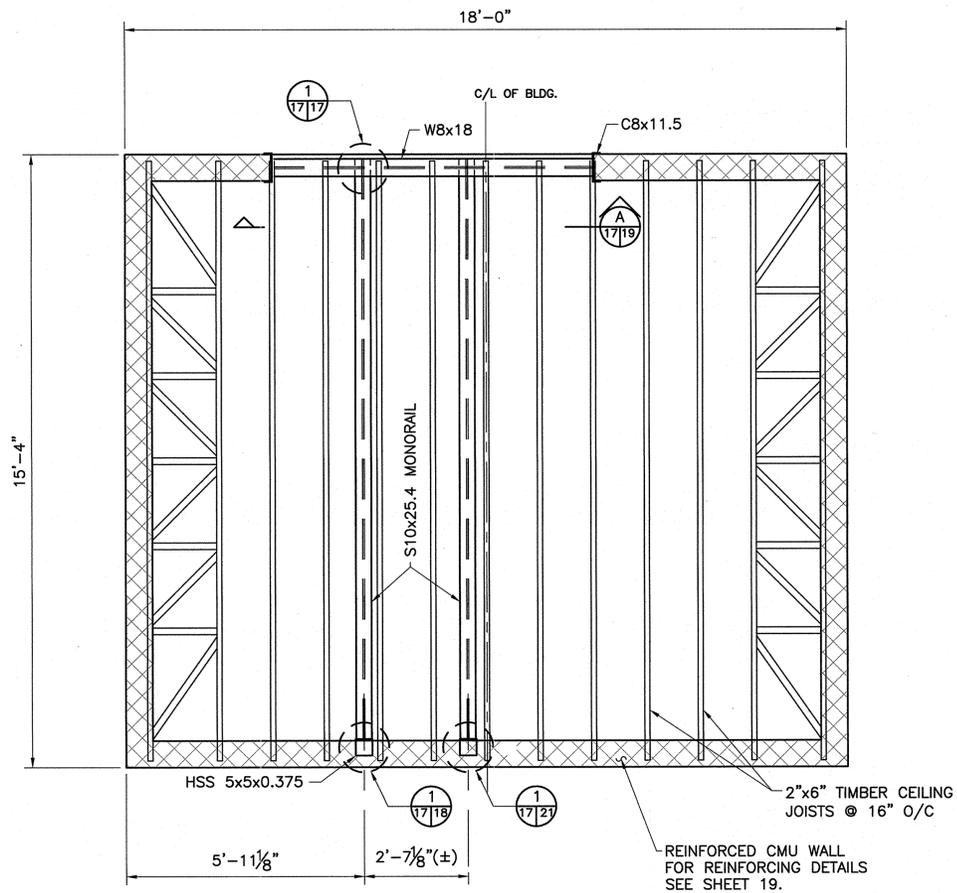


CEILING LEVEL FRAMING PLAN
 SCALE: 1/2" = 1'-0"


ROOF PENETRATION FOR SCADA ANTENNA. 2" Ø MAST SEE SHEET 5030-P3 FOR ANCHORING DETAILS

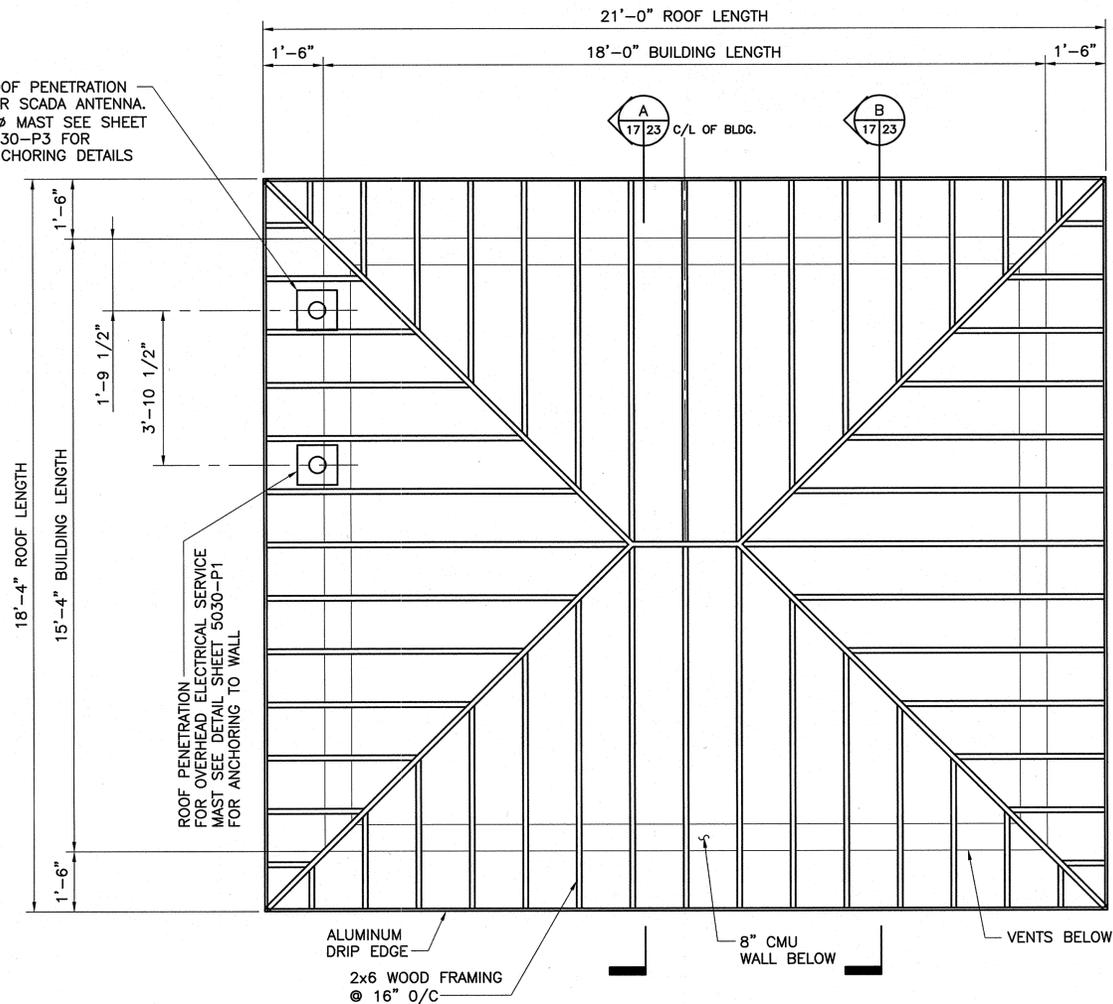

ROOF FRAMING PLAN
 SCALE: 1/2" = 1'-0"

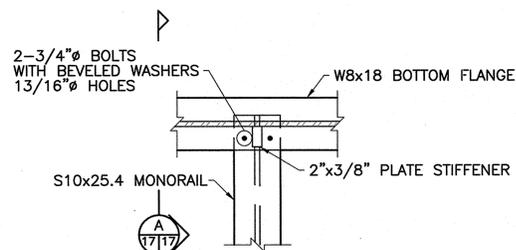

CONNECTION DETAIL
 SCALE: 1 1/2" = 1'-0"

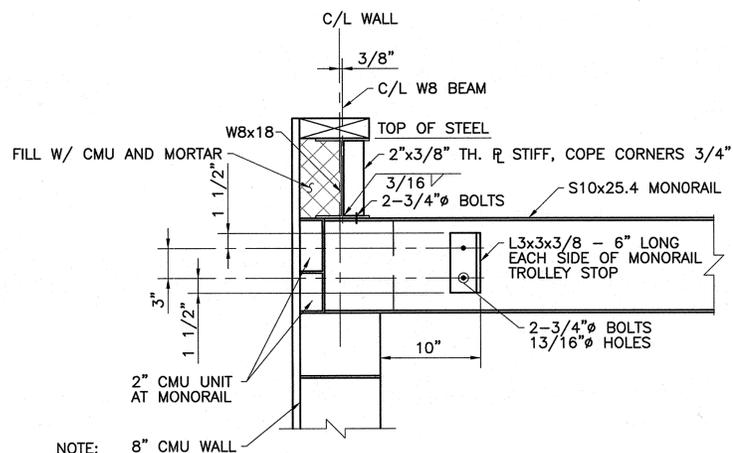

NOTE: THE CONTRACTOR SHALL STENCIL MONORAIL CAPACITY OF 1.5 TONS ON EITHER SIDE OF MONORAILS WITH YELLOW PAINT.
 SECTION A
 SCALE: 1 1/2" = 1'-0"


STRUCTURAL

REV.	DATE	DESCRIPTION	BY
SEWERAGE AND WATER BOARD OF NEW ORLEANS			
CONTRACT 3688 HURRICANE KATRINA RELATED 404 HAZARD MITIGATION GRANT PROGRAM REPLACEMENT OF VICTORIA SEWAGE PUMPING STATION			
CEILING LEVEL FRAMING AND ROOF PLAN			
DR. MZ			
TRC. --			
CK. MS			
AP. MS			
SCALE: AS SHOWN	DWG. No. 12039-W-63		
DATE: JANUARY 2012	SET NO.	SHEET NO. 17	




PRINTED Sep 26, 2013 11:07am FILENAME -- J:\6005.1-(CONFORMED DRAWINGS)\Contract 3668 -- Victoria SPS\SH18_VIC_FRAM DET.dwg


A B C D E F G H J K L M

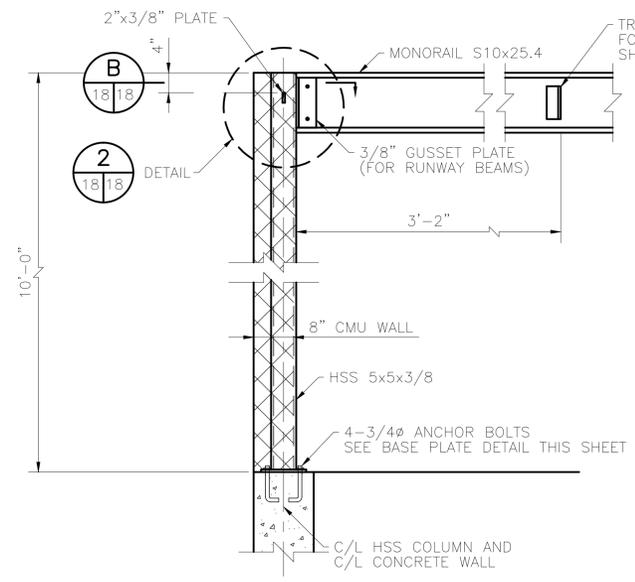

SECTION A
SCALE: 3/4" = 1'-0"
0 1' 2' 3'

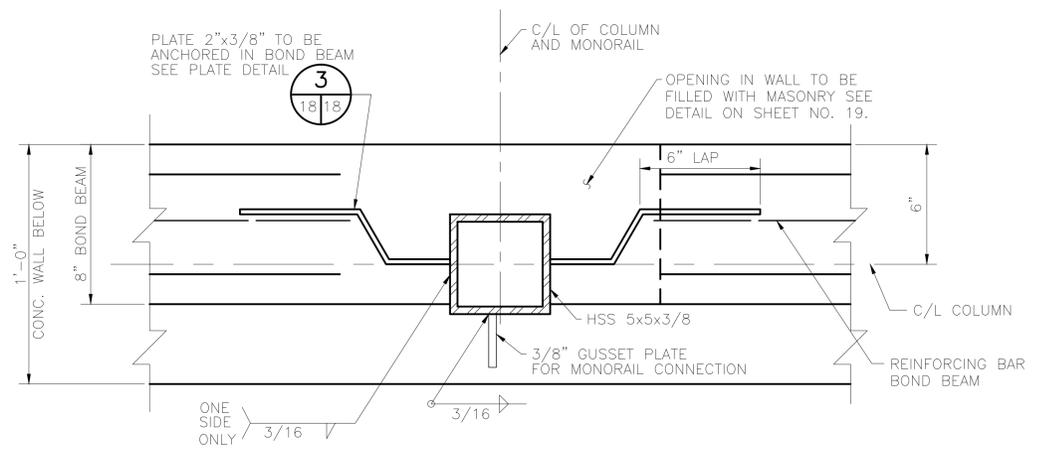


SECTION B
SCALE: 3" = 1'-0"
0 3' 6' 9' 1'

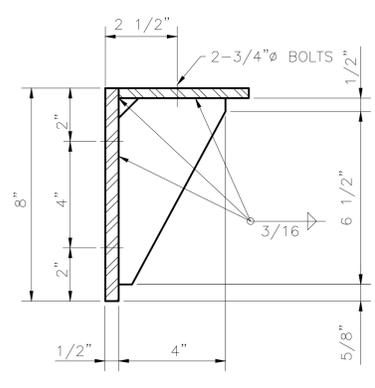


SECTION C
SCALE: 1 1/2" = 1'-0"
0 1' 2'

#5 DOWEL
(FOR 8" CMU WALL)

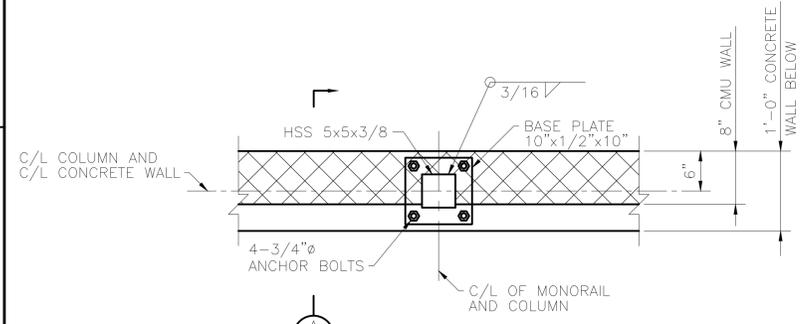


DETAIL 1
SCALE: 1" = 1'-0"
0 1' 2'


NOTE:
SEE BASE PLATE
DETAIL ON THIS SHEET

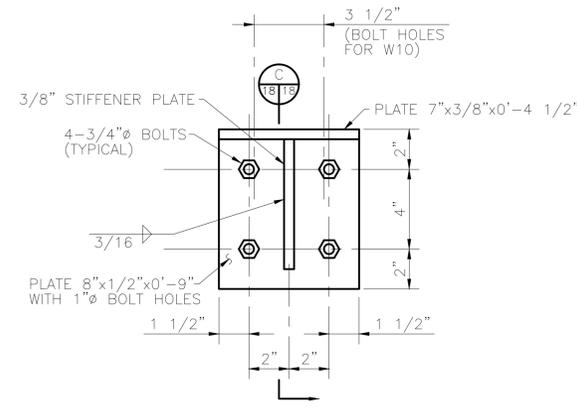


SECTION D
SCALE: 1 1/2" = 1'-0"
0 3' 6' 9' 12'

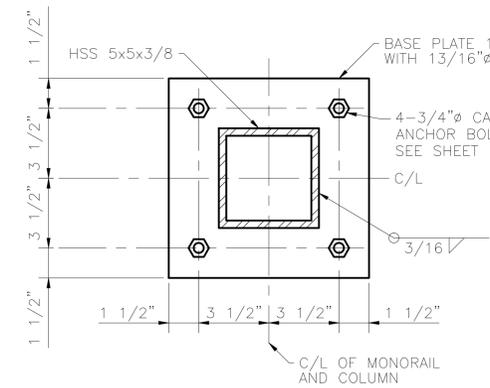


BASE PLATE PLAN
SCALE: 3" = 1'-0"
0 3' 6' 9' 12'

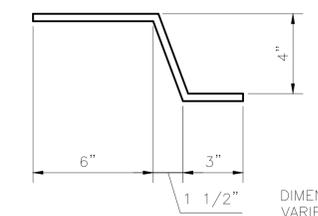

DETAIL 3
SCALE: 3" = 1'-0"
0 1' 2'

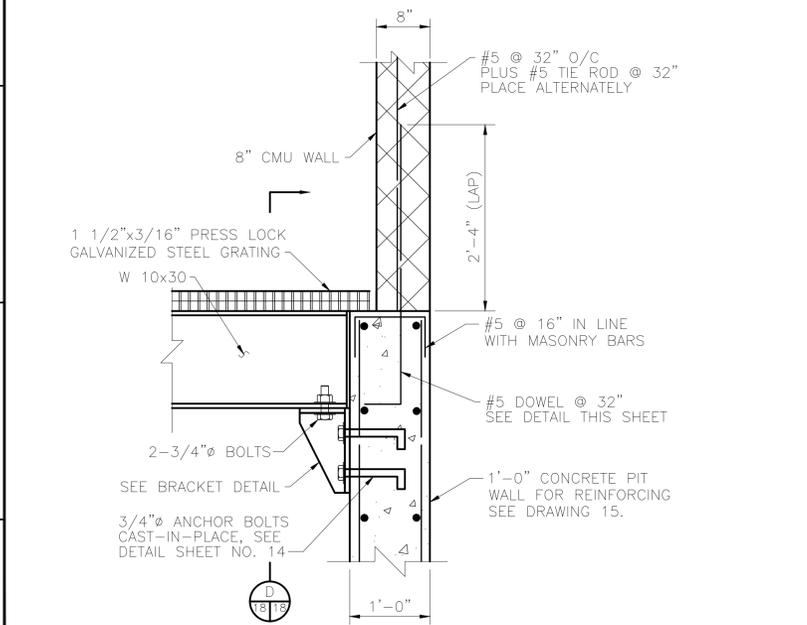


SECTION A
SCALE: 1" = 1'-0"
0 1' 2'

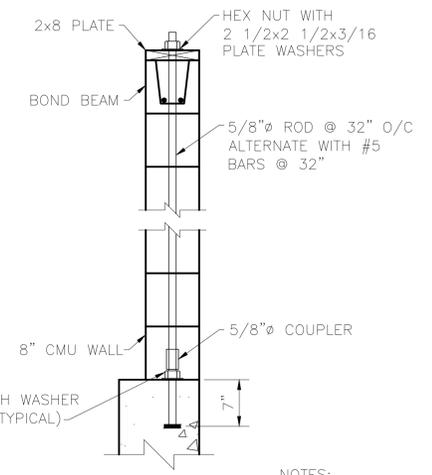

SECTION @ TIE ROD
SCALE: 1" = 1'-0"
0 1' 2'

NOTES:
1.) TIE RODS AND ASSEMBLY SHALL BE MADE BY "TIE MAX" OR EQUAL, ALLOWABLE PULL = 1,998 LBS.
2.) TIE RODS SHALL BE PROVIDED PER MANUFACTURER'S INSTRUCTIONS.

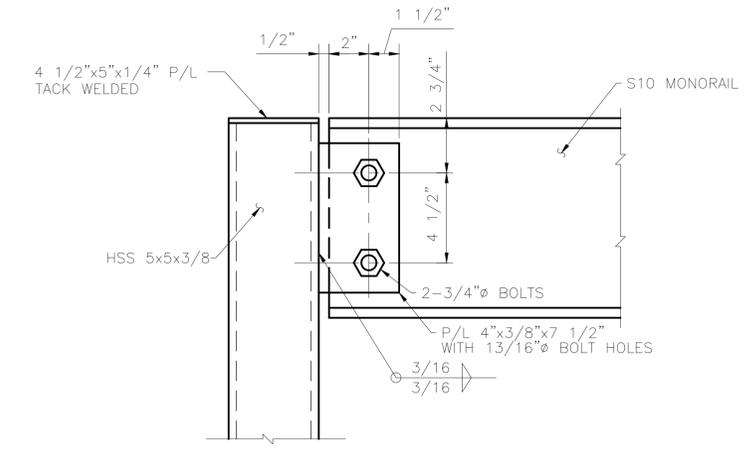

DETAIL 2
SCALE: 3" = 1'-0"
0 3' 6' 9' 12'

NOTE:
THE BOLTS CAN BE CAST-IN-PLACE ANCHORS AS SHOWN ON SHEET NO. 14 OR POST-INSTALLED GALVANIZED EXPANSION ANCHORS WITH MINIMUM 6 3/4" PENETRATION IN CONCRETE.







STRUCTURAL			
REV.	DATE	DESCRIPTION	BY
SEWERAGE AND WATER BOARD OF NEW ORLEANS			
CONTRACT 3668 HURRICANE KATRINA RELATED 404 HAZARD MITIGATION GRANT PROGRAM REPLACEMENT OF VICTORIA SEWAGE PUMPING STATION			
FRAMING SECTION AND DETAILS - 1			
DR: LN			
TRC: --			
CK: MS/AR			GENERAL SUPERINTENDENT
AP: MS			
SCALE: AS SHOWN		DWG. No. 12039-W-63	
DATE: SEPTEMBER 2013	SET NO.		SHEET NO. 18










PRINTED Sep 26, 2013 11:07am FILENAME -- J:\6005.1-(CONFORMED DRAWINGS)\Contract 3668 - Victoria SPS\SH19_VIC_FRAM DET2.dwg

A B C D E F G H J K L M


9
8
7
6
5
4
3
2
1

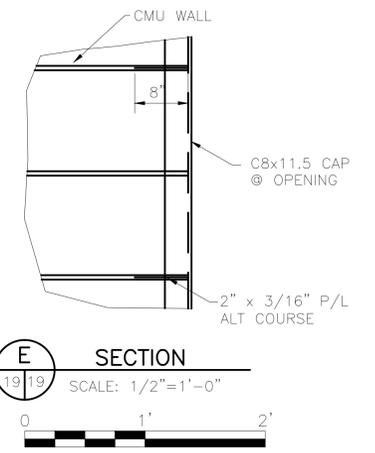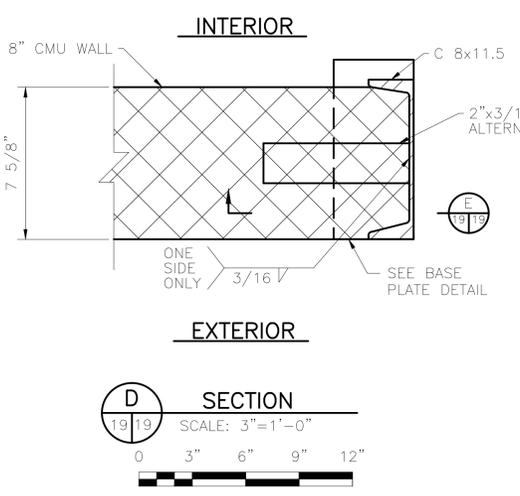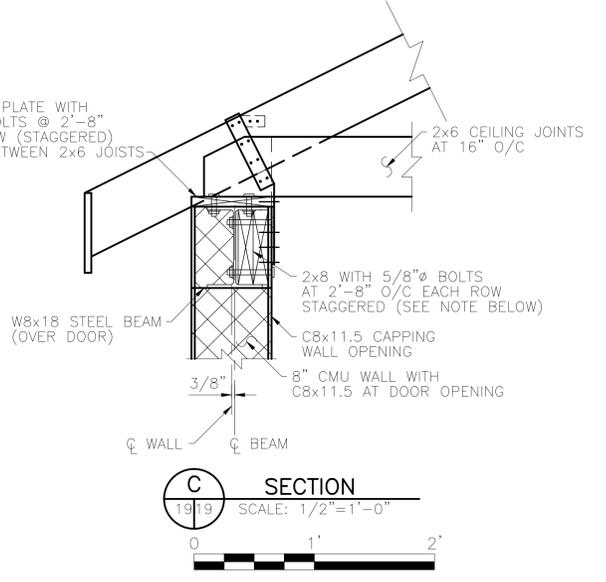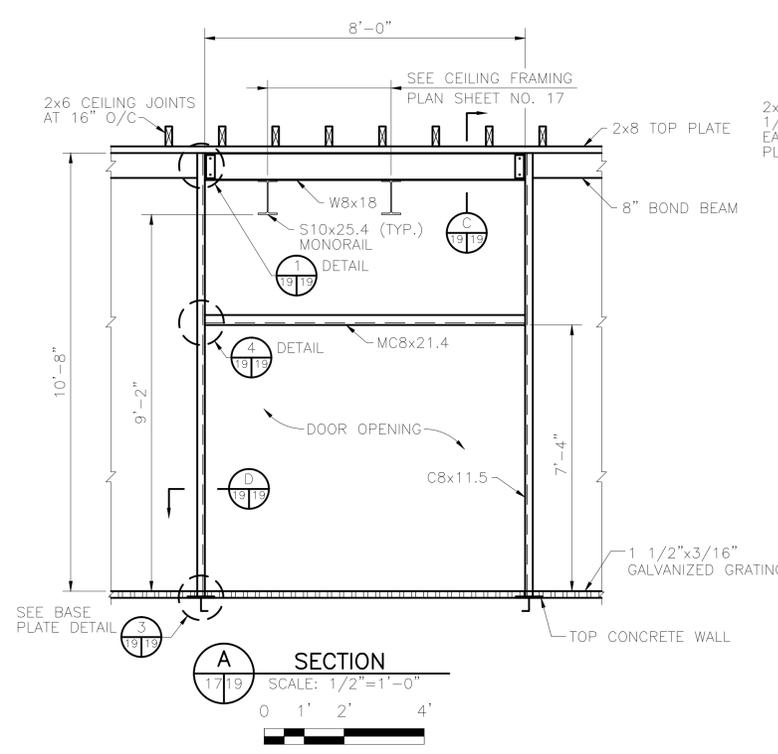

NOTE:
PLACE BOLTS TO LINE UP WITH CEILING JOISTS

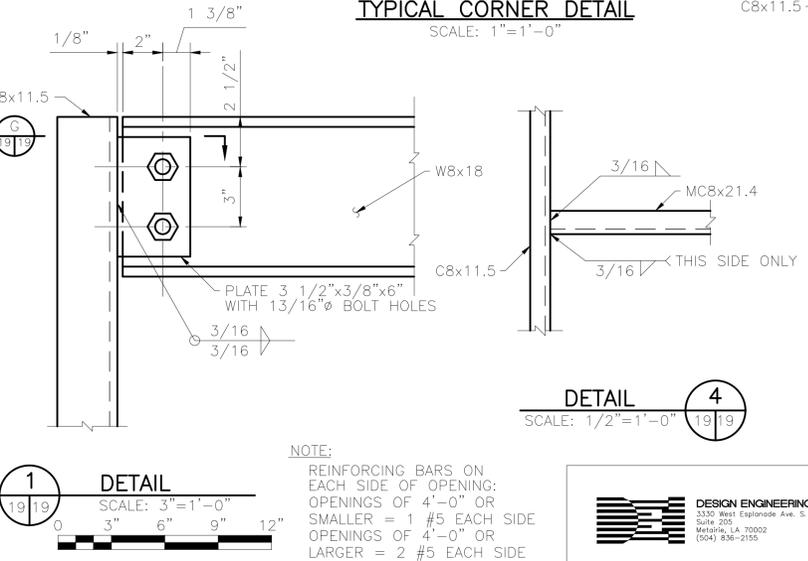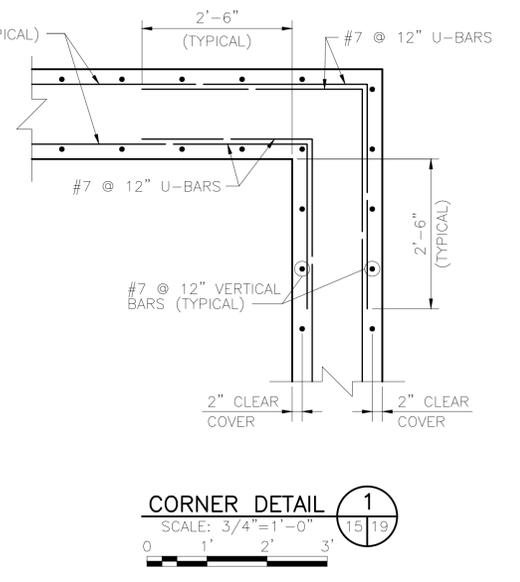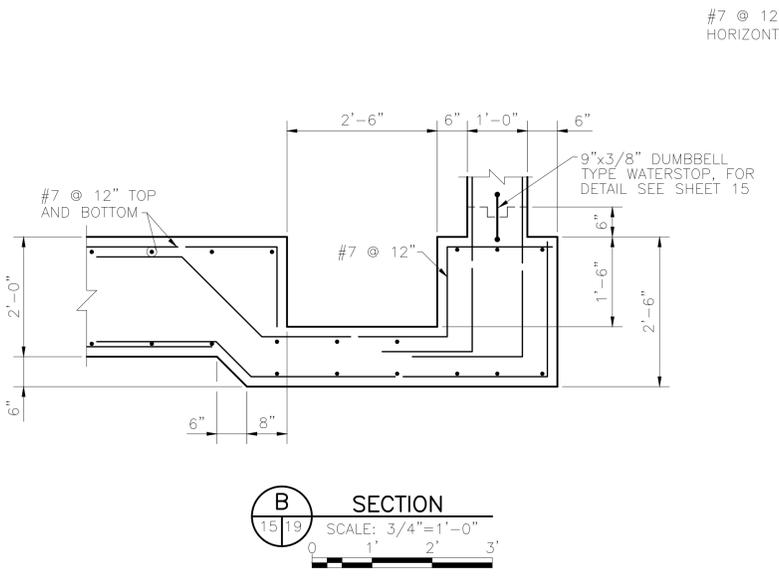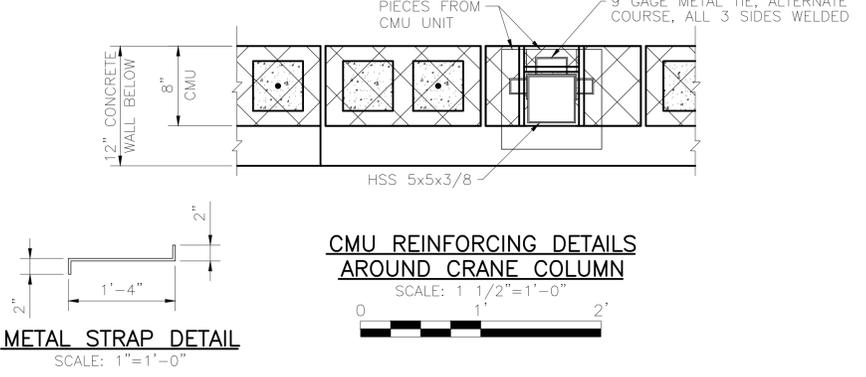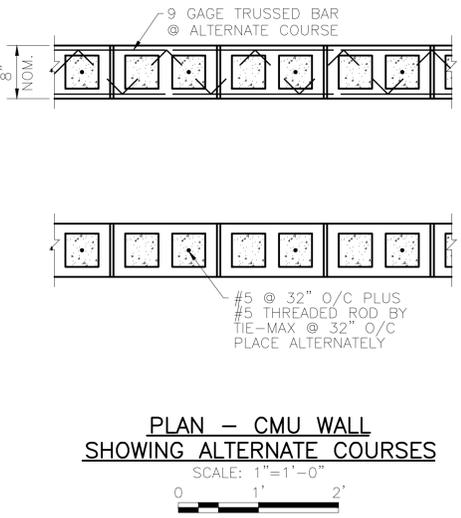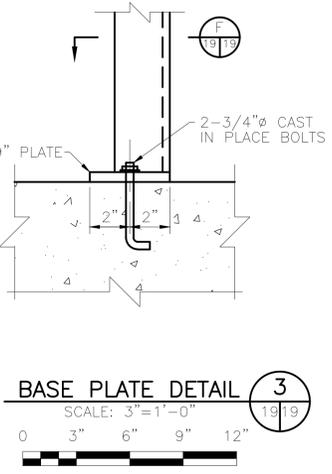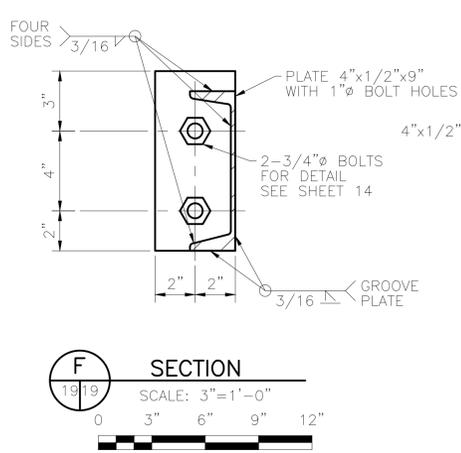











NOTE:
REINFORCING BARS ON EACH SIDE OF OPENING: OPENINGS OF 4'-0" OR SMALLER = 1 #5 EACH SIDE OPENINGS OF 4'-0" OR LARGER = 2 #5 EACH SIDE

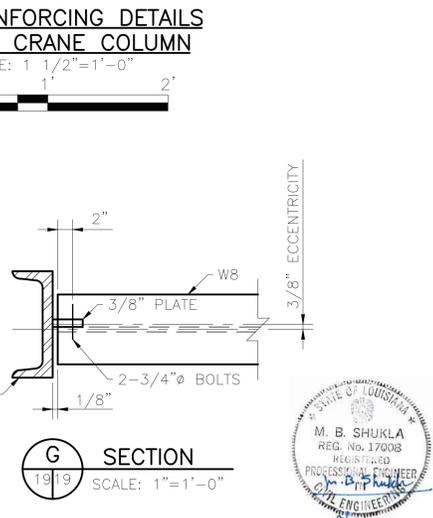

STRUCTURAL			
REV.	DATE	DESCRIPTION	BY
SEWERAGE AND WATER BOARD OF NEW ORLEANS			
CONTRACT 3668 HURRICANE KATRINA RELATED 404 HAZARD MITIGATION GRANT PROGRAM REPLACEMENT OF VICTORIA SEWAGE PUMPING STATION			
FRAMING SECTIONS AND DETAILS - 2			
DR: MZ			
CHK: MS			GENERAL SUPERINTENDENT
AP: MS			
SCALE: AS NOTED		DWG. No. 12039-W-63	
DATE: SEPTEMBER 2013	SET NO.		SHEET NO. 19



PRINTED May 31, 2013 - 9:14am FILENAME - J:\6005.1-COSHEP-2013\Contract 3668 - Victoria SPS_SHT 20_VIC_STAIR_SEC_DET.dwg

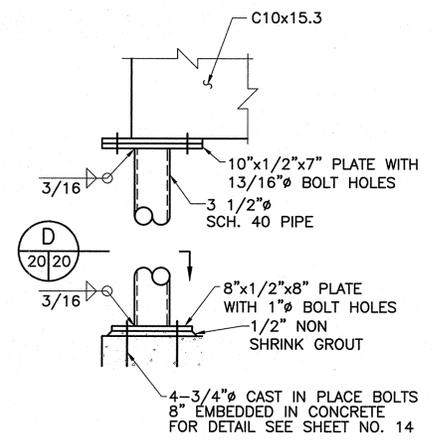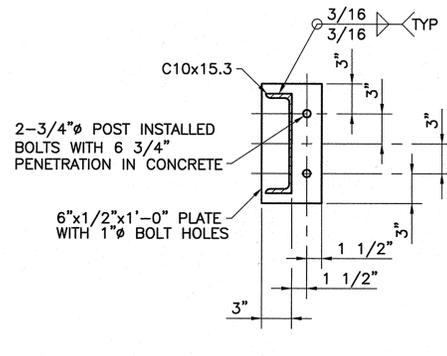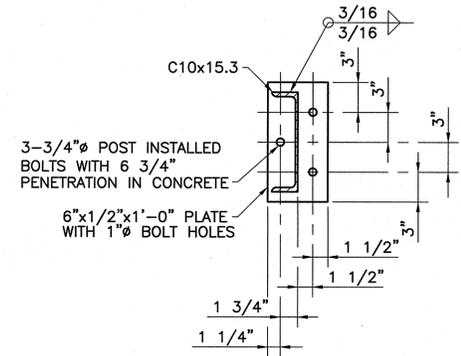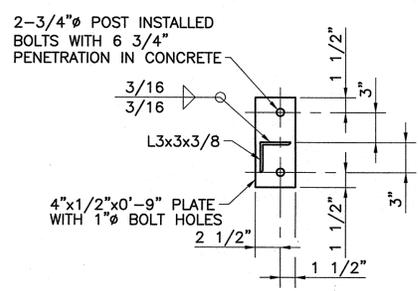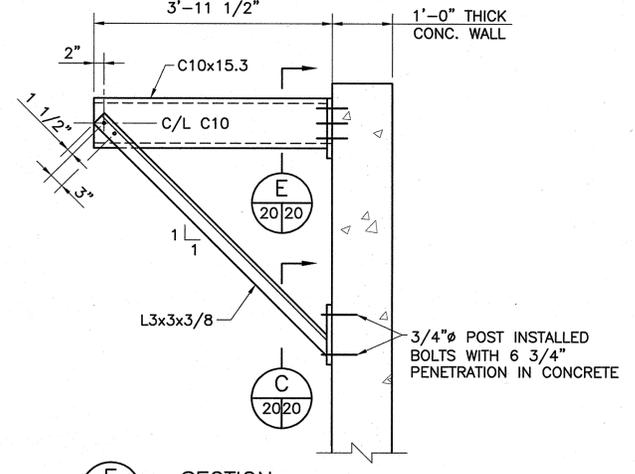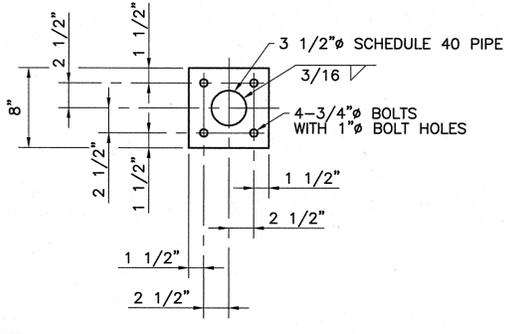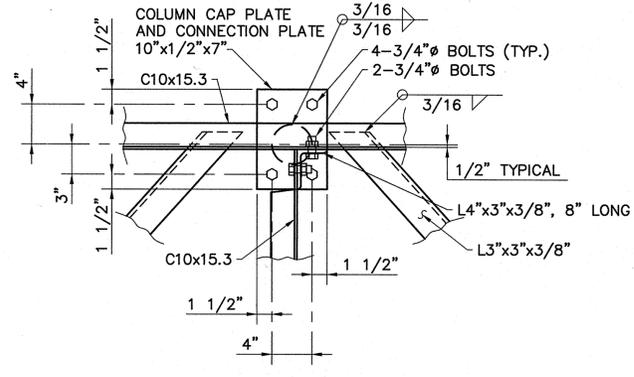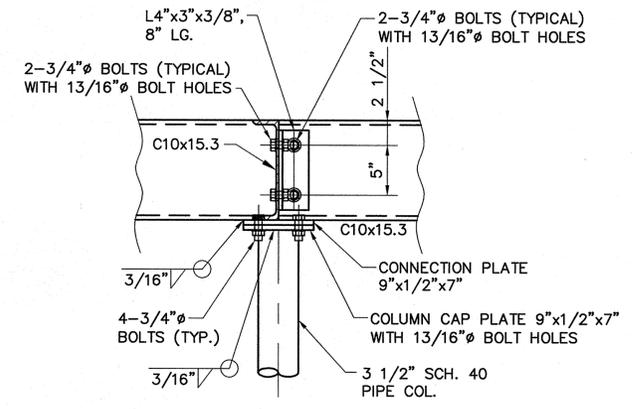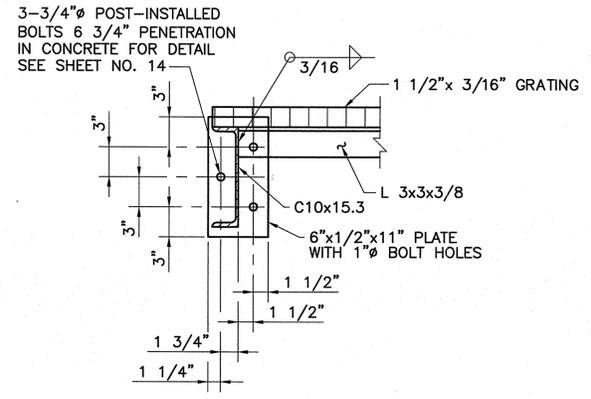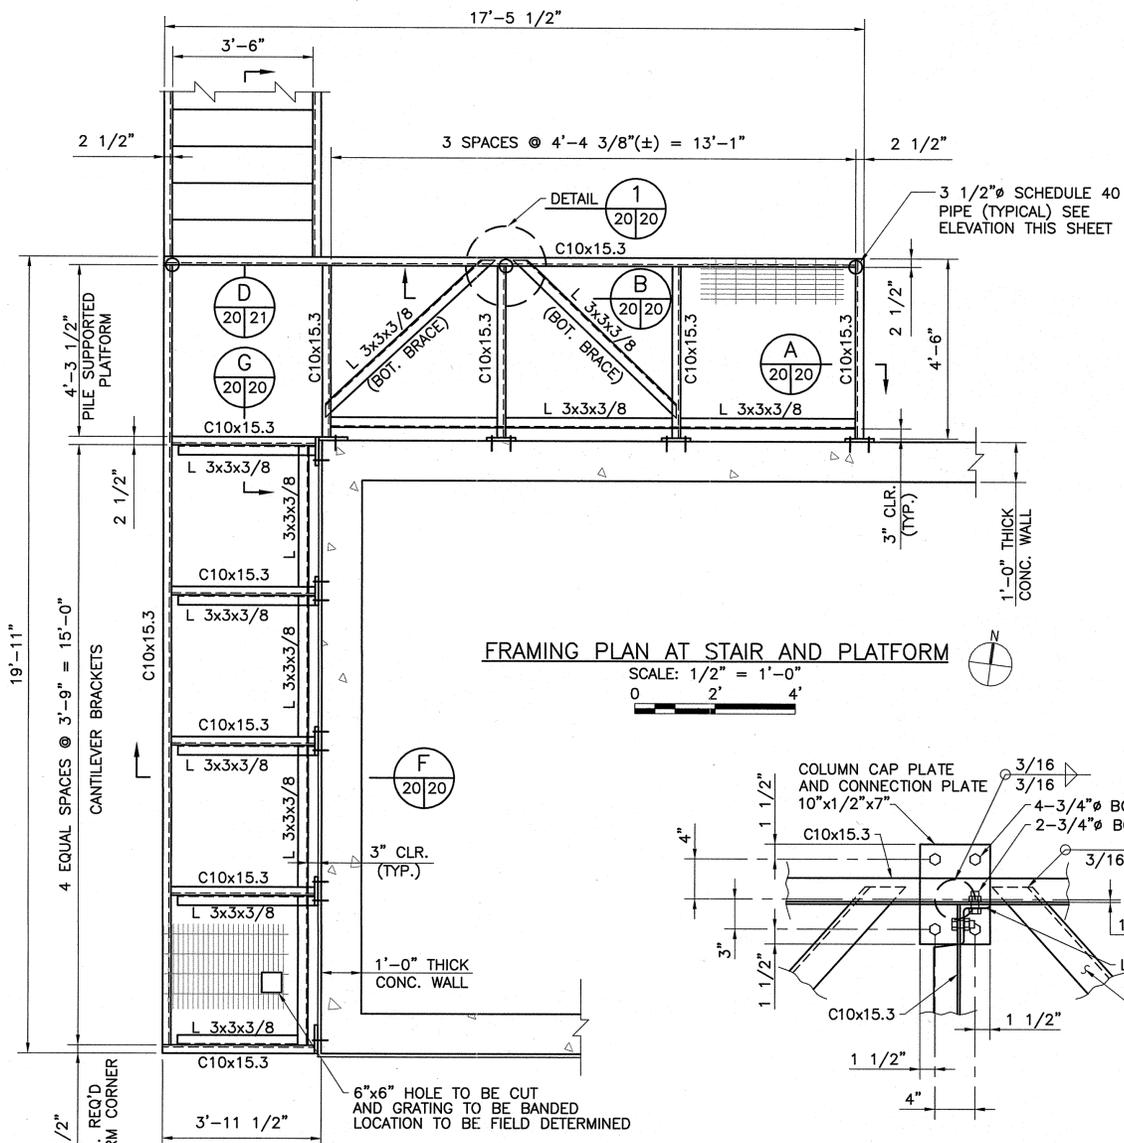

- NOTES:**
- FOR TOP OF SLAB ELEVATION AND GRADING, SEE CIVIL PLANS.
 - ENTIRE FRAME SHALL BE HOT DIPPED GALVANIZED AFTER FABRICATION.
 - FRAME MAY BE SPLIT INTO PIECES FOR GALVANIZING AND TRANSPORTATION REASONS. GALVANIZED PIECES SHALL BE FIELD BOLTED, WELDING IS NOT PERMITTED.

STRUCTURAL

REV.	DATE	DESCRIPTION	BY

SEWERAGE AND WATER BOARD OF NEW ORLEANS


CONTRACT 3668
HURRICANE KATRINA RELATED
404 HAZARD MITIGATION GRANT PROGRAM
REPLACEMENT OF VICTORIA SEWAGE PUMPING STATION

PLATFORM AND STAIR FRAMING PLAN


DR. JT	
TRC. ---	
CK. DS/CW	GENERAL SUPERINTENDENT
AP. MS	
SCALE: AS NOTED	DWG. No. 12039-W-63
DATE: JANUARY 2012	SHEET NO. 20



PRINTED May 31, 2013 - 9:15am FILENAME - J:\6005.1-GOSHEP-2013\Contract 3668 - Victoria SPS\SHT 21_VIC_STAIR_SEC_DET.dwg

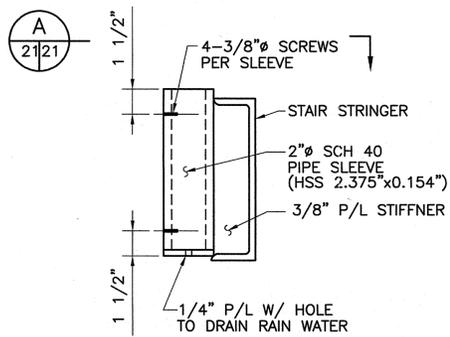


ELEVATION
(HANDRAIL SLEEVE DETAIL)
NOT TO SCALE

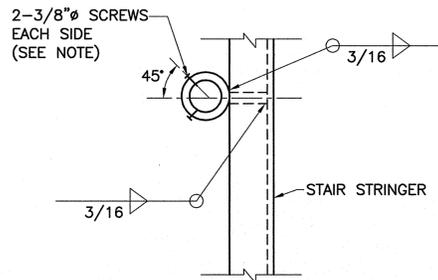


SECTION
A
NOT TO SCALE


NOTE:
SCREW AND SLEEVE SHALL HAVE COMPATIBLE THREADS, IN CONFORMANCE WITH ANSI STANDARDS

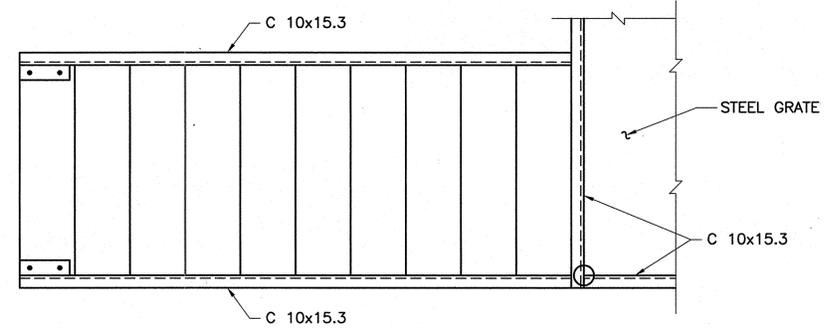


PLAN
SCALE: 3/4" = 1'-0"
0 1' 2' 3'

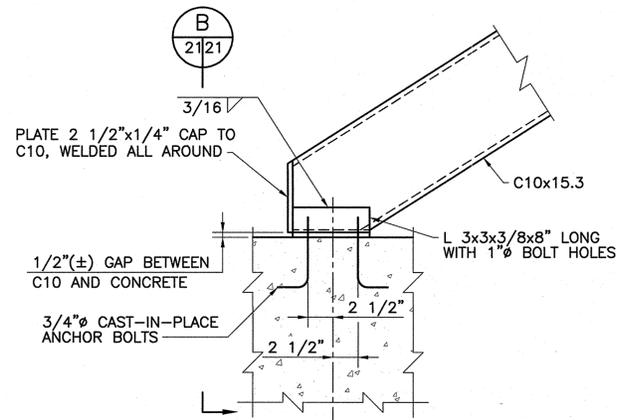


DETAIL
1
SCALE: 1 1/2" = 1'-0"

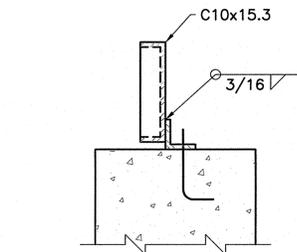

SECTION
B
SCALE: 1 1/2" = 1'-0"

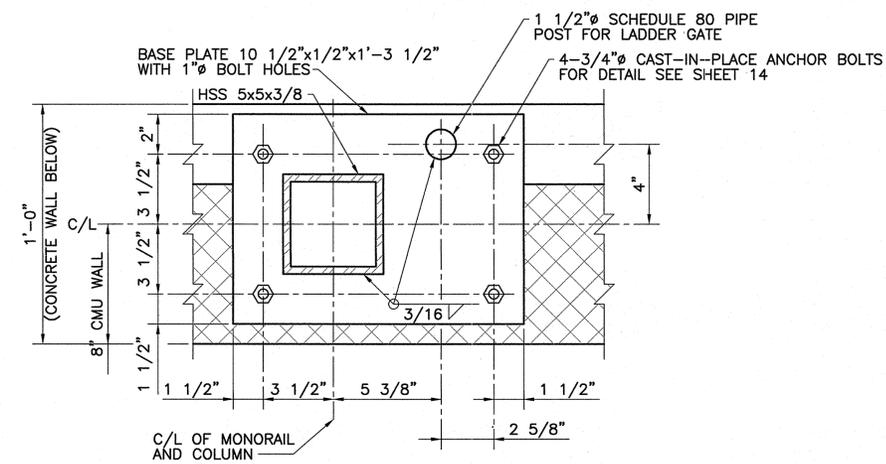

BASE PLATE DETAIL
1
SCALE: 3" = 1'-0"

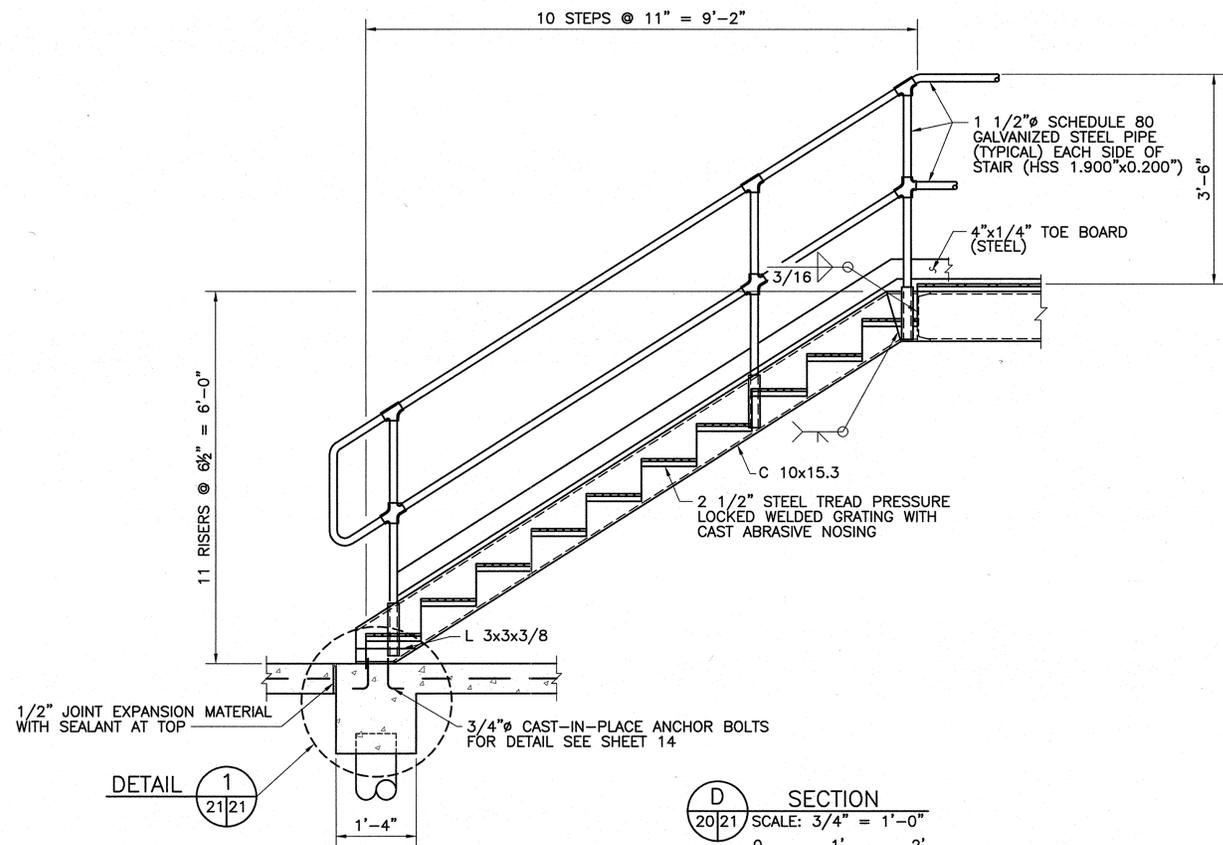

SECTION
D
SCALE: 3/4" = 1'-0"
0 1' 2'


NOTE:
STRUCTURAL DESIGN OF PLATFORM AND STAIR IS PROVIDED FOR BIDDING PURPOSES ONLY. THE CONTRACTOR SHALL SUBMIT FINAL STRUCTURAL DESIGN FOR APPROVAL. DESIGN SHALL BE PERFORMED BY A PROFESSIONAL ENGINEER LICENSED TO PRACTICE IN THE STATE OF LOUISIANA AND EXPERIENCED IN DESIGN OF THIS WORK.



DESIGN ENGINEERING INC.
3330 West Esplanade Ave. S.
Suite 205
Metairie, LA 70002
(504) 838-2158


STRUCTURAL			
REV.	DATE	DESCRIPTION	BY
SEWERAGE AND WATER BOARD OF NEW ORLEANS			
CONTRACT 3668 HURRICANE KATRINA RELATED 404 HAZARD MITIGATION GRANT PROGRAM REPLACEMENT OF VICTORIA SEWAGE PUMPING STATION			
STAIR SECTION AND DETAILS			
DR. LN			
TRC			
CK. MS			GENERAL SUPERINTENDENT
AP. MS			DWG. No. 12039-W-63
SCALE: AS NOTED			
DATE: JANUARY 2012	SET NO.		SHEET NO. 21

PRINTED Sep 26, 2013 11:08am FILENAME - J:\6005.1-(CONFORMED DRAWINGS)\Contract 3668 - Victoria SPS\SH 22_VIC_S-LADDER-DT-01.dwg

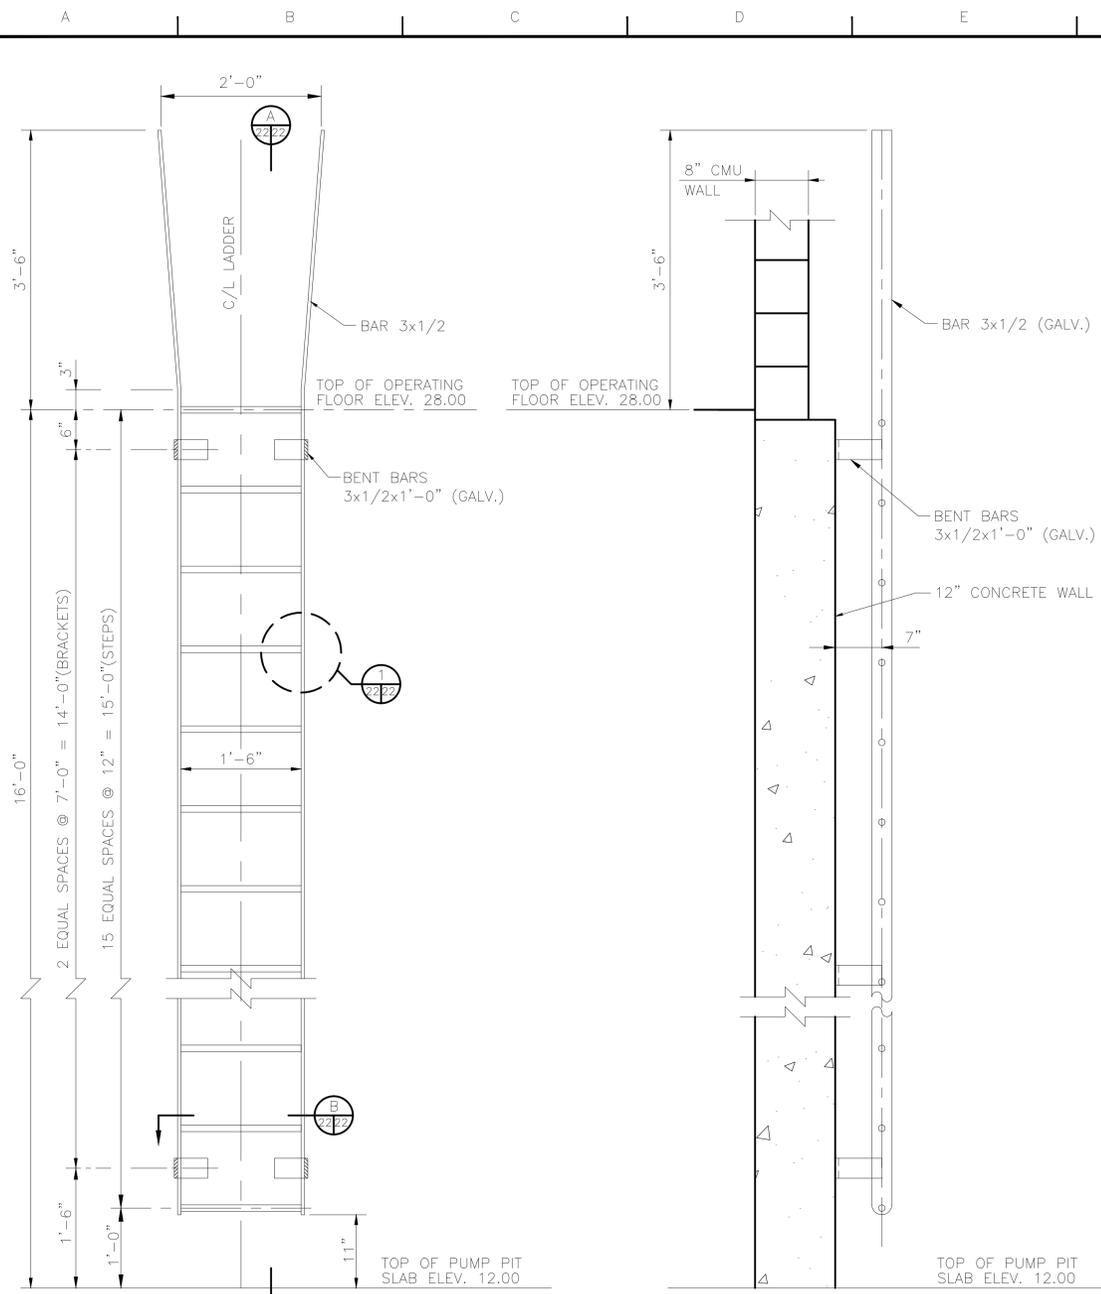


ELEVATION
SCALE: 1" = 1'-0"


A SECTION
SCALE: 1" = 1'-0"

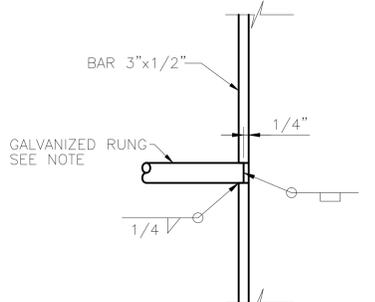


1 DETAIL
SCALE: 3" = 1'-0"

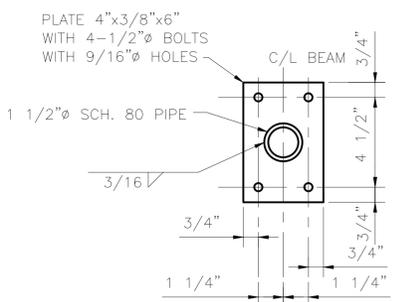


2 DETAIL
SCALE: 3" = 1'-0"

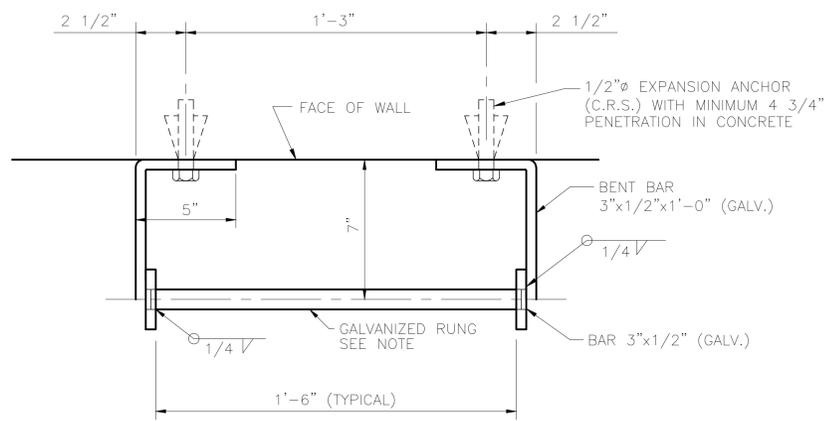


B SECTION
SCALE: 3" = 1'-0"

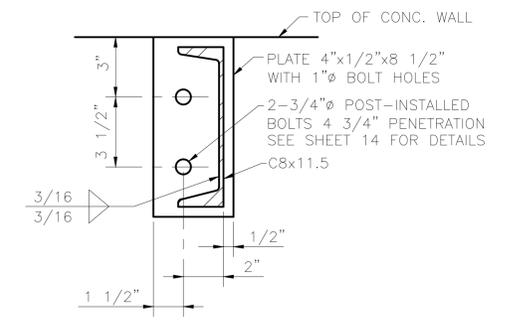


D SECTION
SCALE: 3" = 1'-0"

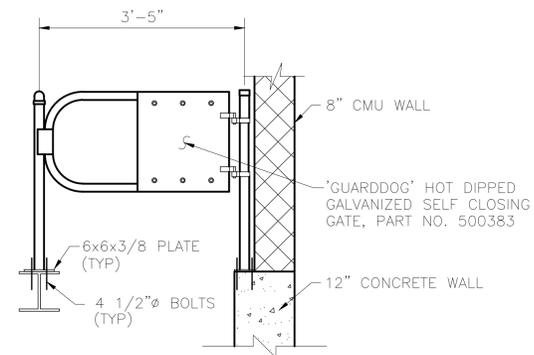

C VIEW
SCALE: 3/4" = 1'-0"

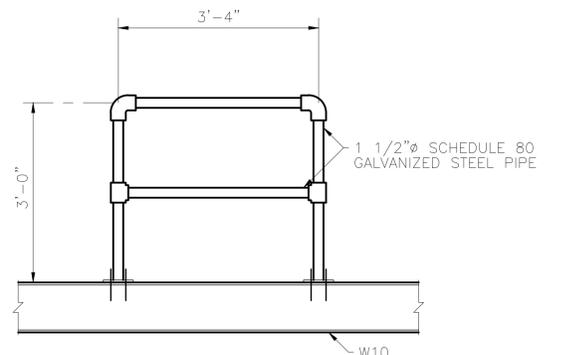

E VIEW
SCALE: 3/4" = 1'-0"

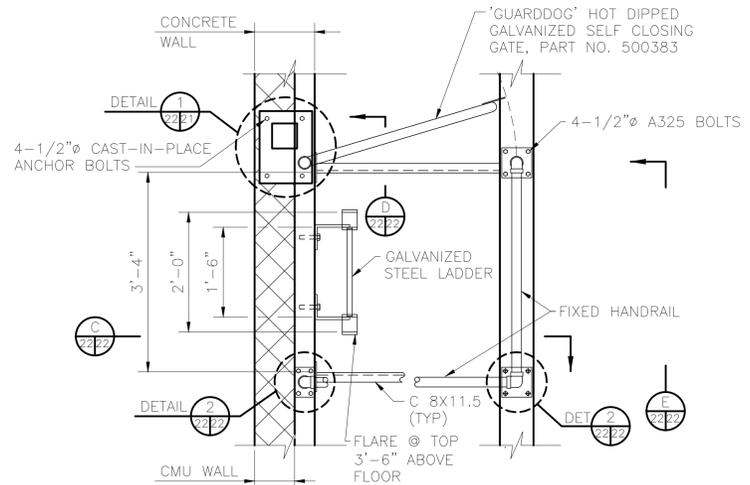

PLAN @ ACCESS LADDER
SCALE: 3/4" = 1'-0"

- NOTES:**
- 1.) STEEL PLATES AND SHAPES SHALL CONFORM TO ASTM A36.
 - 2.) STEPS SHALL BE SLIP RESISTANT.
 - 3.) RUNG SHALL HAVE NON SLIP SURFACE WITH 1" WIDE STRIATED TOP, 1 1/4" DEEP AND SEMICIRCULAR BOTTOM.

STRUCTURAL

REV.	DATE	DESCRIPTION	BY
SEWERAGE AND WATER BOARD OF NEW ORLEANS			
CONTRACT 3668 HURRICANE KATRINA RELATED 404 HAZARD MITIGATION GRANT PROGRAM REPLACEMENT OF VICTORIA SEWAGE PUMPING STATION			
LADDER DETAILS			
DR. LN			
TBC. --			
CK. MS/AR			GENERAL SUPERINTENDENT
AP. MS			
SCALE: AS SHOWN		DWG. No. 12039-W-63	
DATE: SEPTEMBER 2013	SET NO.		SHEET NO. 22



DESIGN ENGINEERING INC.
3330 West Esplanade Ave. S.
Suite 205
Metairie, LA 70002
(504) 836-2155





PRINTED May 31, 2013 - 9:17am FILENAME - J:\6005.1-GOSHEP-2013\Contract 3668 - Victoria SPS\SH-23_VIC_STRUC DT 02.dwg

A B C D E F G H J K L M

9
8
7
6
5
4
3
2
1

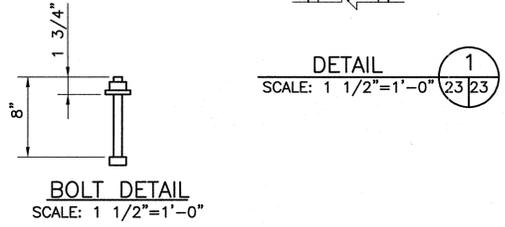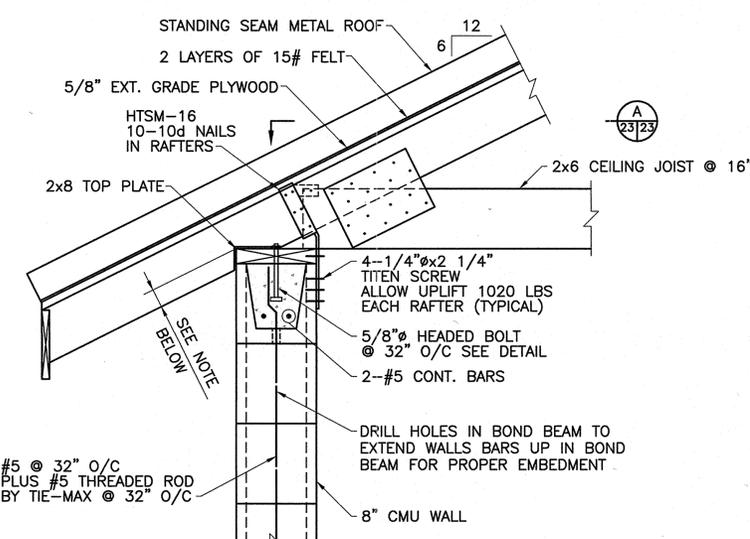


NOTE:
THE DEPTH OF THE NOTCH SHALL BE LIMITED TO 1/3 OF DEPTH OF THE MEMBER

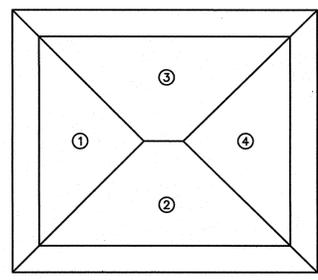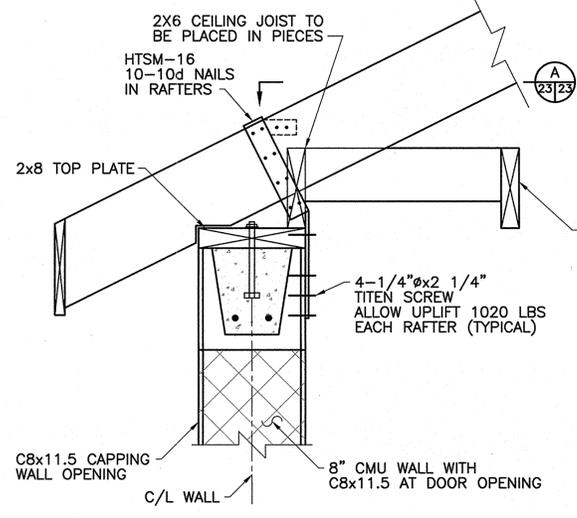


WIND DIRECTION	ZONE 1	ZONE 2	ZONE 3	ZONE 4	OVERHANG
A	-17.91	-38.36	-22.94	-17.91	-48.00
B	10.00	10.00	10.00	10.00	--
B	-17.91	-20.42	-38.04	-17.91	-48.00
A	10.00	10.00	10.00	10.00	--

KEY PLAN
ROOF WIND PRESSURES
(USING ANALYTICAL METHOD)

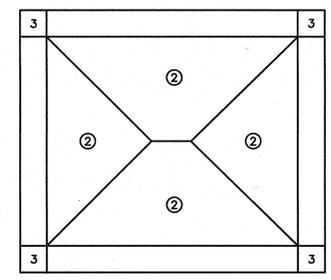


WIND DIRECTION	ZONE 2	ZONE 3
A AND B	-70.52	-79.40
A AND B	14.22	14.22


NOTE:
1.) AREA UNDER ZONE 1 WAS SMALL SO IT WAS ASSUMED TO BE SAME AS ZONE 2.
1.) NEGATIVE PRESSURE INDICATES UPLIFT AND POSITIVE PRESSURE INDICATES DOWNWARD PRESSURE. MINIMUM PRESSURE IS 10 PSF.

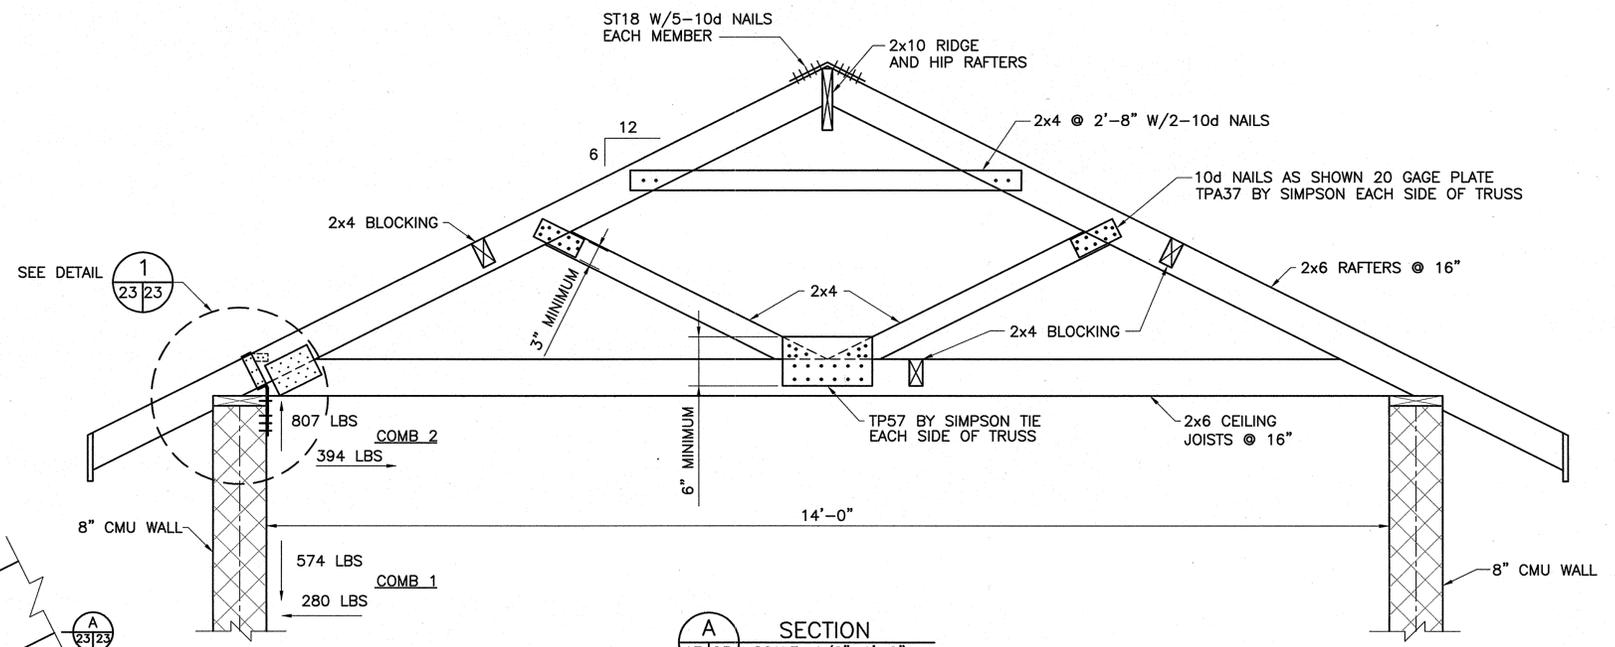

COMB 1 DEAD LOAD PLUS WIND
COMB 2 0.6 DEAD LOAD MINUS WIND

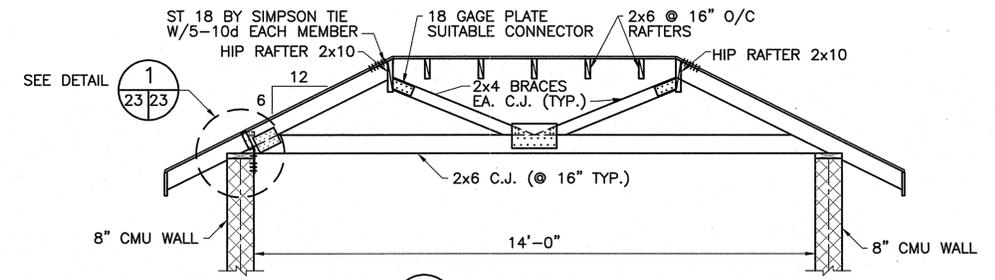

NOTE:
ANGLE A21 CONNECTOR CAN BE PLACED WITHIN 2" FROM CENTERLINE ON EITHER SIDE

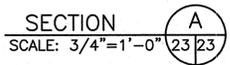

NOTE:
THE NAIL REFERENCE ABOVE ARE TO COMMON NAILS. IF SINKER NAILS ARE USED, FOLLOWING CONVERSION SHALL BE USED.
6d COMMON - 8d SINKER
8d COMMON - 12d SINKER
10d COMMON - 16d SINKER
16d COMMON - 20d SINKER

ALL THE HARDWARE SPECIFIED ARE FROM SIMPSON STRONG TIE CATALOGS. THE CONTRACTOR MAY USE EQUAL OR STRONGER UPON APPROVAL FROM S&WB.

NOTE:
ALL RAFTERS AND CEILING JOISTS REQUIRE BLOCKING AT MAXIMUM SPACING OF 10'-0". BLOCKING SHALL BE A MINIMUM 2x4 TIMBER NAILED USING 2-10d NAILS.
TRUSS PLATES SHALL BE OF GALVANIZED SHEET STEEL 20 GAGE THICK CONFORMING TO ASTM A446, GRADE A WITH GALVANIZED COATING PER ASTM A-525, LOADING DESIGNATION G60 OR APPROVED EQUAL. THE PLATES SHALL BE SUPPLIED WITH HOLES.
ALL TIMBER SHALL BE PRECISELY CUT TO HAVE FULL BEARING TO CONNECTING MEMBER.



DESIGN ENGINEERING INC.
3310 West Esplanade, Ave. 2,
Suite 205
Metairie, LA 70002
(504) 836-2155

REV.	DATE	DESCRIPTION	BY

STRUCTURAL


SEWERAGE AND WATER BOARD
OF NEW ORLEANS

CONTRACT 3668
HURRICANE KATRINA RELATED
404 HAZARD MITIGATION GRANT PROGRAM
REPLACEMENT OF VICTORIA SEWAGE PUMPING STATION


ROOF SECTION AND DETAILS

DR. MZ	
TRC. --	
CK. MS/AR	
AP. MS	
SCALE: AS SHOWN	DWG. No. 12039-W-63
DATE: JANUARY 2012	SET NO. SHEET NO. 23

PRINTED May 31, 2013 - 9:18am FILENAME - J:\6005.1-GOSHEP-2013\Contract 3668 - Victoria SPS\SHT 24_VIC_PILE_DET.dwg

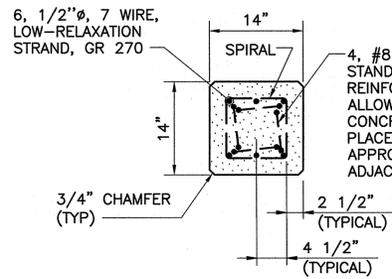


4, #8 STANDARD 180° HOOK ON REINFORCING FOR ALL PILES. TO ALLOW FOR PROPER PLACEMENT OF CONCRETE, HOOKS SHOULD BE PLACED SO THAT BEND OF HOOK IS APPROXIMATELY PARALLEL TO ADJACENT FACE OF PILE AS SHOWN.

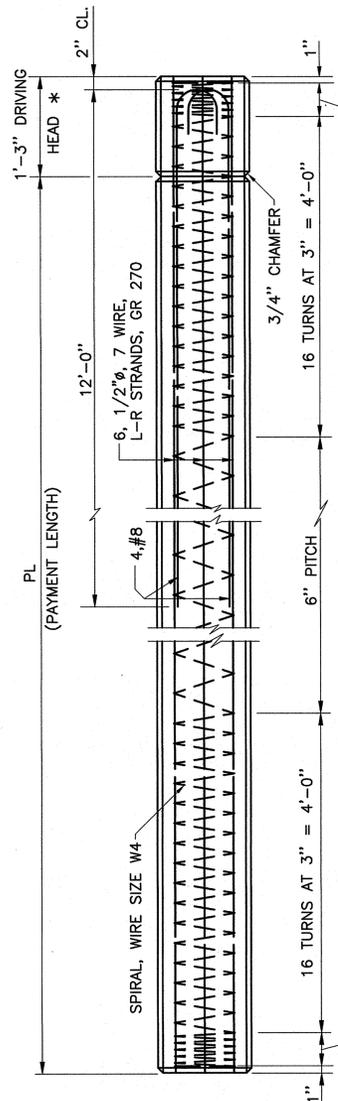


NOTE: GRIND PRESTRESSED STRANDS FLUSH WITH PILE HEAD AND PILE TIP.

14" X 14" PRESTRESSED PRECAST CONCRETE PILE
SCALE: N.T.S.


* DRIVING HEAD CONCRETE, STRANDS AND SPIRAL TIES TO BE REMOVED AFTER DRIVING TO EXPOSE HOOKS. (NO PAYMENT)

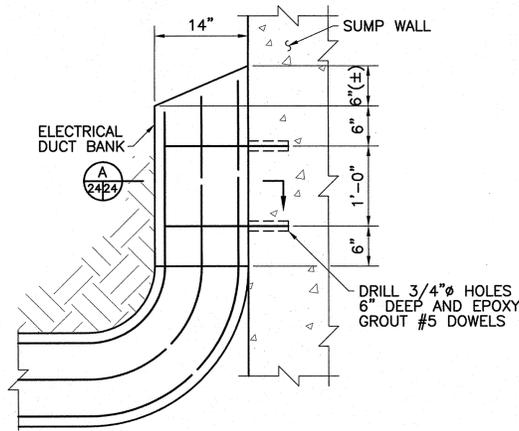


CONCRETE ELECTRICAL DUCT BANK
SCALE: 1" = 1'-0"

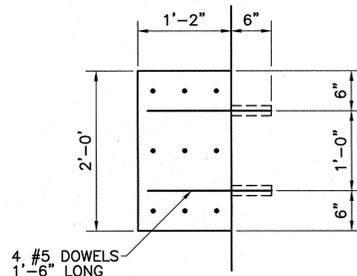


SECTION 2424 SCALE: 1" = 1'-0"

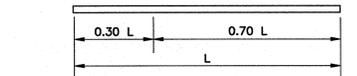

1 POINT PICKUP (L < 58') 14" X 14" PILE
1 POINT PICKUP (L < 60') 16" X 16" PILE

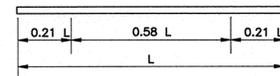


2 POINT PICKUP (L < 83') 14" X 14" PILE
2 POINT PICKUP (L < 86') 16" X 16" PILE

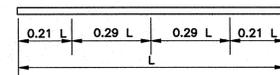

3 POINT PICKUP (L < 130') 14" X 14" PILE
3 POINT PICKUP (L < 136') 16" X 16" PILE


NOTES

- PICKUP POINTS TO BE PLAINLY MARKED ON PILES.
- PICKUP POINTS SHOWN ARE BASED ON 5000 PSI CONCRETE STRENGTH.
- 4-#8 HOOKED BARS REQUIRED ONLY FOR TENSION ANCHOR PILES.
- PILE LENGTHS SHOWN ARE FINAL.
- A FACTOR OF SAFETY OF 3.0 IS USED TO DETERMINE PILE LENGTH.
- CONTRACTOR SHALL PROBE AT PILE LOCATIONS TO ENSURE THERE ARE NO SUBSURFACE OBSTACLES.
- PILE DRIVING STRESSES SHALL NOT EXCEED FOLLOWING:
COMPRESSION: 0.85 x CONCRETE STRENGTH - EFFECTIVE PRESTRESS
TENSION: EFFECTIVE PRESTRESS
EFFECTIVE PRESTRESS CAN BE TAKEN EQUAL TO 800 PSI

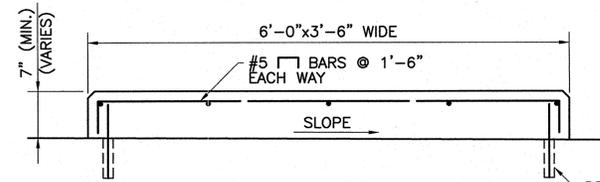


CONCRETE PUMP PEDESTAL
SCALE: 1" = 1'-0"


DRILL 3/4" Ø 6" DEEP HOLES AND EPOXY GROUT 11" LONG #5 DOWELS @ 1'-6" O/C AROUND PERIPHERY

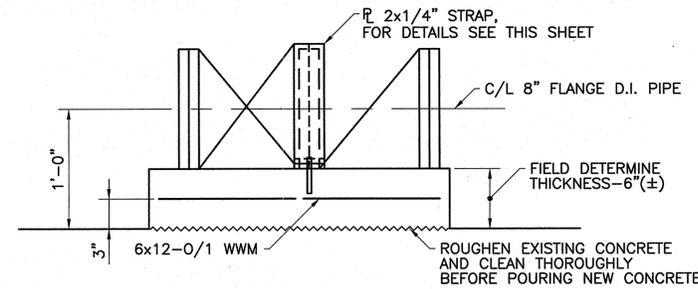

CONCRETE VALVE PEDESTAL
SCALE: 1" = 1'-0"

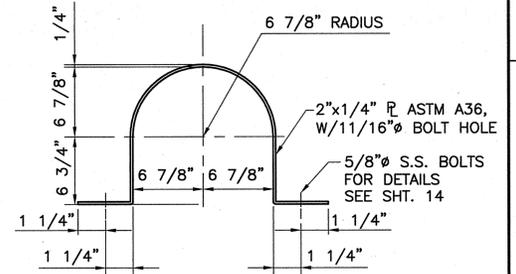

STRAP DETAIL
SCALE: 1 1/2" = 1'-0"

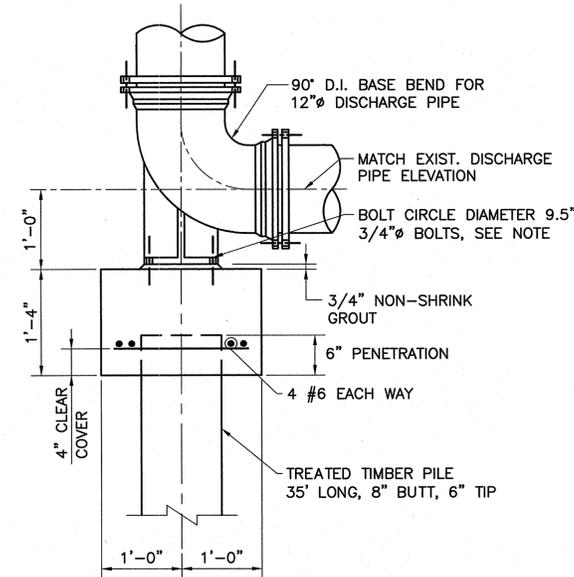

DISCHARGE PIPE SUPPORT
SCALE: 1" = 1'-0"

NOTE:

- 3/4" Ø BOLTS FOR THRUST BLOCK SHALL BE CAST-IN-PLACE STAINLESS STEEL BOLTS PER ASTM F-1554, 55 ksi AS DETAILED ON SHEET 14.
- NEOPRENE WASHERS FOR STAINLESS STEEL BOLTS SHALL BE USED TO SEPARATE TWO METALS TO STOP GALVANIC ACTION.

DESCRIPTION	PILE TYPE AND SIZE	PILE TIP ELEVATION	PAYMENT LENGTH IN FEET
PUMP PIT	PRESTRESSED PRECAST CONCRETE PILE 14"x14"	(-)29.75	40.00'
PLATFORM STAIR AND DISCHARGE PIPE SUPPORT	TIMBER TREATED PILE 8" Ø BUTT 6" Ø TIP	(-)14.17	35.00'


STRUCTURAL

REV.	DATE	DESCRIPTION	BY
SEWERAGE AND WATER BOARD OF NEW ORLEANS			
CONTRACT 3668 HURRICANE KATRINA RELATED 404 HAZARD MITIGATION GRANT PROGRAM REPLACEMENT OF VICTORIA SEWAGE PUMPING STATION			
PPC PILE AND MISCELLANEOUS DETAILS			
DR. M.Z.			
TRC			
CK. MS			
AP. MS			
SCALE: AS NOTED		DWG. No. 12039-W-63	
DATE: JANUARY 2012	SET NO.	SHEET NO. 24	




DESIGN ENGINEERING INC.
3330 West Esplanade Ave. S.
Suite 205
Metairie, LA 70002
(504) 835-2155


A B C D E F G H J K L M

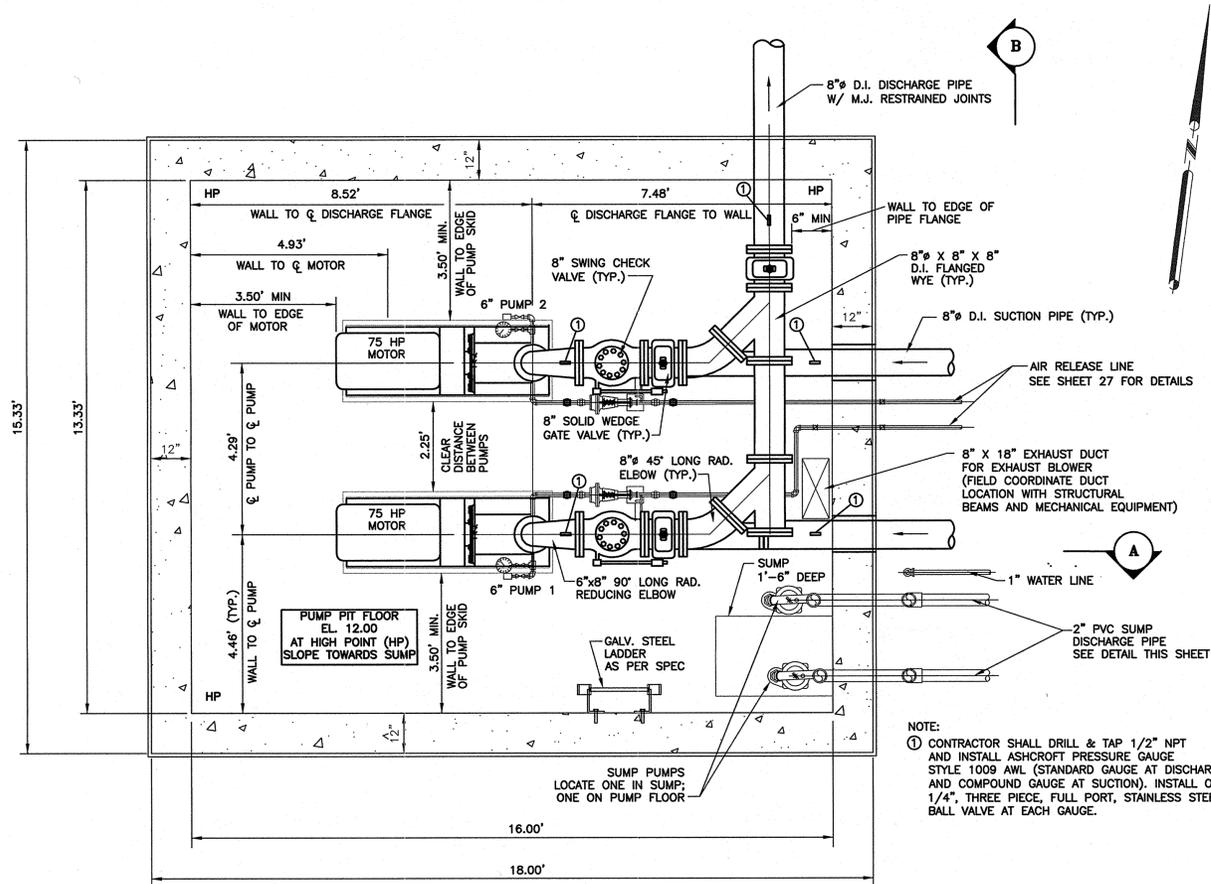


MECHANICAL EQUIPMENT LAYOUT PLAN
SCALE: 1/2" = 1'-0"

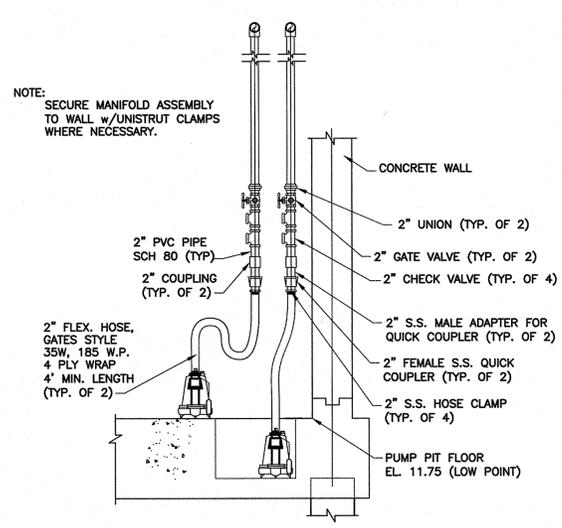


SUMP PUMP PIPING DETAIL
SCALE: 1/2" = 1'-0"

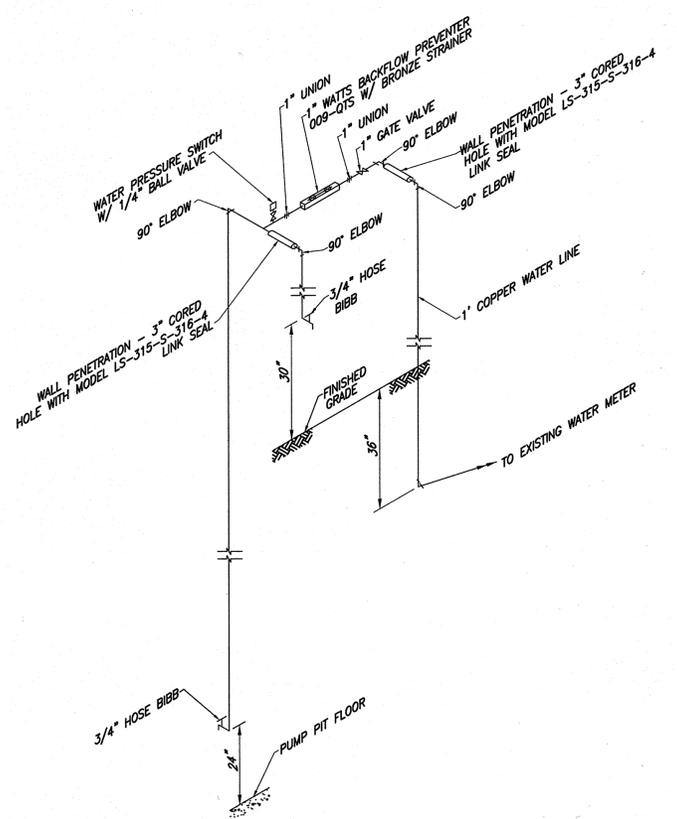

DOMESTIC WATER RISER DETAIL
N.T.S.

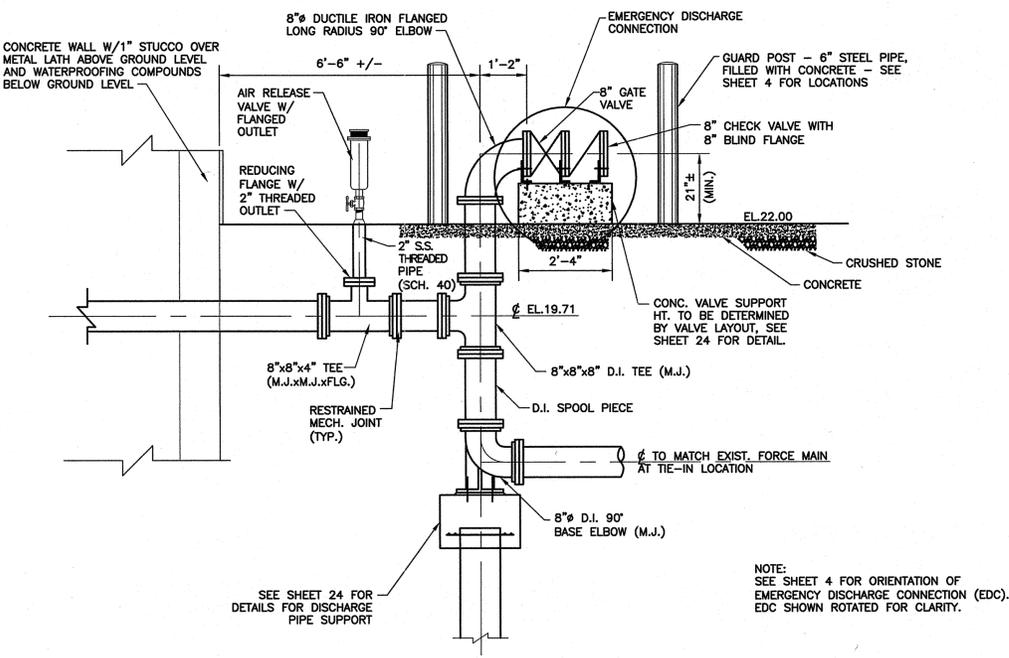

DISCHARGE PIPE
SCALE: 1/2" = 1'-0"

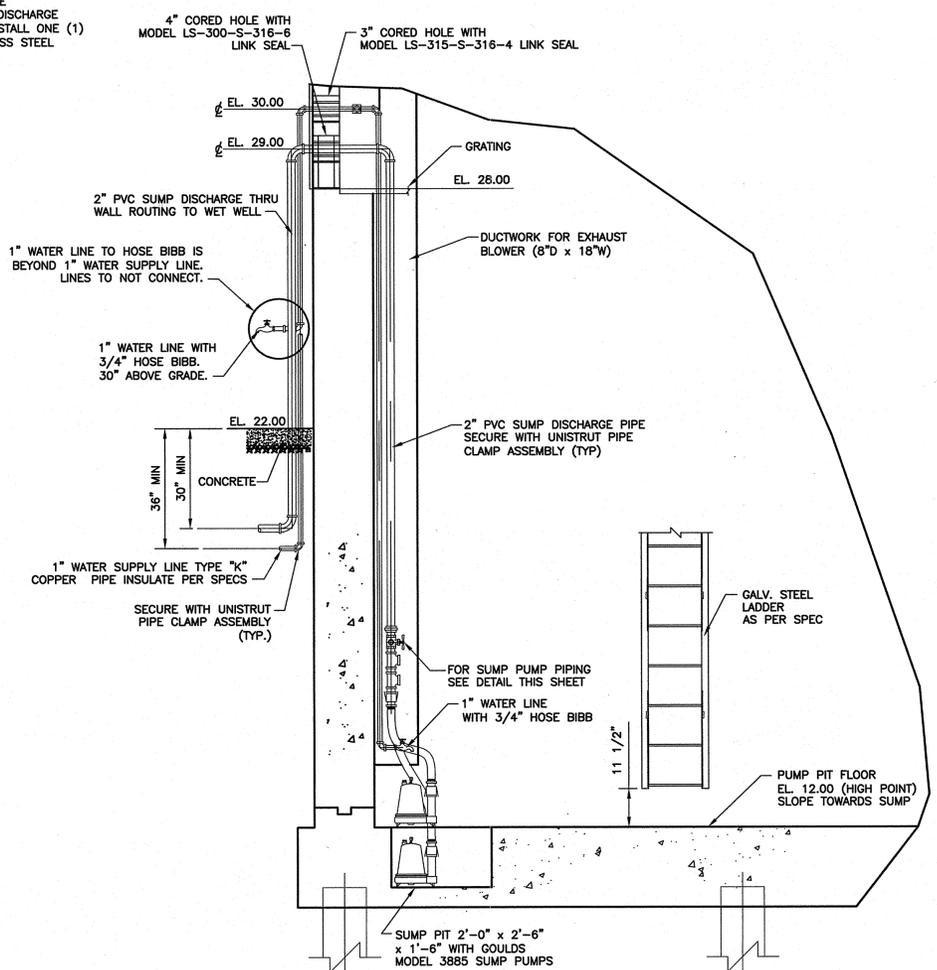

SECTION A
SCALE: 1/2" = 1'-0"



REV.	DATE	DESCRIPTION	BY

MECHANICAL

SEWERAGE AND WATER BOARD OF NEW ORLEANS

CONTRACT 3688

HURRICANE KATRINA RELATED

404 HAZARD MITIGATION GRANT PROGRAM



REPLACEMENT OF VICTORIA SEWAGE PUMPING STATION

MECHANICAL EQUIPMENT LAYOUT PLAN

DR. TH/BD	
TRC. --	
CK. DS/CW	GENERAL SUPERINTENDENT
AP. JH	DWG. No. 12039-W-63
SCALE AS SHOWN	DATE: JANUARY 2012
	SHEET NO. 25



PRINTED May 31, 2013 9:23am FILENAME - J:\6005.1-GOSHEP-2013\Contract 3668 - Victoria SPS\SHT 26_VIC_XSEC THRU STA & WW.dwg

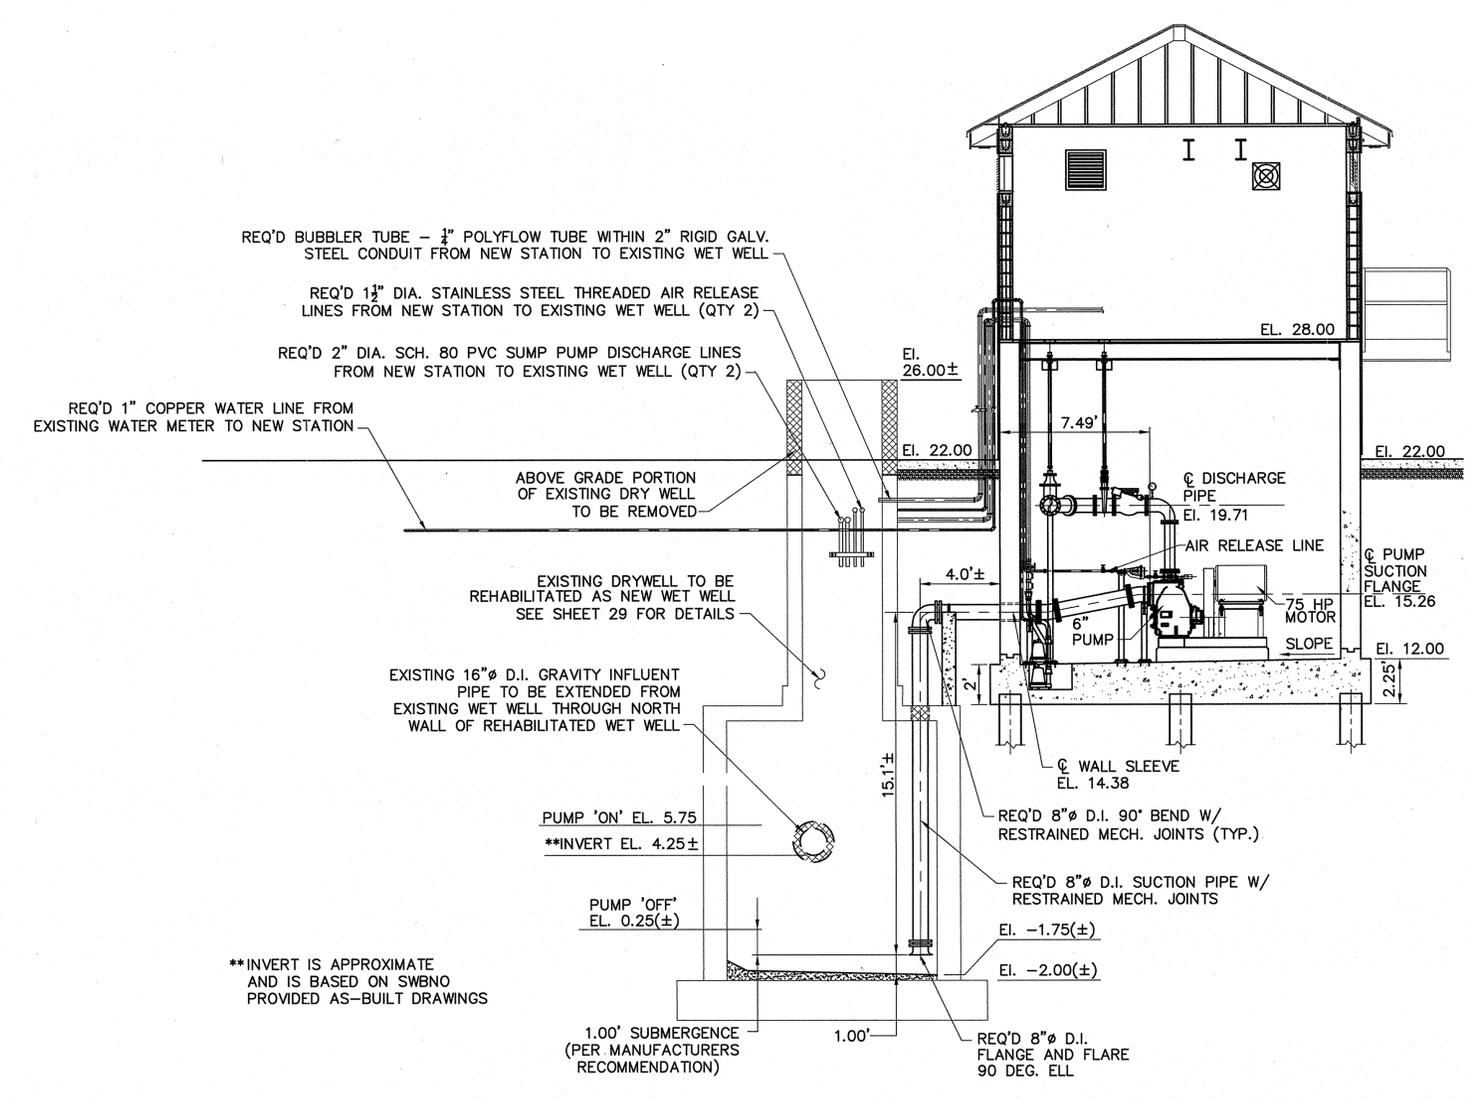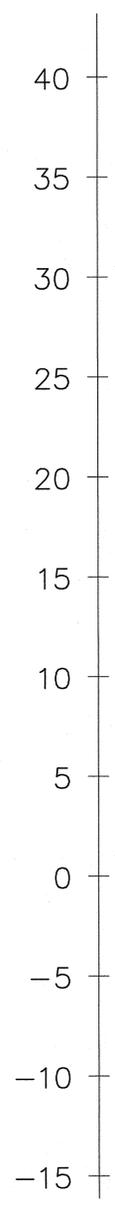


VICTORIA
 A
 4 26
 PUMP STATION CROSS SECTION (LOOKING SOUTH)
 SCALE: 1/4" = 1'-0"
 0 4' 8'




MECHANICAL			
REV.	DATE	DESCRIPTION	BY
SEWERAGE AND WATER BOARD OF NEW ORLEANS			
CONTRACT 3668 HURRICANE KATRINA RELATED 404 HAZARD MITIGATION GRANT PROGRAM REPLACEMENT OF VICTORIA SEWAGE PUMPING STATION			
PIPING CROSS SECTION THROUGH STATION AND WET WELL			
DR. TH/BD	GENERAL SUPERINTENDENT		
TRC. —			
CK. DS/CW			
AP. JH	DWG. No. 12039-W-63		
SCALE: AS SHOWN			
DATE: JANUARY 2012	SET NO.	SHEET NO. 26	






PRINTED Sep 26, 2013 11:05am FILENAME - J:\6005.1-(CONFORMED DRAWINGS)\Contract 3668 - Victoria SPS\SH28_VIC_XSEC THRU STA & DET.dwg

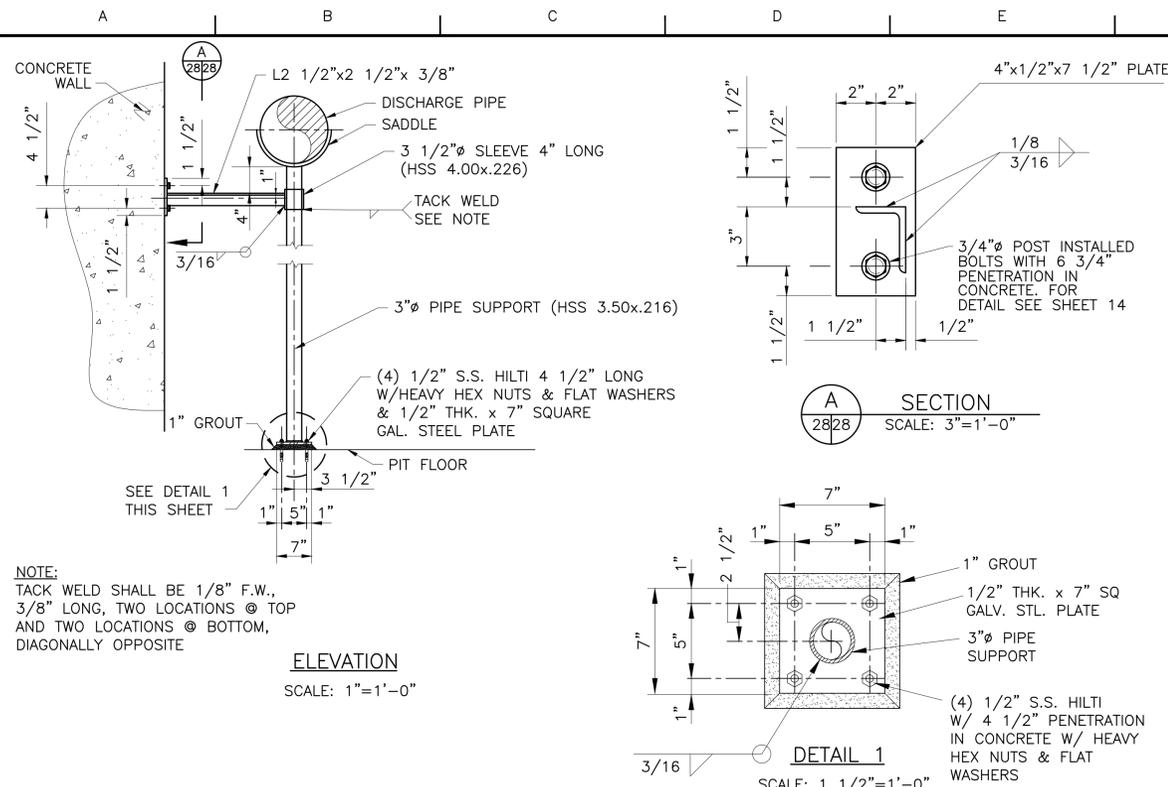

DETAILS FOR DISCHARGE PIPE SUPPORT WITH LATERAL BRACE
SCALE: AS NOTED

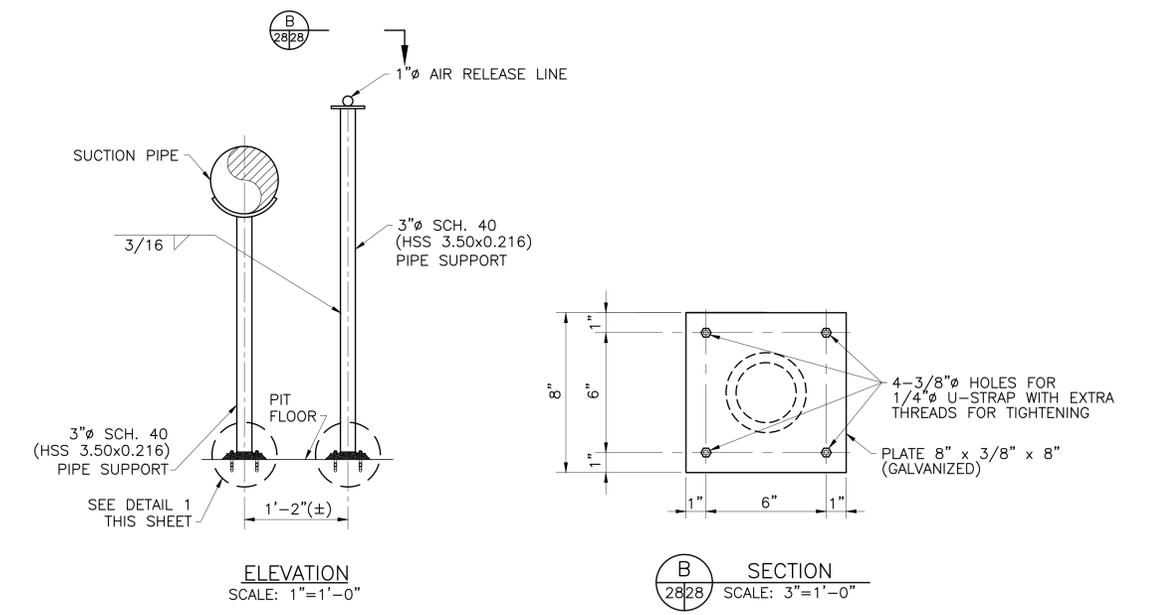


DETAILS FOR SUCTION PIPE AND AIR RELEASE LINE SUPPORT
SCALE: AS NOTED

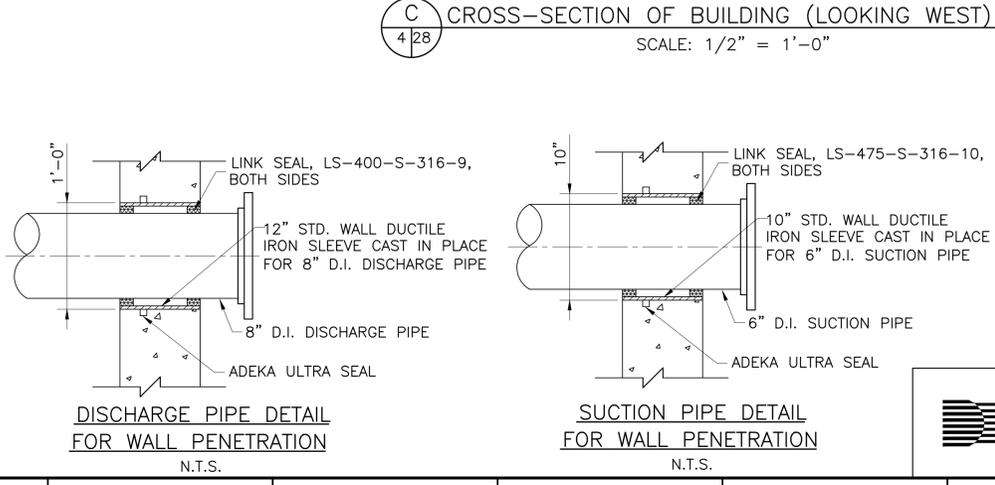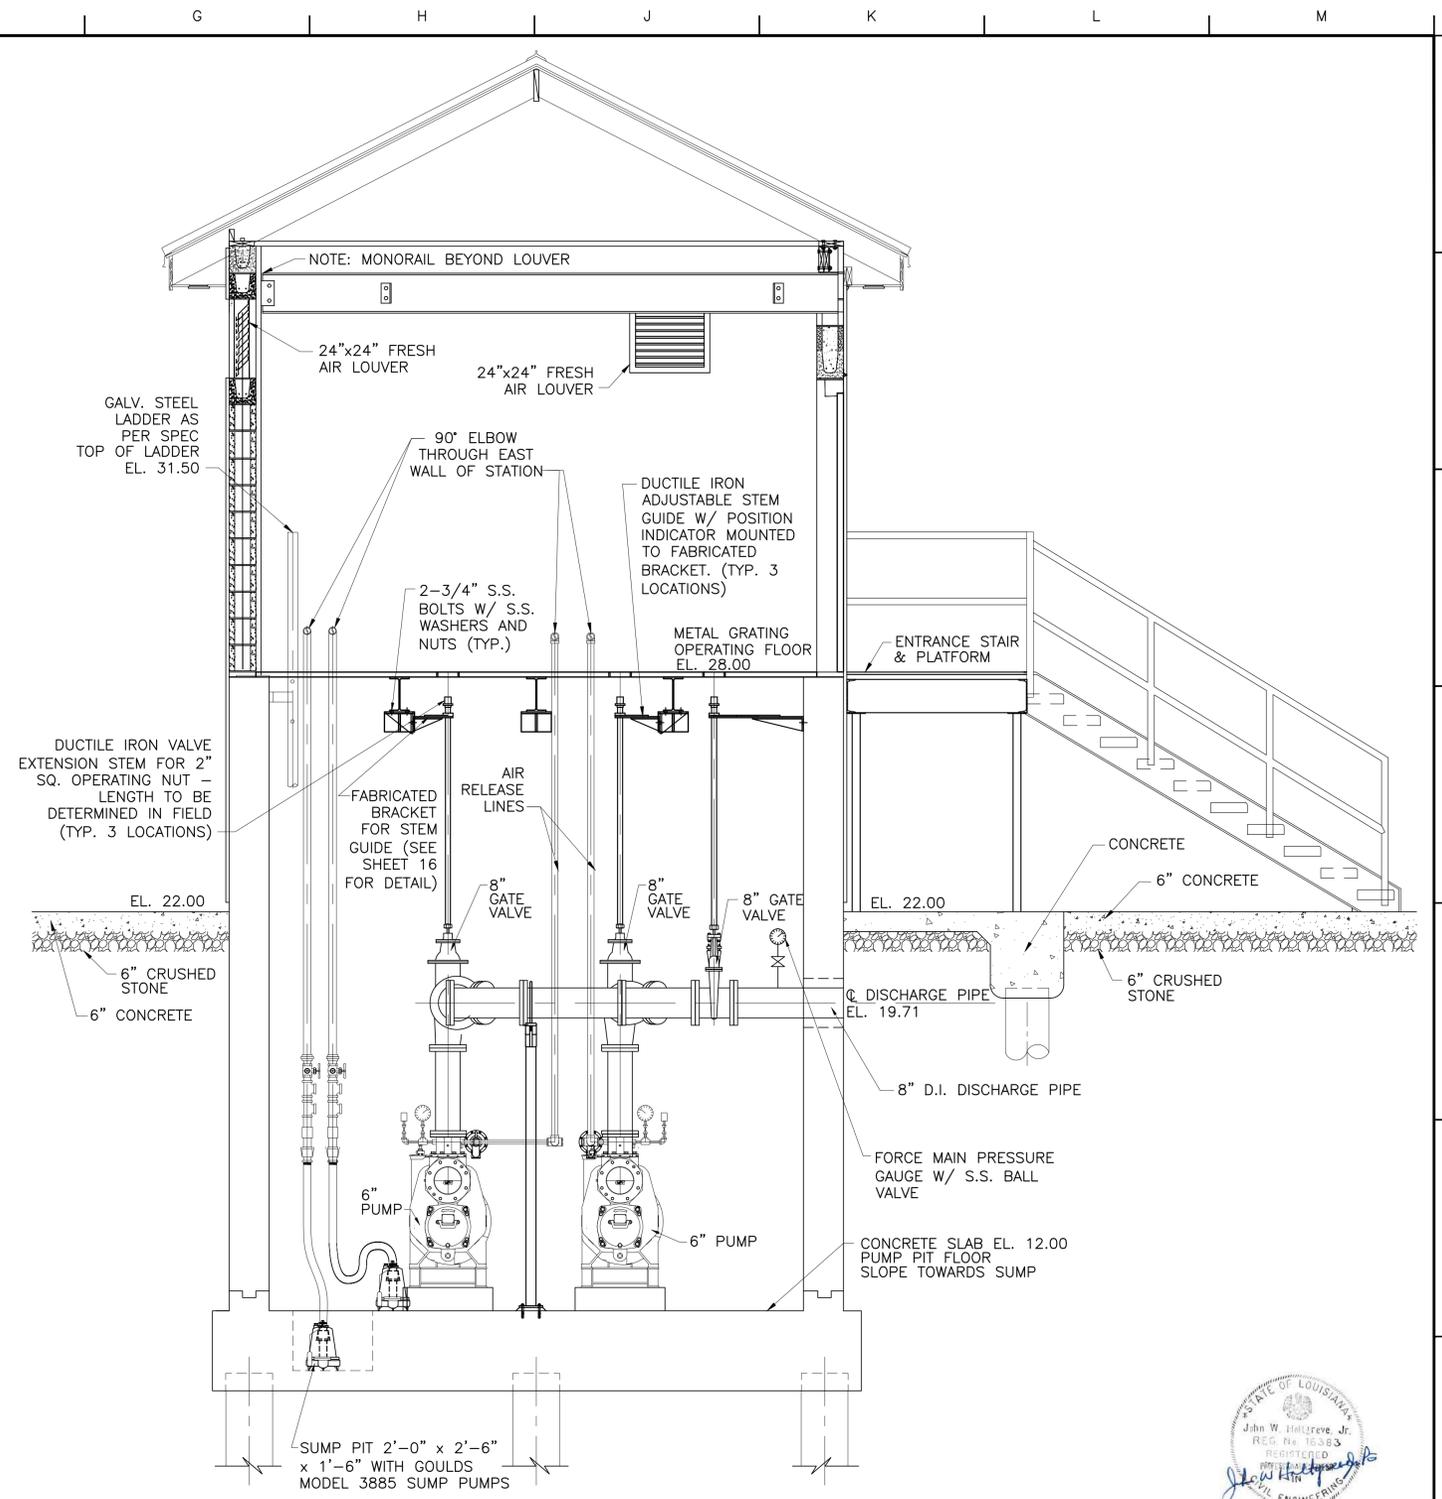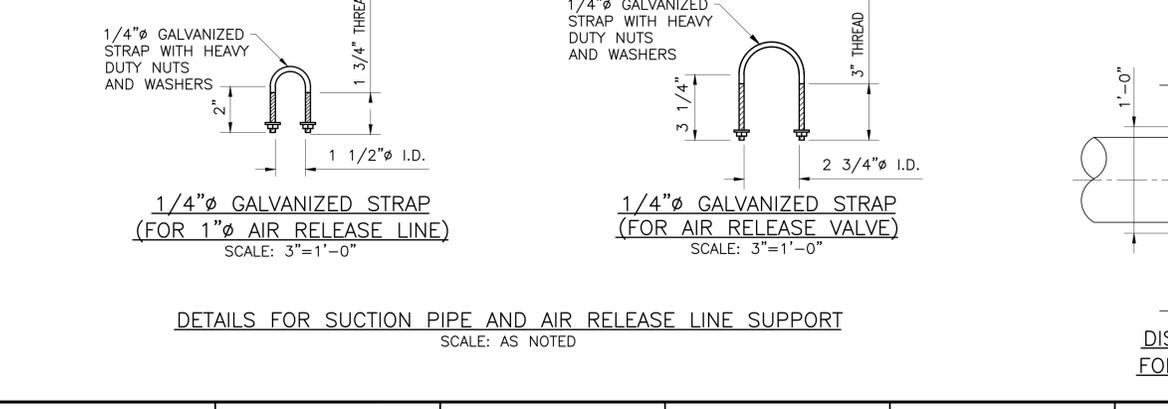

MECHANICAL			
REV.	DATE	DESCRIPTION	BY
SEWERAGE AND WATER BOARD OF NEW ORLEANS			
CONTRACT 3668 HURRICANE KATRINA RELATED 404 HAZARD MITIGATION GRANT PROGRAM REPLACEMENT OF VICTORIA SEWAGE PUMPING STATION			
CROSS SECTION THROUGH STATION & MISCELLANEOUS DETAILS			
DR. TH/BD			
TRC. --			
CK. DS/CW			GENERAL SUPERINTENDENT
AP. JH			
SCALE: AS SHOWN		DWG. No. 12039-W-63	
DATE: SEPTEMBER 2013	SET NO.		SHEET NO. 28



PRINTED May 31, 2013 - 9:26am FILENAME - J:\6005.1-GOSHEP-2013\Contract 3668 - Victoria SPS\SHT 29_VIC_WW REHAB.dwg

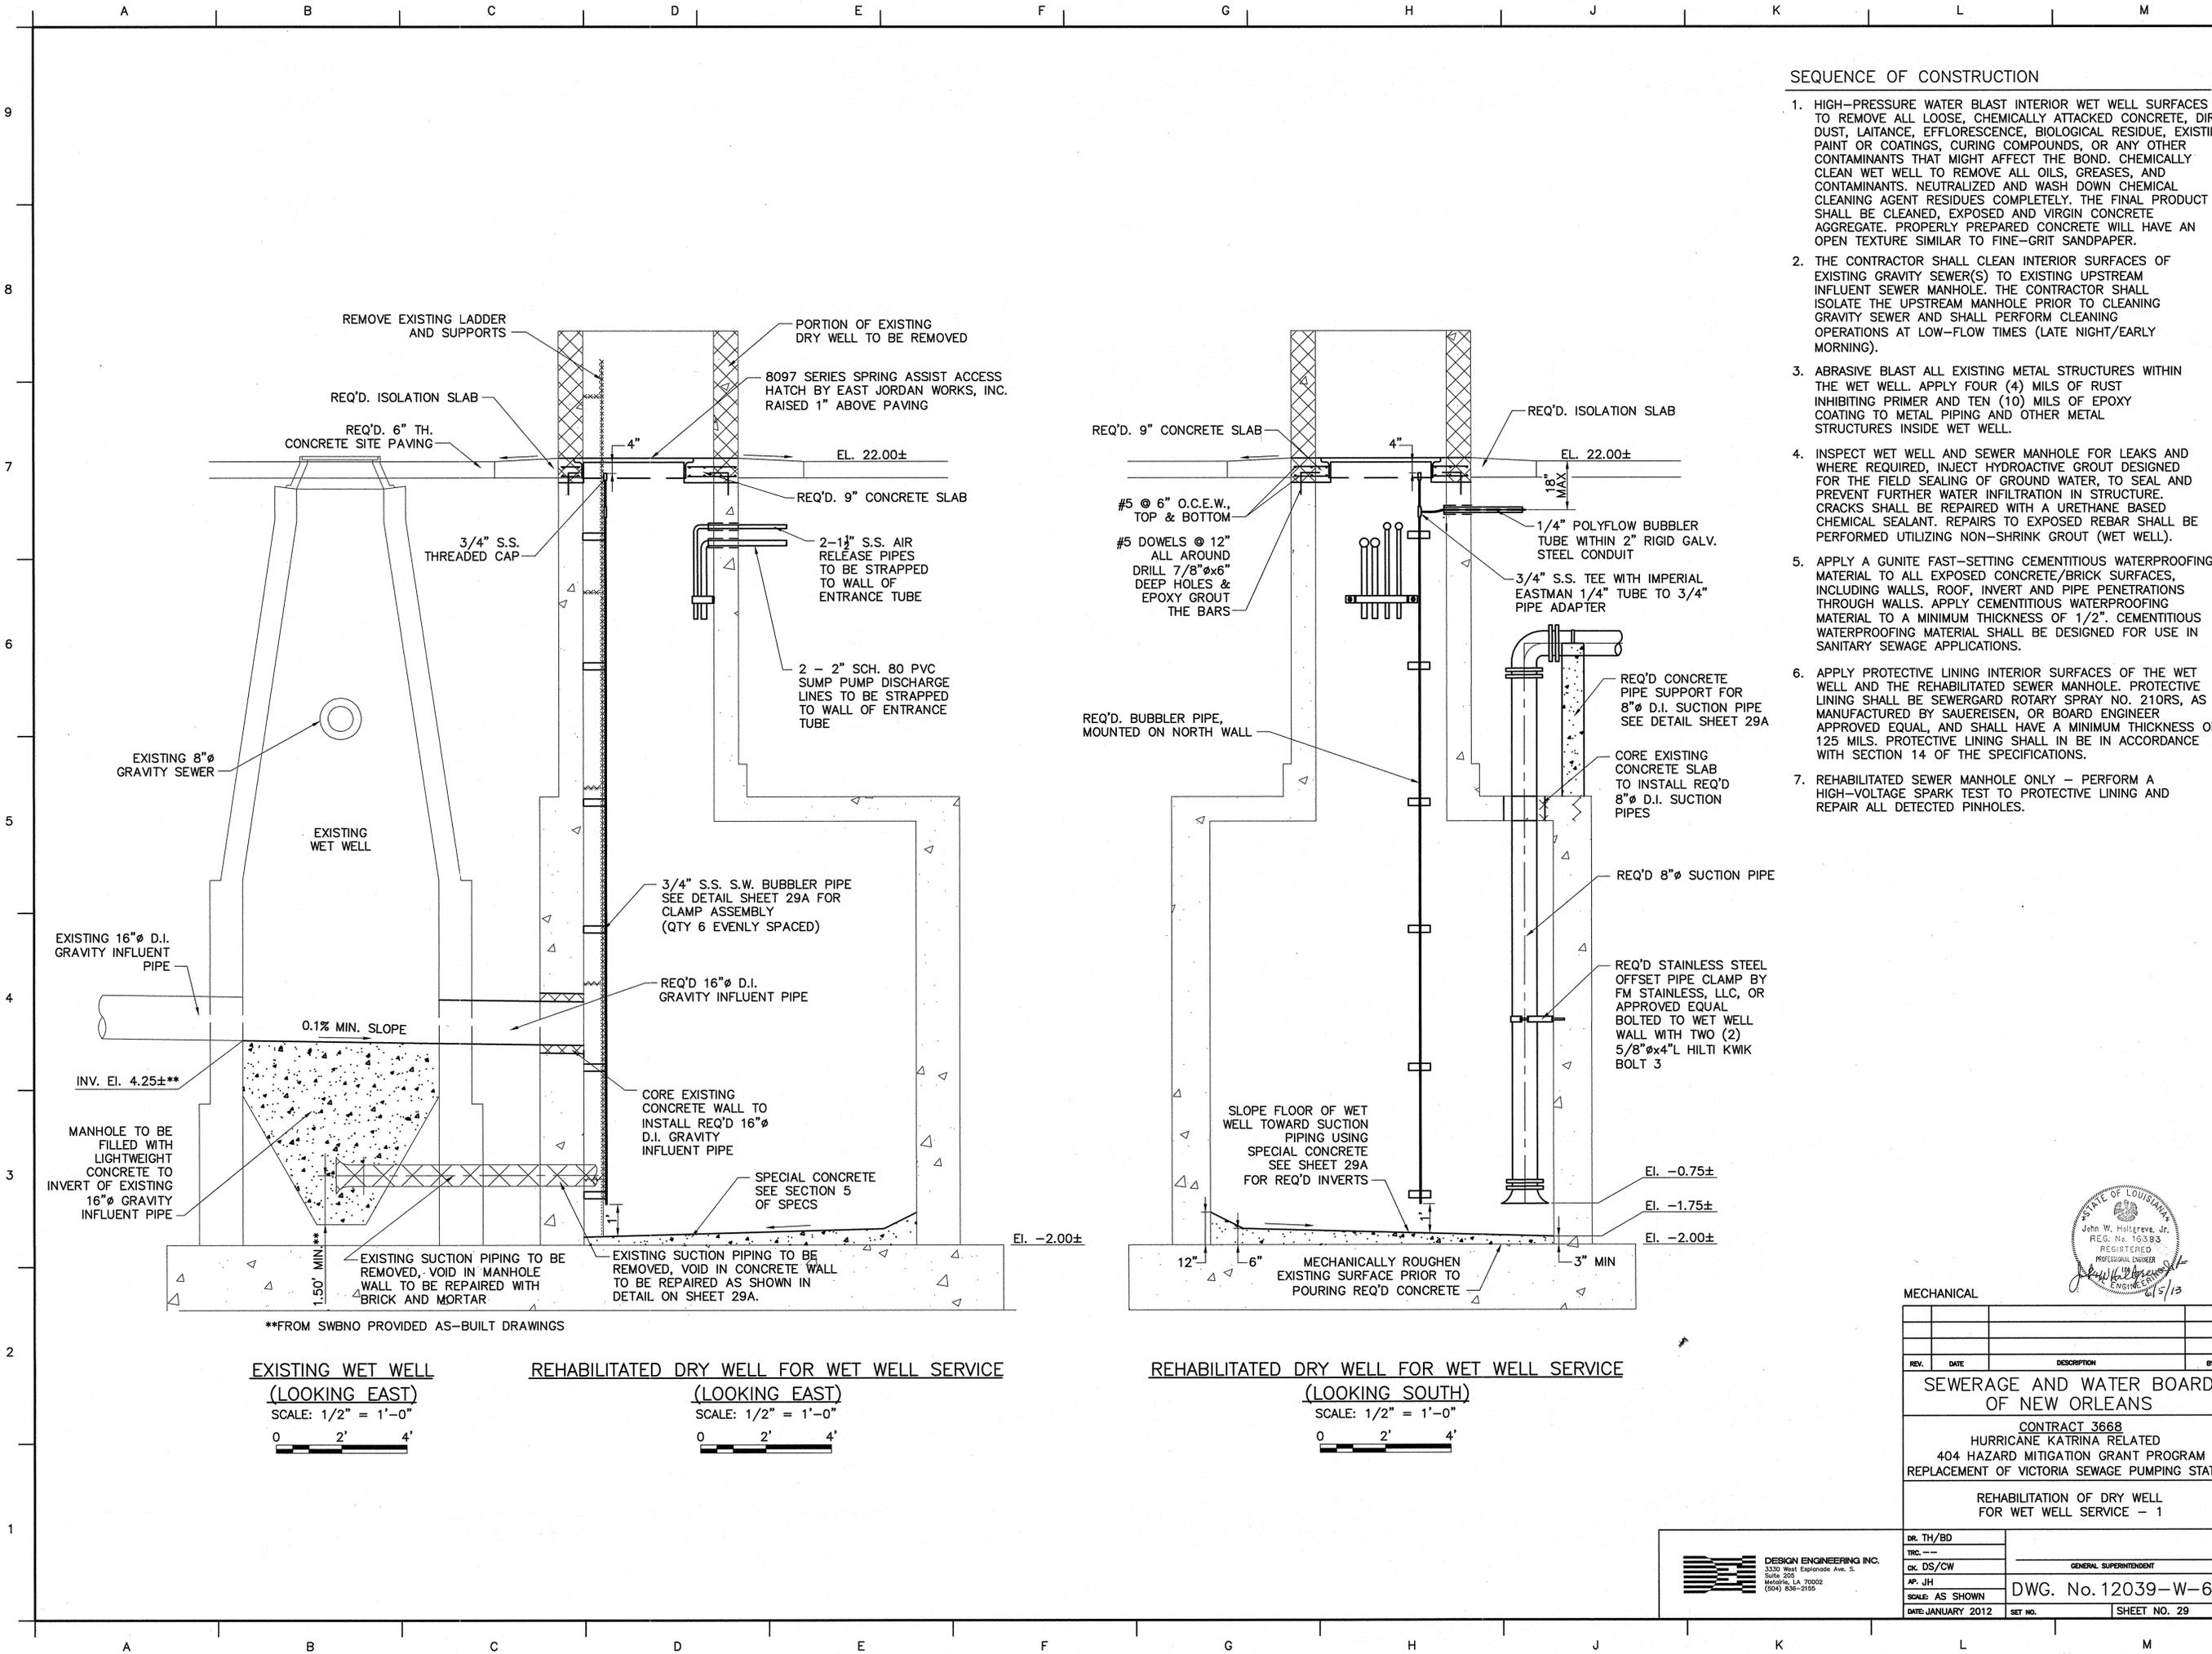

SEQUENCE OF CONSTRUCTION

- HIGH-PRESSURE WATER BLAST INTERIOR WET WELL SURFACES TO REMOVE ALL LOOSE, CHEMICALLY ATTACKED CONCRETE, DIRT DUST, LAITANCE, EFFLORESCENCE, BIOLOGICAL RESIDUE, EXISTING PAINT OR COATINGS, CURING COMPOUNDS, OR ANY OTHER CONTAMINANTS THAT MIGHT AFFECT THE BOND. CHEMICALLY CLEAN WET WELL TO REMOVE ALL OILS, GREASES, AND CONTAMINANTS. NEUTRALIZED AND WASH DOWN CHEMICAL CLEANING AGENT RESIDUES COMPLETELY. THE FINAL PRODUCT SHALL BE CLEANED, EXPOSED AND VIRGIN CONCRETE AGGREGATE. PROPERLY PREPARED CONCRETE WILL HAVE AN OPEN TEXTURE SIMILAR TO FINE-GRIT SANDPAPER.
- THE CONTRACTOR SHALL CLEAN INTERIOR SURFACES OF EXISTING GRAVITY SEWER(S) TO EXISTING UPSTREAM INFLUENT SEWER MANHOLE. THE CONTRACTOR SHALL ISOLATE THE UPSTREAM MANHOLE PRIOR TO CLEANING GRAVITY SEWER AND SHALL PERFORM CLEANING OPERATIONS AT LOW-FLOW TIMES (LATE NIGHT/EARLY MORNING).
- ABRASIVE BLAST ALL EXISTING METAL STRUCTURES WITHIN THE WET WELL. APPLY FOUR (4) MILS OF RUST INHIBITING PRIMER AND TEN (10) MILS OF EPOXY COATING TO METAL PIPING AND OTHER METAL STRUCTURES INSIDE WET WELL.
- INSPECT WET WELL AND SEWER MANHOLE FOR LEAKS AND WHERE REQUIRED, INJECT HYDROACTIVE GROUT DESIGNED FOR THE FIELD SEALING OF GROUND WATER, TO SEAL AND PREVENT FURTHER WATER INFILTRATION IN STRUCTURE. CRACKS SHALL BE REPAIRED WITH A URETHANE BASED CHEMICAL SEALANT. REPAIRS TO EXPOSED REBAR SHALL BE PERFORMED UTILIZING NON-SHRINK GROUT (WET WELL).
- APPLY A GUNITE FAST-SETTING CEMENTITIOUS WATERPROOFING MATERIAL TO ALL EXPOSED CONCRETE/BRICK SURFACES, INCLUDING WALLS, ROOF, INVERT AND PIPE PENETRATIONS THROUGH WALLS. APPLY CEMENTITIOUS WATERPROOFING MATERIAL TO A MINIMUM THICKNESS OF 1/2". CEMENTITIOUS WATERPROOFING MATERIAL SHALL BE DESIGNED FOR USE IN SANITARY SEWAGE APPLICATIONS.
- APPLY PROTECTIVE LINING INTERIOR SURFACES OF THE WET WELL AND THE REHABILITATED SEWER MANHOLE. PROTECTIVE LINING SHALL BE SEWERGARD ROTARY SPRAY NO. 210RS, AS MANUFACTURED BY SAUERREISEN, OR BOARD ENGINEER APPROVED EQUAL, AND SHALL HAVE A MINIMUM THICKNESS OF 125 MILS. PROTECTIVE LINING SHALL IN BE IN ACCORDANCE WITH SECTION 14 OF THE SPECIFICATIONS.
- REHABILITATED SEWER MANHOLE ONLY - PERFORM A HIGH-VOLTAGE SPARK TEST TO PROTECTIVE LINING AND REPAIR ALL DETECTED PINHOLES.



REV.	DATE	DESCRIPTION	BY

MECHANICAL

SEWERAGE AND WATER BOARD OF NEW ORLEANS

CONTRACT 3668
HURRICANE KATRINA RELATED
404 HAZARD MITIGATION GRANT PROGRAM
REPLACEMENT OF VICTORIA SEWAGE PUMPING STATION


REHABILITATION OF DRY WELL FOR WET WELL SERVICE - 1

DR. TH/BD
TRC. --
CK. DS/CW
AP. JH
SCALE: AS SHOWN
DATE: JANUARY 2012


GENERAL SUPERINTENDENT
DWG. No. 12039-W-63
SHEET NO. 29




PRINTED May 31, 2013 9:28am FILENAME - J:\6005.1-GOSHEP-2013\Contract 3668 - Victoria SPS_SHT 29A_VIC_WW_REHAB.dwg

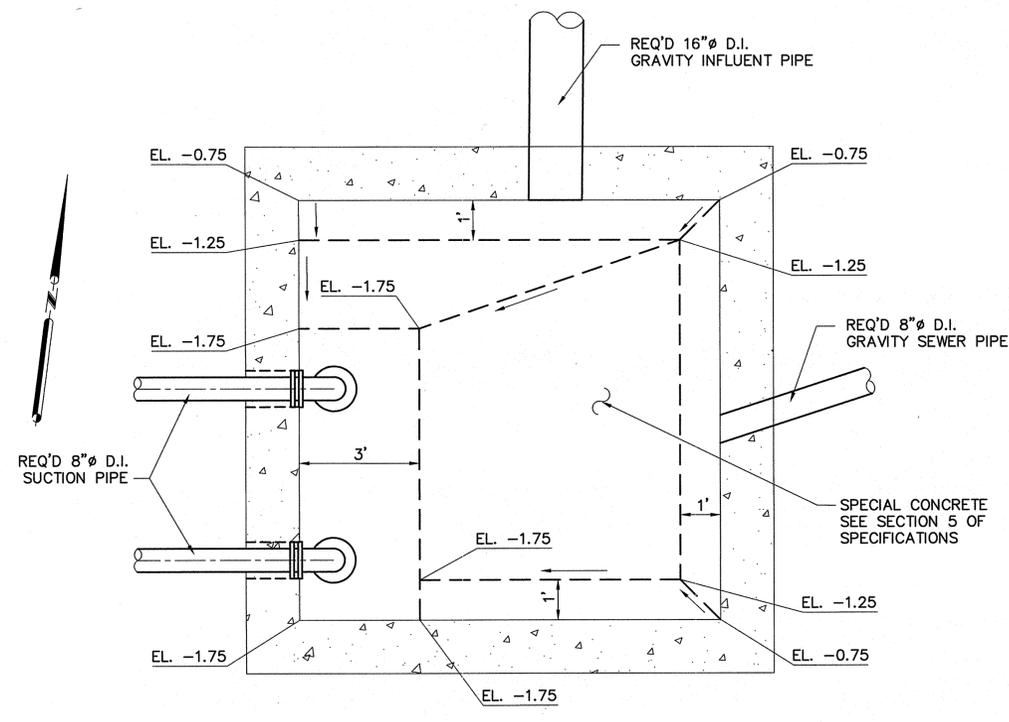


PLAN OF REHABILITATED WET WELL
SCALE: 1 1/2" = 1'-0"

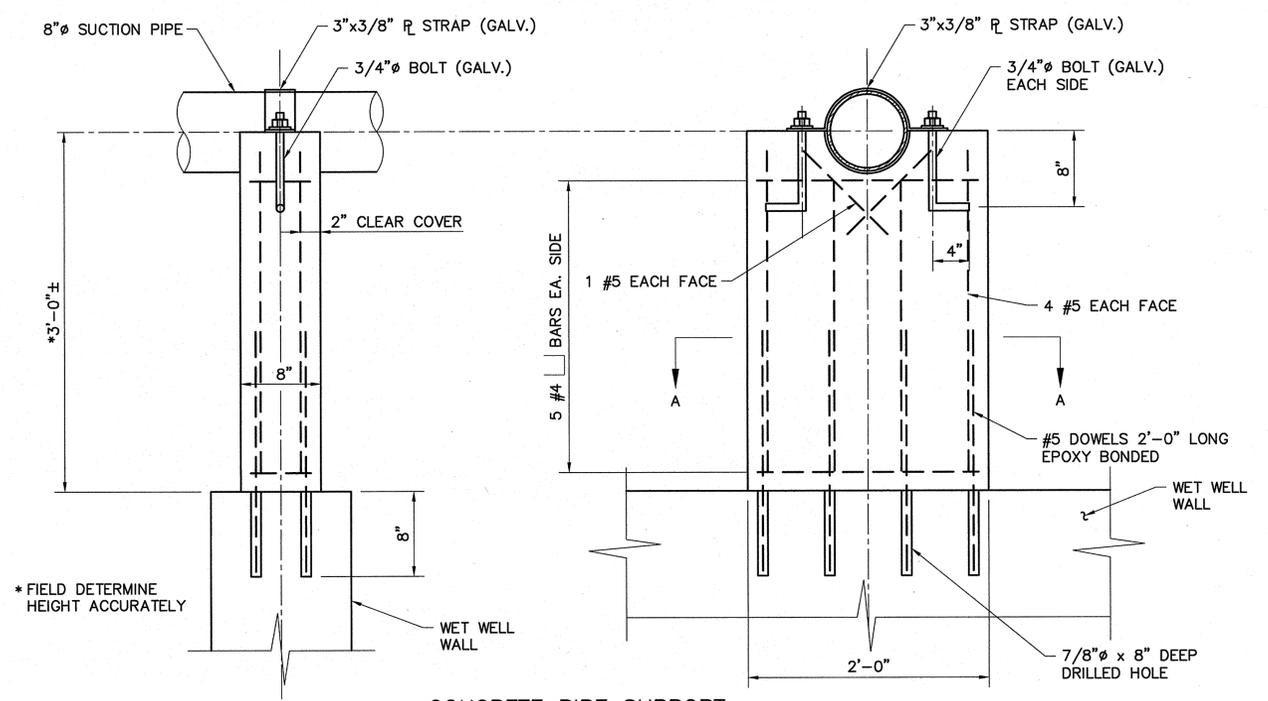


CONCRETE PIPE SUPPORT
SCALE: 1 1/2" = 1'-0"

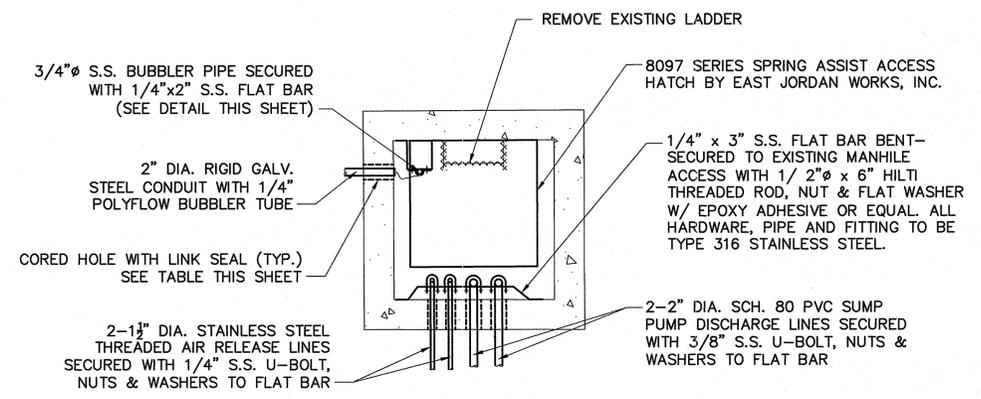

MANHOLE DETAIL
SCALE: 1 1/2" = 1'-0"

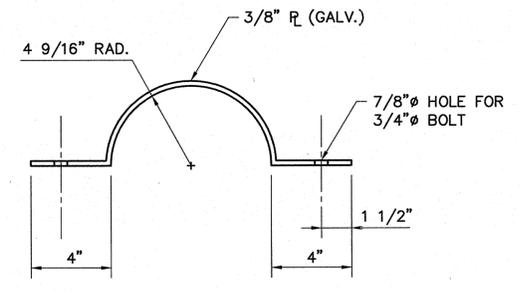

PIPE STRAP DETAIL
SCALE: 3" = 1'-0"

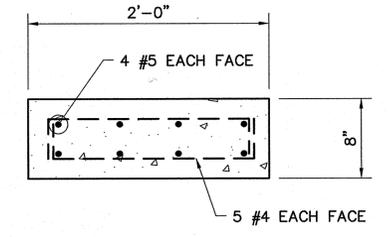


SECTION A-A
SCALE: 1 1/2" = 1'-0"

REQ'D LINK SEALS FOR WET WELL PENETRATIONS

PIPE/CONDUIT	CORED HOLE Ø	LINK SEAL MODEL NO.
SUMP PUMP LINE 2" PVC	4"	LS-300-S-316-6
AIR RELEASE LINE 1" S.S.	3"	LS-300-S-316-4
BUBBLER CONDUIT 2" RIGID GALV. STEEL	4"	LS-300-S-316-6
GRAVITY SEWER 8" PVC	12"	LS-475-S-316-12
SUCTION PIPE 8" D.I.	12"	LS-400-S-316-9
INFLUENT SEWER 16" D.I.	20"	LS-360-S-316-27*

* AS AN ALTERNATE TO THE MODULAR SEAL FOR THIS PIPE, CONTRACTOR MAY CHOOSE TO USE NON-SHRINK CEMENT GROUT TO SEAL PIPE INTO EXISTING WALL. CONTRACTOR SHALL SUBMIT TO BOARD ENGINEER FOR REVIEW AND APPROVAL THE GROUT MIX AND INSTALLATION DETAILS.

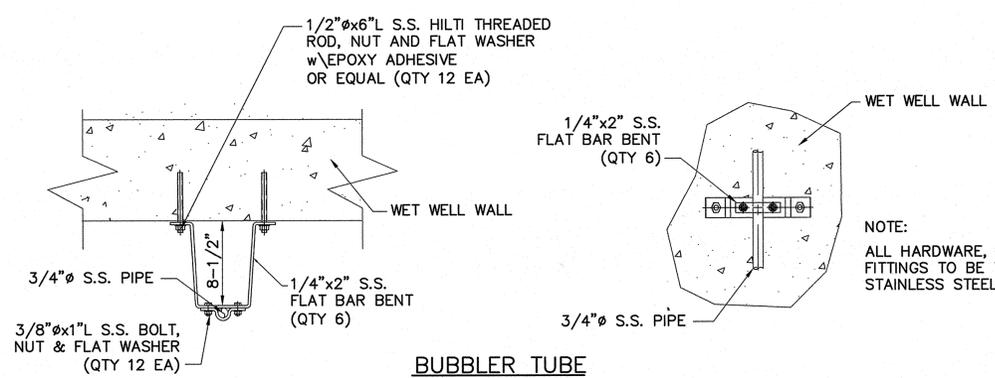

BUBBLER TUBE CLAMP ASSEMBLY DETAIL
N.T.S.

NOTE:
ALL HARDWARE, PIPE AND FITTINGS TO BE TYPE 316 STAINLESS STEEL.




REV.	DATE	DESCRIPTION	BY
MECHANICAL SEWERAGE AND WATER BOARD OF NEW ORLEANS CONTRACT 3668 HURRICANE KATRINA RELATED 404 HAZARD MITIGATION GRANT PROGRAM REPLACEMENT OF VICTORIA SEWAGE PUMPING STATION REHABILITATION OF DRY WELL FOR WET WELL SERVICE - 2			
DR. TH/BD			
CK. DS/CW			GENERAL SUPERINTENDENT
AP. JH			DWG. No. 12039-W-63
SCALE: AS SHOWN			SHEET NO. 29A
DATE: JANUARY 2012			



A B C D E F G H J K L M

9
8
7
6
5
4
3
2
1

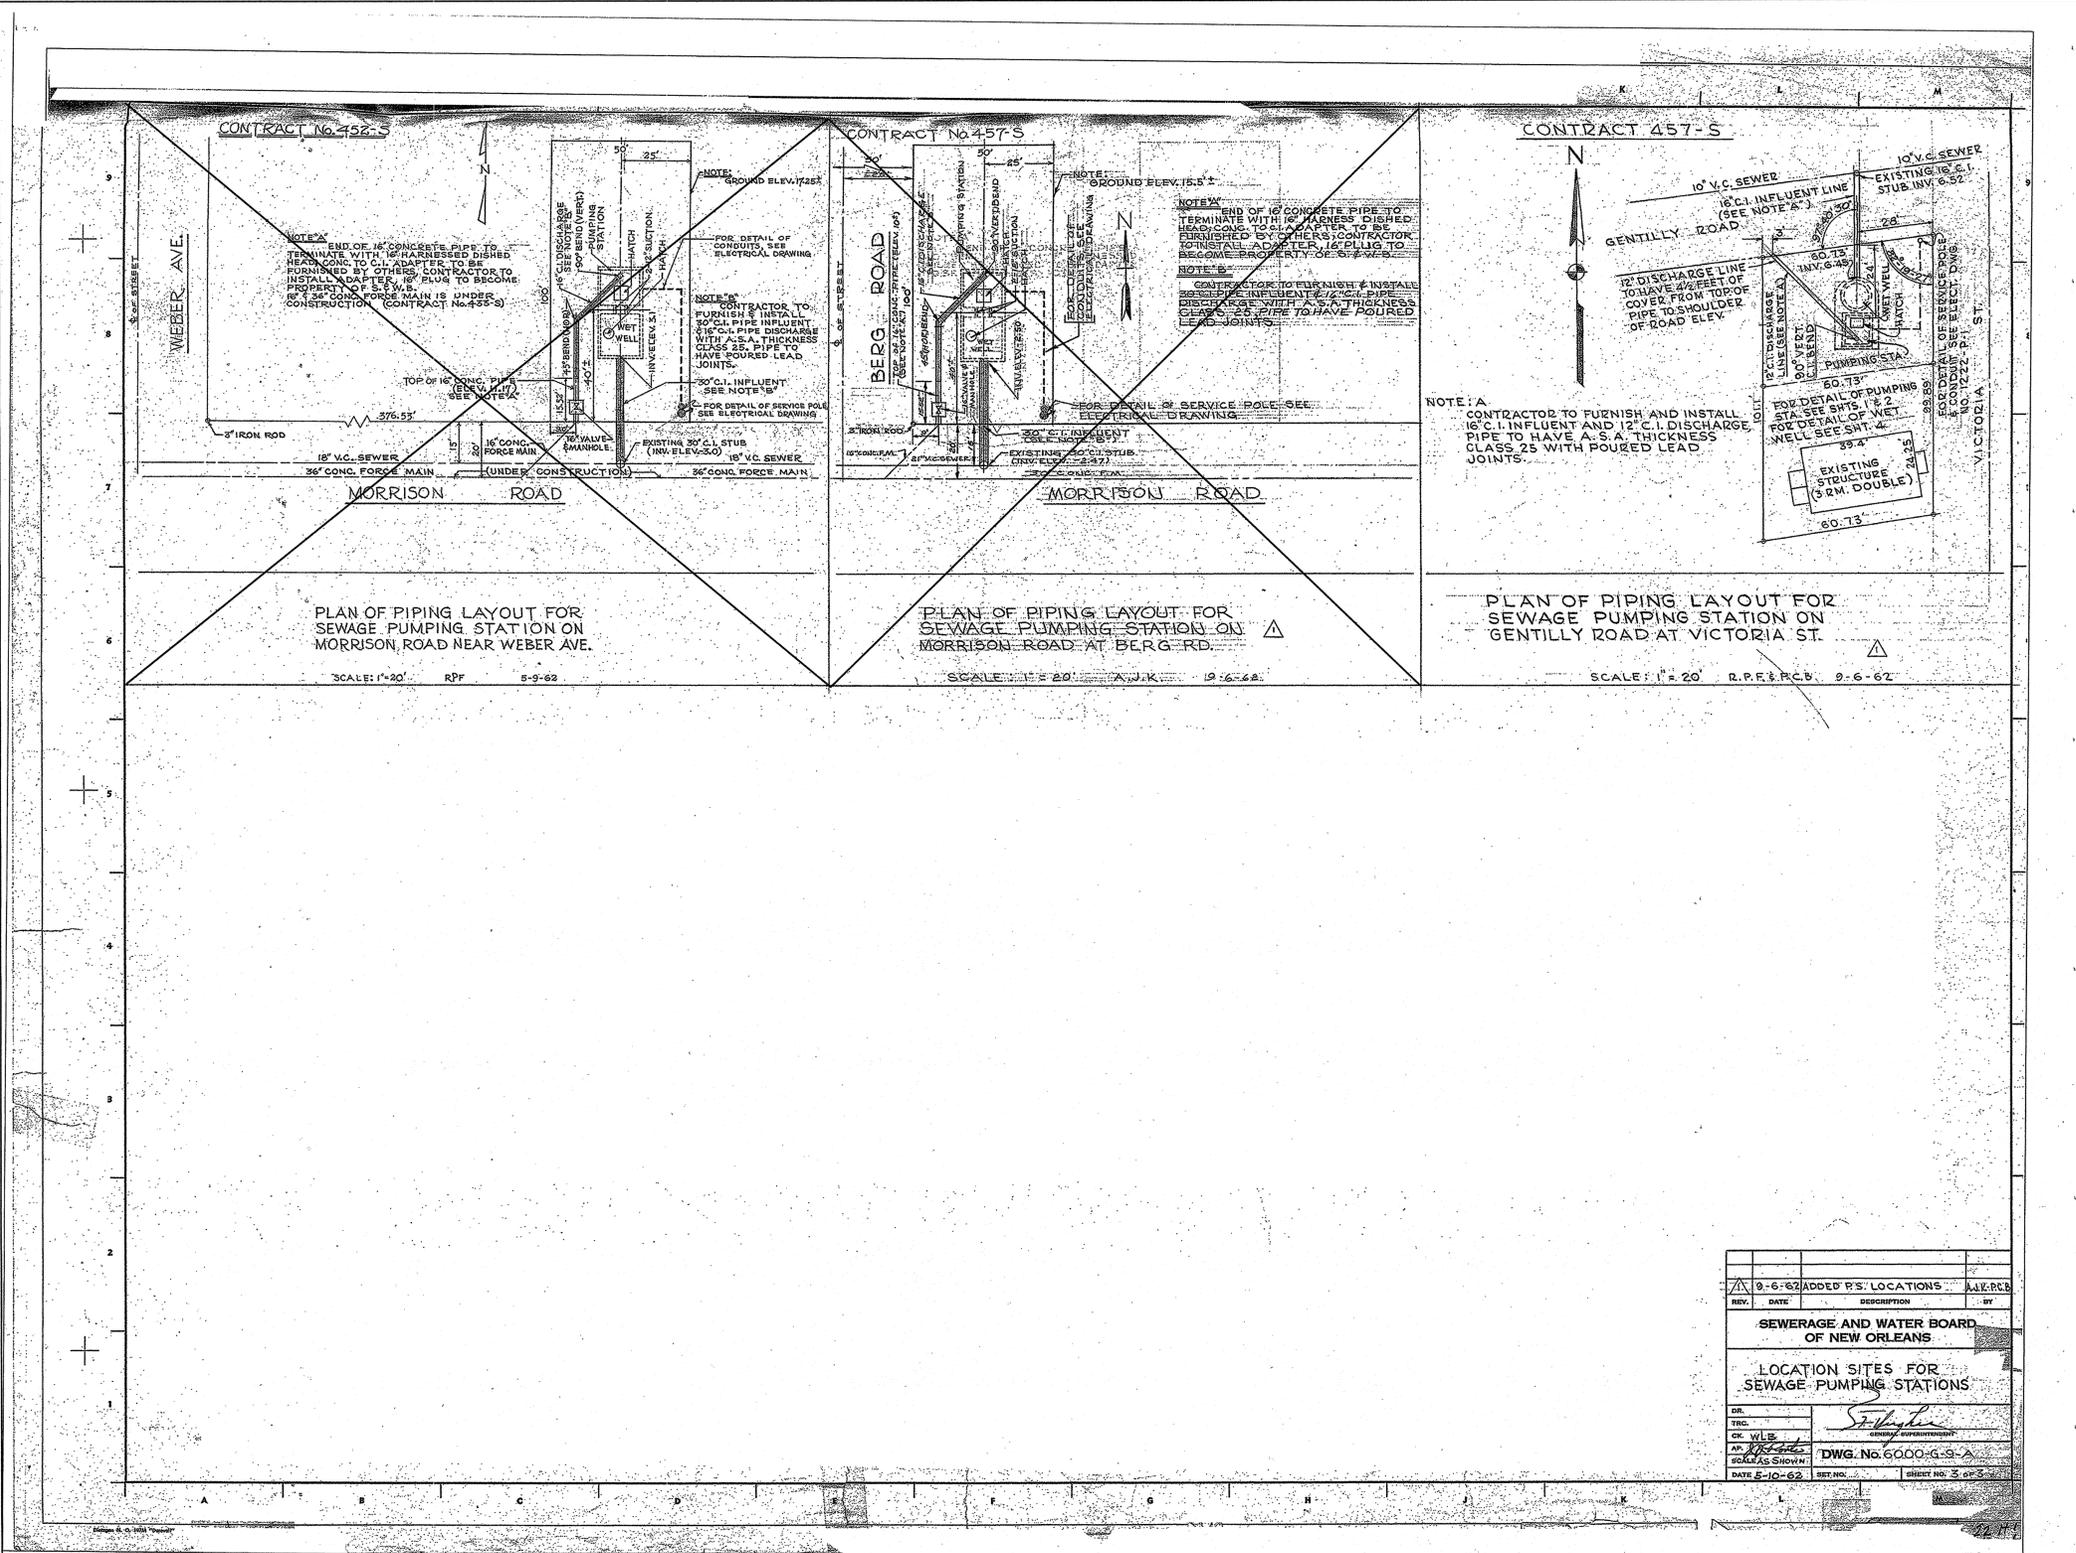

PLAN OF PIPING LAYOUT FOR SEWAGE PUMPING STATION ON MORRISON ROAD NEAR WEBER AVE.

PLAN OF PIPING LAYOUT FOR SEWAGE PUMPING STATION ON MORRISON ROAD AT BERG RD.

PLAN OF PIPING LAYOUT FOR SEWAGE PUMPING STATION ON GENTILLY ROAD AT VICTORIA ST.

SCALE: 1"=20' R.P.F. 8-9-62

SCALE: 1"=20' A.J.K. 10-16-62

SCALE: 1"=20' R.P.F. & R.C.B. 9-6-62


REV.	DATE	DESCRIPTION	BY
Δ	9-6-62	ADDED P.S. LOCATIONS	A.J.K. & R.C.B.
SEWERAGE AND WATER BOARD OF NEW ORLEANS			
LOCATION SITES FOR SEWAGE PUMPING STATIONS			
DR.	<i>[Signature]</i>		
TRC.			
CK.	W.L.S.		
AP.	[Signature]		
SCALE AS SHOWN	DWG. No. 6000-G-3-A		
DATE 8-10-62	SHEET NO.	SHEET NO. 3 OF 3	

NOTE:
PROVIDED BY SEWERAGE AND WATER BOARD FOR INFORMATIONAL PURPOSES ONLY.



REV.	DATE	DESCRIPTION	BY
SEWERAGE AND WATER BOARD OF NEW ORLEANS			
CONTRACT 3668			
HURRICANE KATRINA RELATED			
404 HAZARD MITIGATION GRANT PROGRAM			
REPLACEMENT OF VICTORIA SEWAGE PUMPING STATION			
REFERENCE DRAWING			
DR.			
TRC.			
CK.			
AP.			
SCALE AS SHOWN	DWG. No. 12039-W-63		
DATE: JANUARY 2012	SHEET NO.	SHEET NO. 30	

A B C D E F G H J K L M



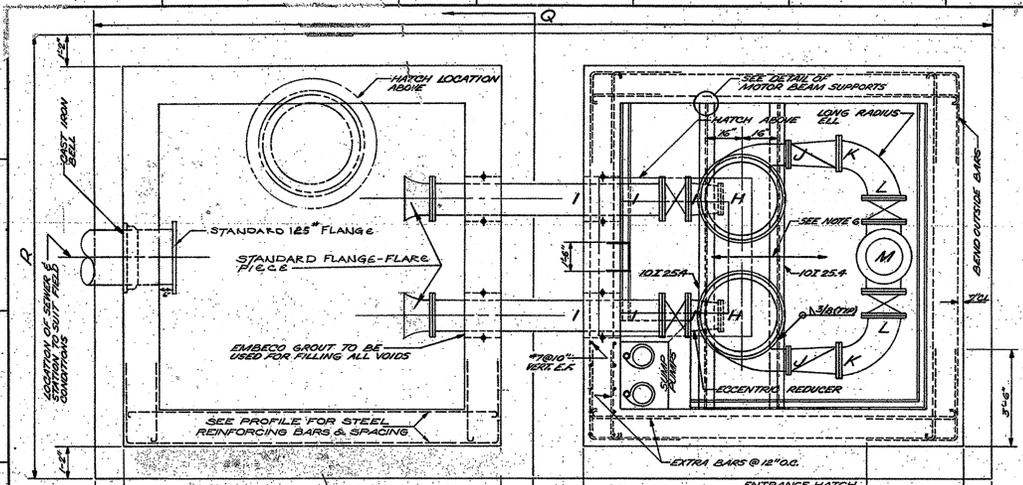


INFORMATION CHART

CONT. NO.	STATION	A	B	C	D	E	F	G	H	I	J	K	L	M	N	O	P	Q	R	X
452-S	MORRISON-WEBER	8'-4"	17'-0"	11'-0"	15'-3"	11'-0"	8'-6"	12'-5"	8'	12'	8'	10'	12'	16'	30'	310'	2'	22'-4"	16'-0"	18'
457-S	MORRISON-BERG	5'-8"	14'-3"	11'-0"	15'-0"	11'-0"	8'-4"	12'-5"	8'	12'	8'	10'	12'	16'	30'	240'	2'	22'-4"	16'-0"	18'
457-S	GEWILLY-VICTORIA	N/A	N/A	N/A	13'-0"	10'-6"	N/A	22'-3"	8'	10'	6'	8'	10'	12'	16'	645'	1'	24'-0"	16'-6"	13'

NOTE: N/A = NOT APPLICABLE

- NOTES:**
- FOR ELEC. & PNEUMATIC DETAILS SEE DWG. #1222-P1, #116-P12, #6000-G-9, SHEET 9
 - STEEL PLATFORM AT MOTOR BASE LEVEL SHALL BE 1/4" THICK AND 94" WIDE COVERED BY 1/4" CEMENT RUBBER MAT.
 - PLATFORM & SUPPORTS SHALL BE REMOVABLE & INDEPENDENT OF MOTOR SUPPORTS.
 - LOCATION OF ALL SECTION COMPONENTS ARE NOT SHOWN ON THIS PLAN. COMPONENTS ARE TO BE PLACED BY THE FINISHING CONTRACTOR & APPROVED BY THE BOARD'S ENGINEERS.
 - SEE ALTERNATE PIPING ARRANGEMENT SEE DWG. #6000-G-9, SHEET 1 OF 3
 - FLOOR SHALL SLOPE TOWARD TROUGHES ON EACH SIDE & TROUGHES SHALL SLOPE TOWARD SURGE.
 - USE 1/2" EVERETT-ANDRON AKC. OR EQUAL WATERSTOP(TYS)
 - EACH SECTION OF COVER TO HAVE LOCKING BARS TO LIMIT EXTENT OF OPENING TRAP.
 - COVER TO BE OF ALL ALUM. CONST. BOLTS MAY BE OF NON-FERROUS METAL OR MAY BE GALVANIZED STEEL.
 - 10" IN INFORMATION CHART DENOTES NUMBER OF PILES REQUIRED UNDER FOUNDATION SLAB SPACED AS DIRECTED BY ENGINEER. PILES TO BE SET UNTREATED WOOD PILES.
 - 1" & 3/8" DIA. WELDED TO I BEAMS FOR STEEL MOTOR BASE.
 - IS FOR FLOOR SUPPORTS & COMPONENT SUPPORTS THAT ARE TO BE MOUNTED ON THE WALLS SHALL BE DONE WITH THE USE OF CONCRETE INSERTS WITH BOLTS.
 - LIDDER TO BE SHOWN ON SHEET #1 WITH SUPPORTS MOUNTED ON WALL EVERY 6 FEET BOLTED TO LIDDER (INCLUDING GUARD RAIL)
 - 3/4" TAPERED DOVAIL PINS 180° APART TO BE INJECTED AFTER MOTOR HAS BEEN ALIGNED. PINS TO BE 1/2" DIA.
 - FLOOR PLATES AND SUPPORTS SHALL BE DESIGNED FOR A COMBINATION LIVE AND DEAD LOAD OF 200 LBS/SQ. FT.

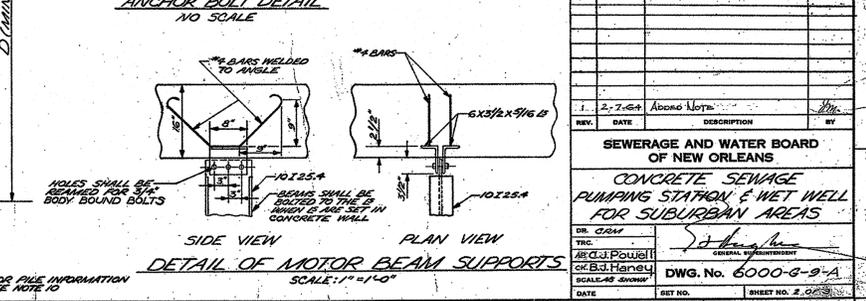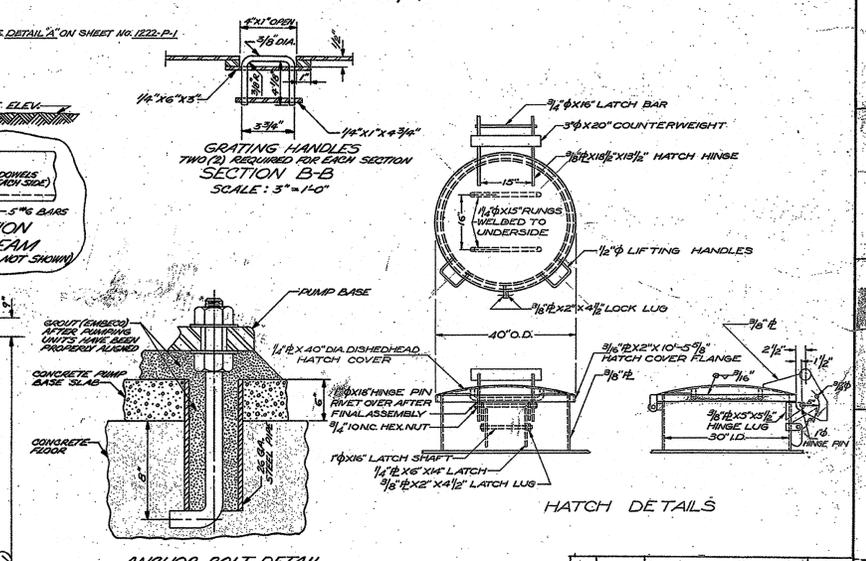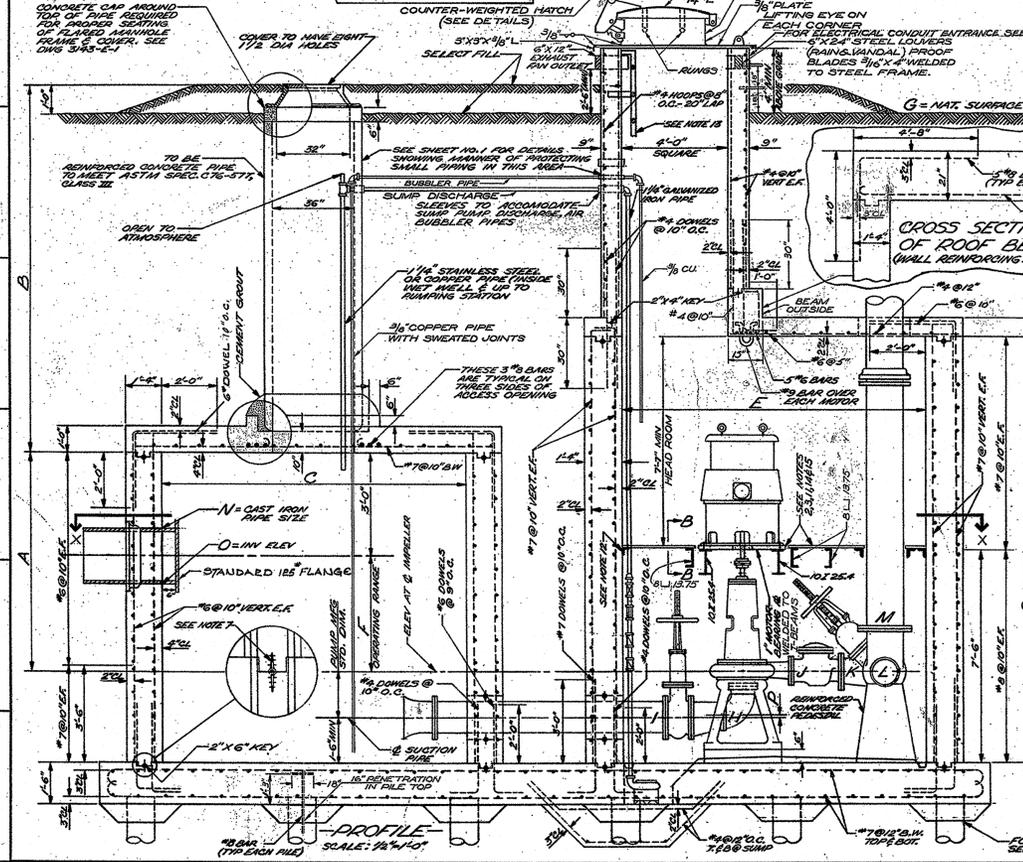

REV.	DATE	DESCRIPTION	BY
1	2-7-04	As per Note	

SEWERAGE AND WATER BOARD OF NEW ORLEANS
CONCRETE SEWAGE PUMPING STATION & WET WELL FOR SUBURBAN AREAS

DR. 0214
 TRC
 ECJ, J. POUILLI
 CB, B. HANEU
 SCALE: AS SHOWN

DWG. No. 6000-G-9-A
 SET NO. SHEET NO. 2 OF 3

NOTE:
 PROVIDED BY SEWERAGE AND WATER BOARD FOR INFORMATIONAL PURPOSES ONLY.



REV.	DATE	DESCRIPTION	BY


SEWERAGE AND WATER BOARD OF NEW ORLEANS
 CONTRACT 3668
 HURRICANE KATRINA RELATED
 404 HAZARD MITIGATION GRANT PROGRAM
 REPLACEMENT OF VICTORIA SEWAGE PUMPING STATION

REFERENCE DRAWING


DR. ---
 TRC. ---
 CK. ---
 AP. ---
 SCALE: AS SHOWN
 DATE: JANUARY 2012

GENERAL SUPERINTENDENT
 DWG. No. 12039-W-63
 SET NO. SHEET NO. 31

PRINTED May 29, 2013 - 2:28pm FILENAME = J:\0005 SPS Rehab. Project\CONTRACT 3633 AS BUILT DRAWINGS\AS-BUILT\STR-VICTORIA-01-ASBUILT.dwg

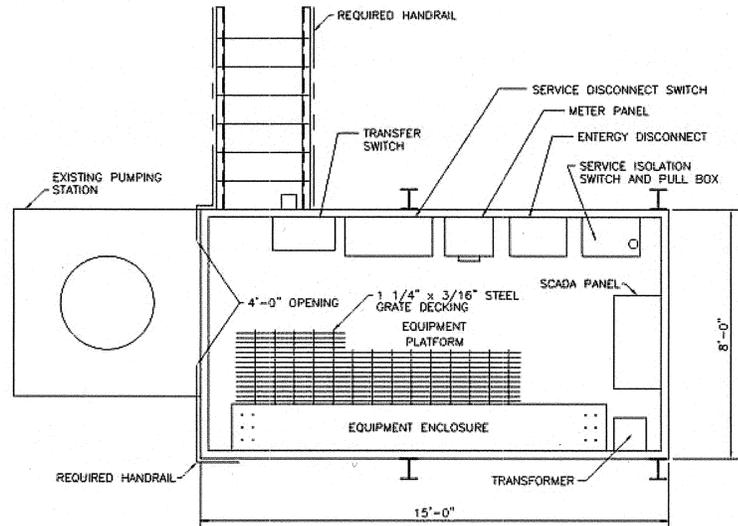


TYPICAL FLOOR PLAN
SCALE: 1/2" = 1'-0"
0 2' 4'

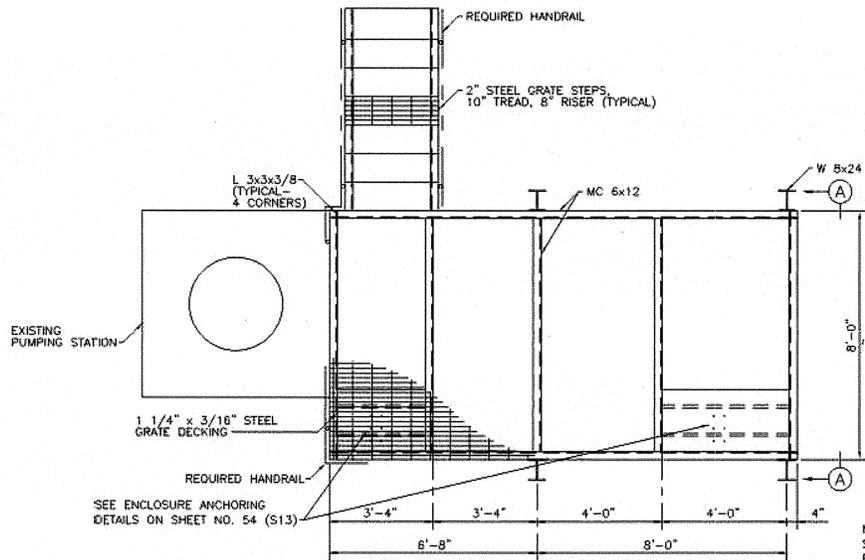


FLOOR FRAMING PLAN
SCALE: 1/2" = 1'-0"
0 2' 4'

NOTE:
SEE SHEET NO. 54 (S13)
FOR BOLT HOLES IN GRATING
FOR FREE STANDING ENCLOSURE

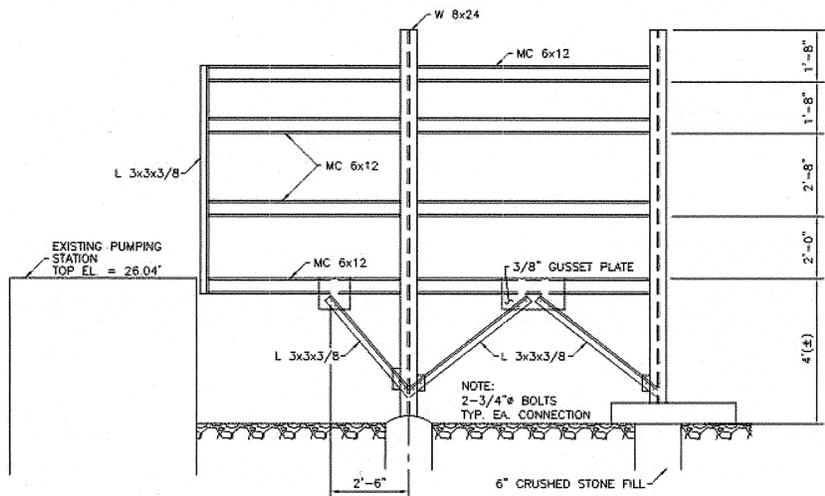

TYPICAL FRAMING ELEVATION
SCALE: 1/2" = 1'-0"
0 2' 4'

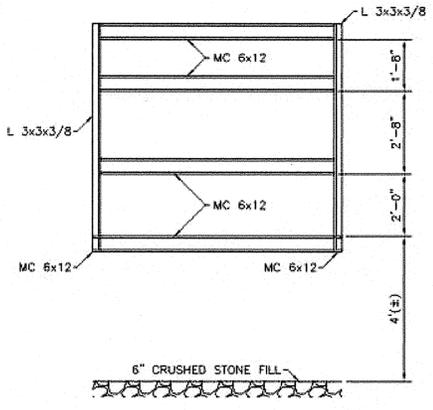

SIDE ELEVATION AT PERIPHERY (A)-(A)
SCALE: 1/2" = 1'-0"
0 2' 4'

- NOTES:**
- 1.) ALL STRUCTURAL STEEL SHALL CONFORM TO ASTM A36.
 - 2.) WELDING SHALL BE ELECTRIC ARC WELDING OR OTHER APPROVED METHOD CONFORMING TO AWS D1.1.
 - 3.) ANCHOR BOLTS SHALL BE ASTM F1554, 55 KSI.
 - 4.) ALL STEEL SHALL BE HOT DIPPED GALVANIZED AFTER FABRICATION.
 - 5.) ALL WELDS SHALL BE CONTINUOUS TO PREVENT ENTRY OF MOISTURE BETWEEN TWO METAL PIECES IN CONTACT.
 - 6.) GALVANIZED SURFACES DAMAGED AFTER ZINC COATING SHALL BE REPAIRED BY REMOVING LOOSE AND CRACKED COATING AFTER WHICH THE CLEARED AREA SHALL BE REPAIRED BY APPLYING COLD GALVANIZING REPAIR COMPOUND LIKE GALV-COAT BY BOWMAN OR GALVANOX, TYPE 1 BY BASF WYANDOTTE CORP. OR EQUAL.



STRUCTURAL	
RECORD DRAWING	NH
REV. DATE	DESCRIPTION
SEWERAGE AND WATER BOARD OF NEW ORLEANS	
CONTRACT 3633	
HURRICANE KATRINA RELATED REPAIRS TO BULLARD, DOOT STREET, LAKE FOREST, PLUM ORCHARD LAWRENCE AND VICTORIA SEWAGE PUMPING STATIONS	
VICTORIA SEWAGE PUMPING STATION ELEVATED PLATFORM FOR ELECTRICAL EQUIPMENT	
DR. M.Z.	GENERAL SUPERINTENDENT
CK. J.F.E.	
SCALE: AS SHOWN	DWG. No. 12012-W-63
DATE: DECEMBER, 2009	SHEET NO. OF

S11


VICTORIA S.P.S.

NOTE:
PROVIDED BY SEWERAGE AND WATER BOARD FOR INFORMATIONAL PURPOSES ONLY.




SEWERAGE AND WATER BOARD OF NEW ORLEANS	
CONTRACT 3668	
HURRICANE KATRINA RELATED 404 HAZARD MITIGATION GRANT PROGRAM REPLACEMENT OF VICTORIA SEWAGE PUMPING STATION	
REFERENCE DRAWING	
DR. ---	GENERAL SUPERINTENDENT
TRC. ---	
CK. ---	
AP. ---	
SCALE: AS SHOWN	DWG. No. 12039-W-63
DATE: JANUARY 2012	SHEET NO. 32

PRINTED Dec 08, 2009 - 3:04pm FILENAME = J:\6005 SPS Rehab. Project\DWG-EXHIBITS (FINAL SUBMITTAL)\STRUCTURAL\12_6005-STR-VICTORIA-02.dwg

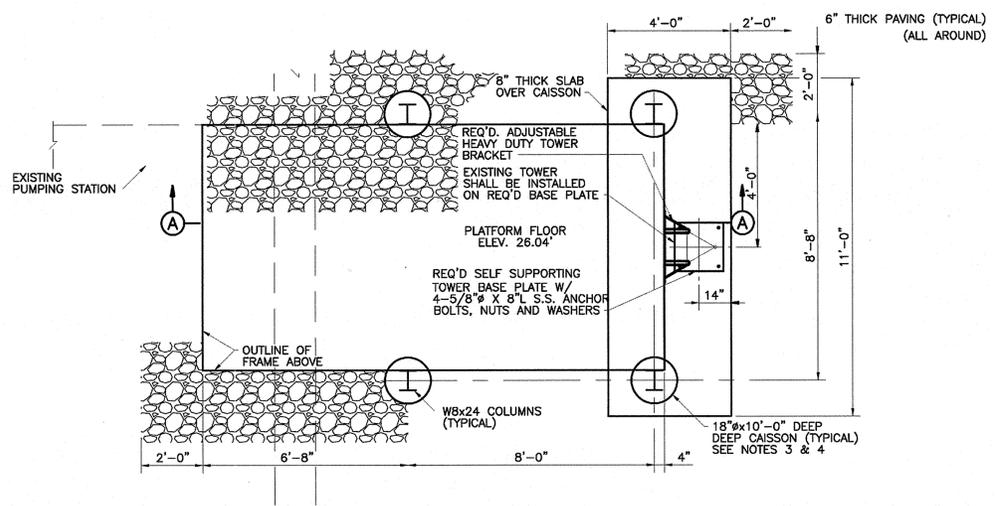

FOUNDATION PLAN
SCALE: 1/2" = 1'-0"
0 2 4

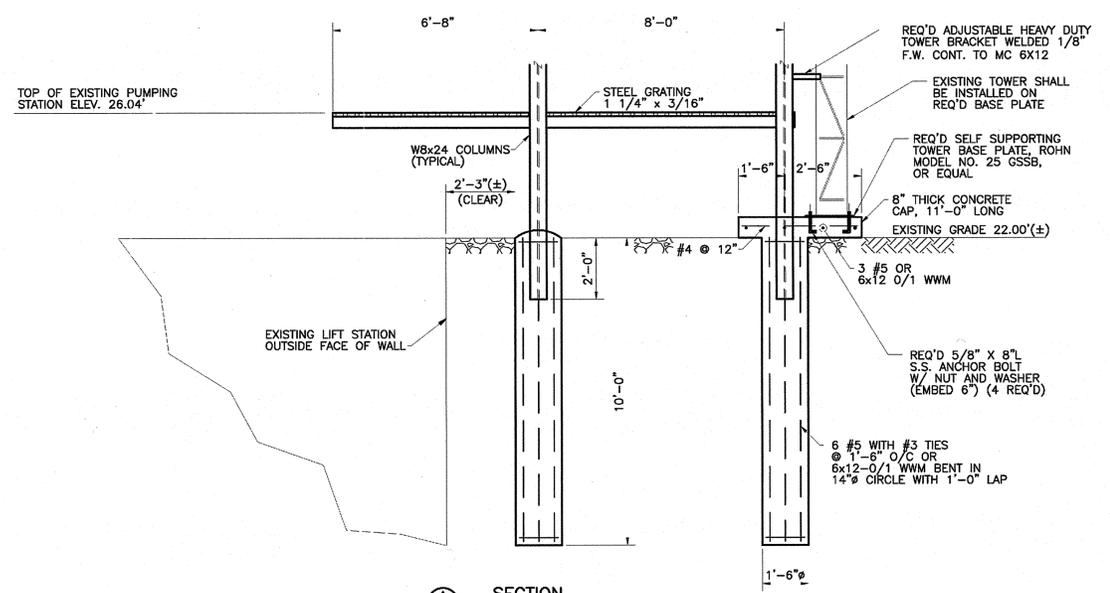

SECTION
SCALE: 1/2" = 1'-0"
0 2 4

NOTE:
HAND RAILINGS NOT SHOWN FOR CLARITY.

VICTORIA S.P.S.

NOTE:
FRAME IS DESIGNED FOR FOLLOWING LOADS:
1.) FLOOR LOAD: 100 PSF
2.) WIND SPEED: 130 MPH
3.) EXPOSURE: C
4.) IMPORTANCE FACTOR: 1.15

FOUNDATION NOTES:
1.) DRILLED SHAFT WORK SHALL BE PERFORMED BY CONTRACTOR EXPERIENCED IN THIS FIELD.
2.) ACCORDING TO EUSTIS SOIL REPORT GROUND WATER AFTER ELAPSED PERIOD OF 24 HOURS CAN BE EXPECTED AT 3' BELOW GROUND LEVEL.
3.) IF GROUND WATER IN THE HOLE IS 3" OR LESS, PLACE CEMENT AND SAND MIX FOR 3" THICK LAYER AND COMPACT IT PROPERLY BEFORE PLACING CONCRETE.
4.) THE CASING SHALL BE STEEL PIPE CONFORMING TO ASTM A 53 WITH A MINIMUM WALL THICKNESS OF 0.125" OR EQUAL. CONTRACTOR CAN USE CORRUGATED METAL PIPE CASING WHICH CAN WITHSTAND OUTSIDE CIRCUMFERENTIAL PRESSURE OF 8.00 PSI WITH A FACTOR OF SAFETY OF 2.00.
5.) CONCRETE SHALL BE PLACED IN TEMPORARY OR PERMANENT CASING AND IN THE DRY. REMOVE CASING WHILE CONCRETE IS BEING POURED. KEEP BOTTOM OF CASING 5' BELOW TOP OF CONCRETE SURFACE DURING WITHDRAWAL.
6.) BOLTS SHALL CONFORM TO ASTM F1554 Fy=55ksi

CONCRETE NOTES:
1.) CONCRETE SHALL HAVE COMPRESSIVE STRENGTH OF 3000 PSI AT 28 DAYS.
2.) REINFORCING BARS SHALL BE A615 AND WWM SHALL BE A185.



REV.	DATE	DESCRIPTION	BY
STRUCTURAL			
SEWERAGE AND WATER BOARD OF NEW ORLEANS			
CONTRACT 3663			
HURRICANE KATRINA RELATED REPAIRS TO BULLARD, DODD STREET, LAKE FOREST, PLUM ORCHARD LAWRENCE AND VICTORIA SEWAGE PUMPING STATIONS			
VICTORIA SEWAGE PUMPING STATION ELEVATED PLATFORM FOR ELECTRICAL EQUIPMENT			
DR. M.Z.			
TRC.			
CL. M.S.			
AP. J.H.			
SCALE: AS SHOWN			
DATE: DECEMBER, 2009	SET NO.		SHEET NO. 03

S12 DWG. No. 12012-W-63


NOTE:
PROVIDED BY SEWERAGE AND WATER BOARD FOR INFORMATIONAL PURPOSES ONLY.

REV.	DATE	DESCRIPTION	BY
SEWERAGE AND WATER BOARD OF NEW ORLEANS			
CONTRACT 3668			
HURRICANE KATRINA RELATED 404 HAZARD MITIGATION GRANT PROGRAM REPLACEMENT OF VICTORIA SEWAGE PUMPING STATION			
REFERENCE DRAWING			
DR. ---			
TRC. ---			
CL. ---			
AP. ---			
SCALE: AS SHOWN			
DATE: JANUARY 2012	SET NO.		SHEET NO. 33



DWG. No. 12039-W-63


PRINTED May 30, 2013 - 2:51pm FILENAME - J:\6005.1-GOSHEP-2013\Contract 3668 - Victoria SPS\ELECTRICAL\SHT 35_ELEC_VICTORIA_SITE_REV.dwg

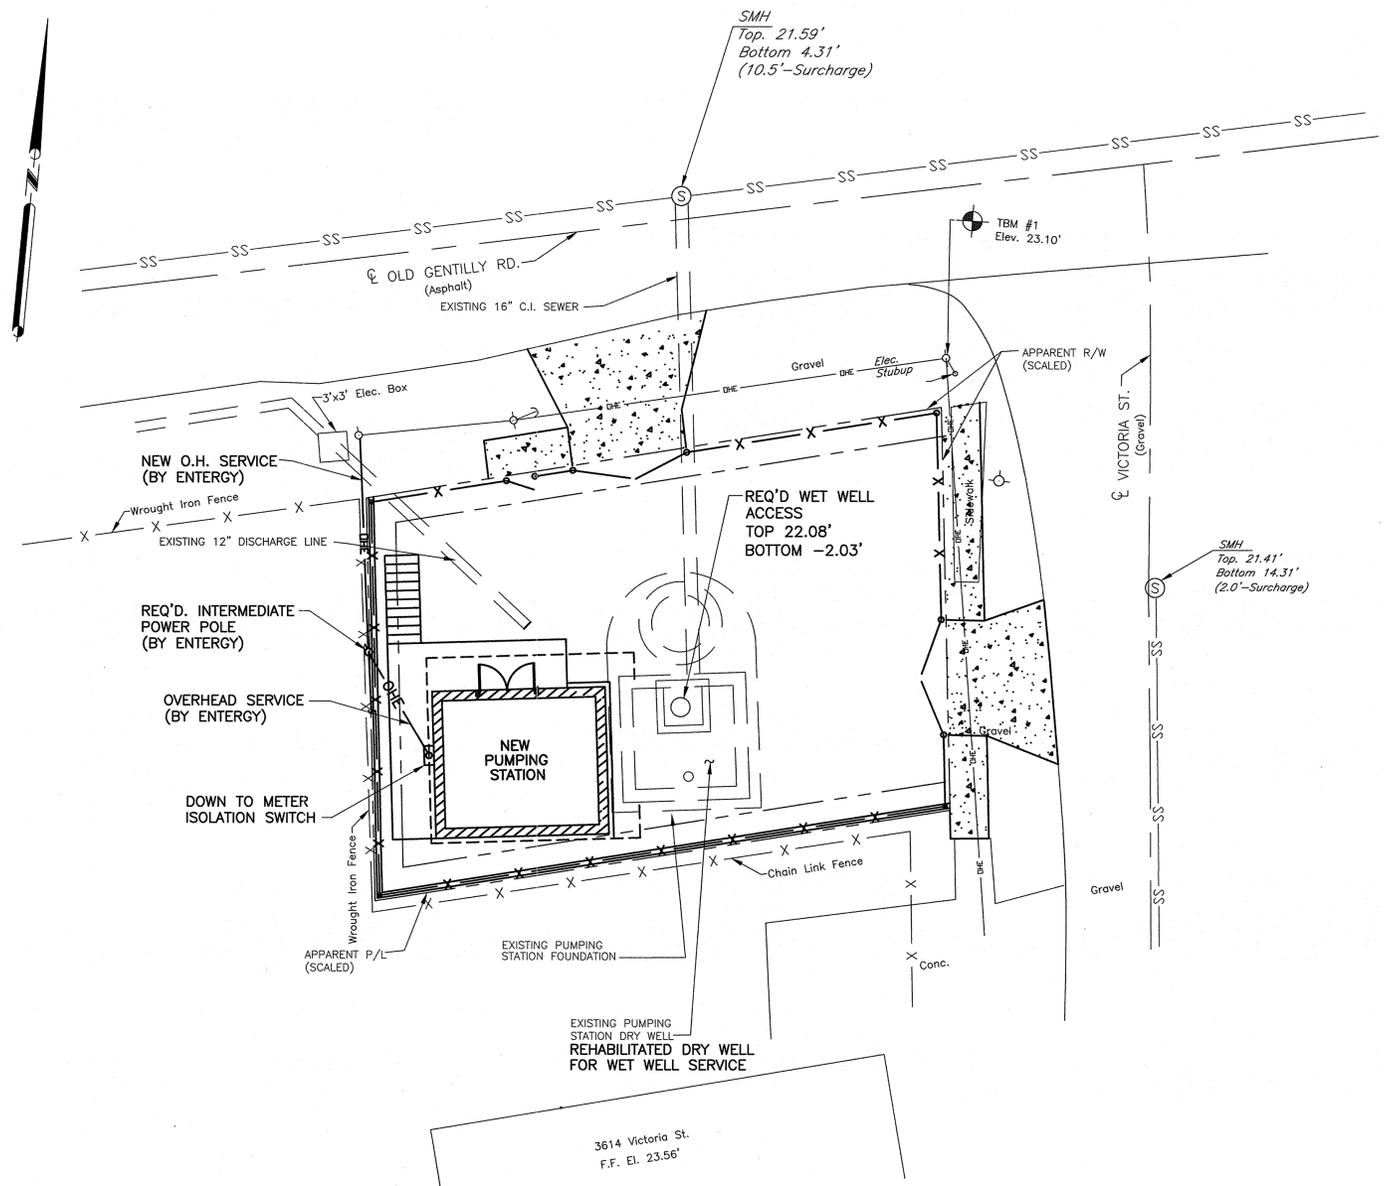

LEGEND

- ☼ Light Pole
- ⊕ Power Pole
- ← Guy Anchor
- ⊙ Drain Manhole
- ⊙ Sanitary Sewer Manhole
- ⊕ Station Tower
- ▲ Survey Baseline Point
- Sign
- ⊕ Fire Hydrant
- Bollard
- + 2000 Elevation Shot
- - - - - Existing Fence
- - - - - Overhead Power Line
- - - - - Sanitary Sewer Line
- - - - - Existing Underground Electric Service
- - - - - Required Underground Electric Service
- - - - - Required Overhead Electric Service
- ⊕ TBM #1 - 80d NAIL IN P.P. CORNER OF VICTORIA ST. AND OLD GENTILLY RD., ELEV. = 23.10 C.D.


REQUIRED ELECTRICAL SITE PLAN

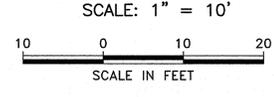

NOTE:
 THE EXISTING PUMPING STATION AND ELEVATED ELECTRICAL PLATFORM SHALL REMAIN IN-SERVICE FOR AS LONG AS POSSIBLE DURING THE CONSTRUCTION OF THE NEW PUMPING STATION BUILDING. WHEN THE PLATFORM IS REMOVED, THE FOLLOWING ELECTRICAL EQUIPMENT SHALL BE REMOVED FROM THE ELECTRICAL PLATFORM AND RE-INSTALLED IN THE NEW STATION BUILDING:


- A) AIR COMPRESSOR
- B) GENERATOR RECEPTACLE
- C) SCADA PANEL

ALL OTHER ELECTRICAL EQUIPMENT SHALL BE RETURNED TO SWBNO.

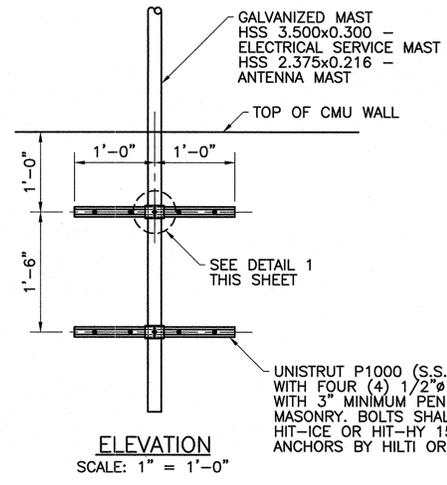

ELEVATION
 SCALE: 1" = 1'-0"

SUGGESTED MAST ANCHORING DETAIL

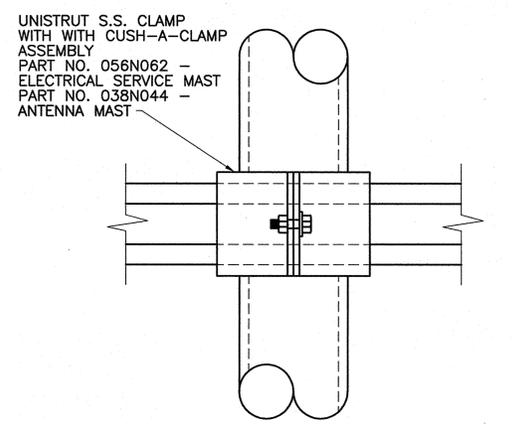


DETAIL 1
UNISTRUT CLAMP DETAIL
 SCALE: N.T.S.





ELECTRICAL			
REV.	DATE	DESCRIPTION	BY
SEWERAGE AND WATER BOARD OF NEW ORLEANS			
CONTRACT 3668			
HURRICANE KATRINA RELATED			
404 HAZARD MITIGATION GRANT PROGRAM			
REPLACEMENT OF VICTORIA SEWAGE PUMPING STATION			
ELECTRICAL - REQUIRED SITE PLAN			
DR. MZ			
TRC. --			
CK. DS/CW			
AP. NH			
SCALE: AS SHOWN		DWG. No. 5030-P1	
DATE: JANUARY 2012	SET NO.		SHEET NO. 35

PRINTED May_30_2013 2:53pm FILENAME J:\6005.1-GOSHEP-2013\Contract 3668 - Victoria SPS\ELECTRICAL\SHIT_36_ELEC_VIC_ONLINE_REV_GOSHEP.dwg

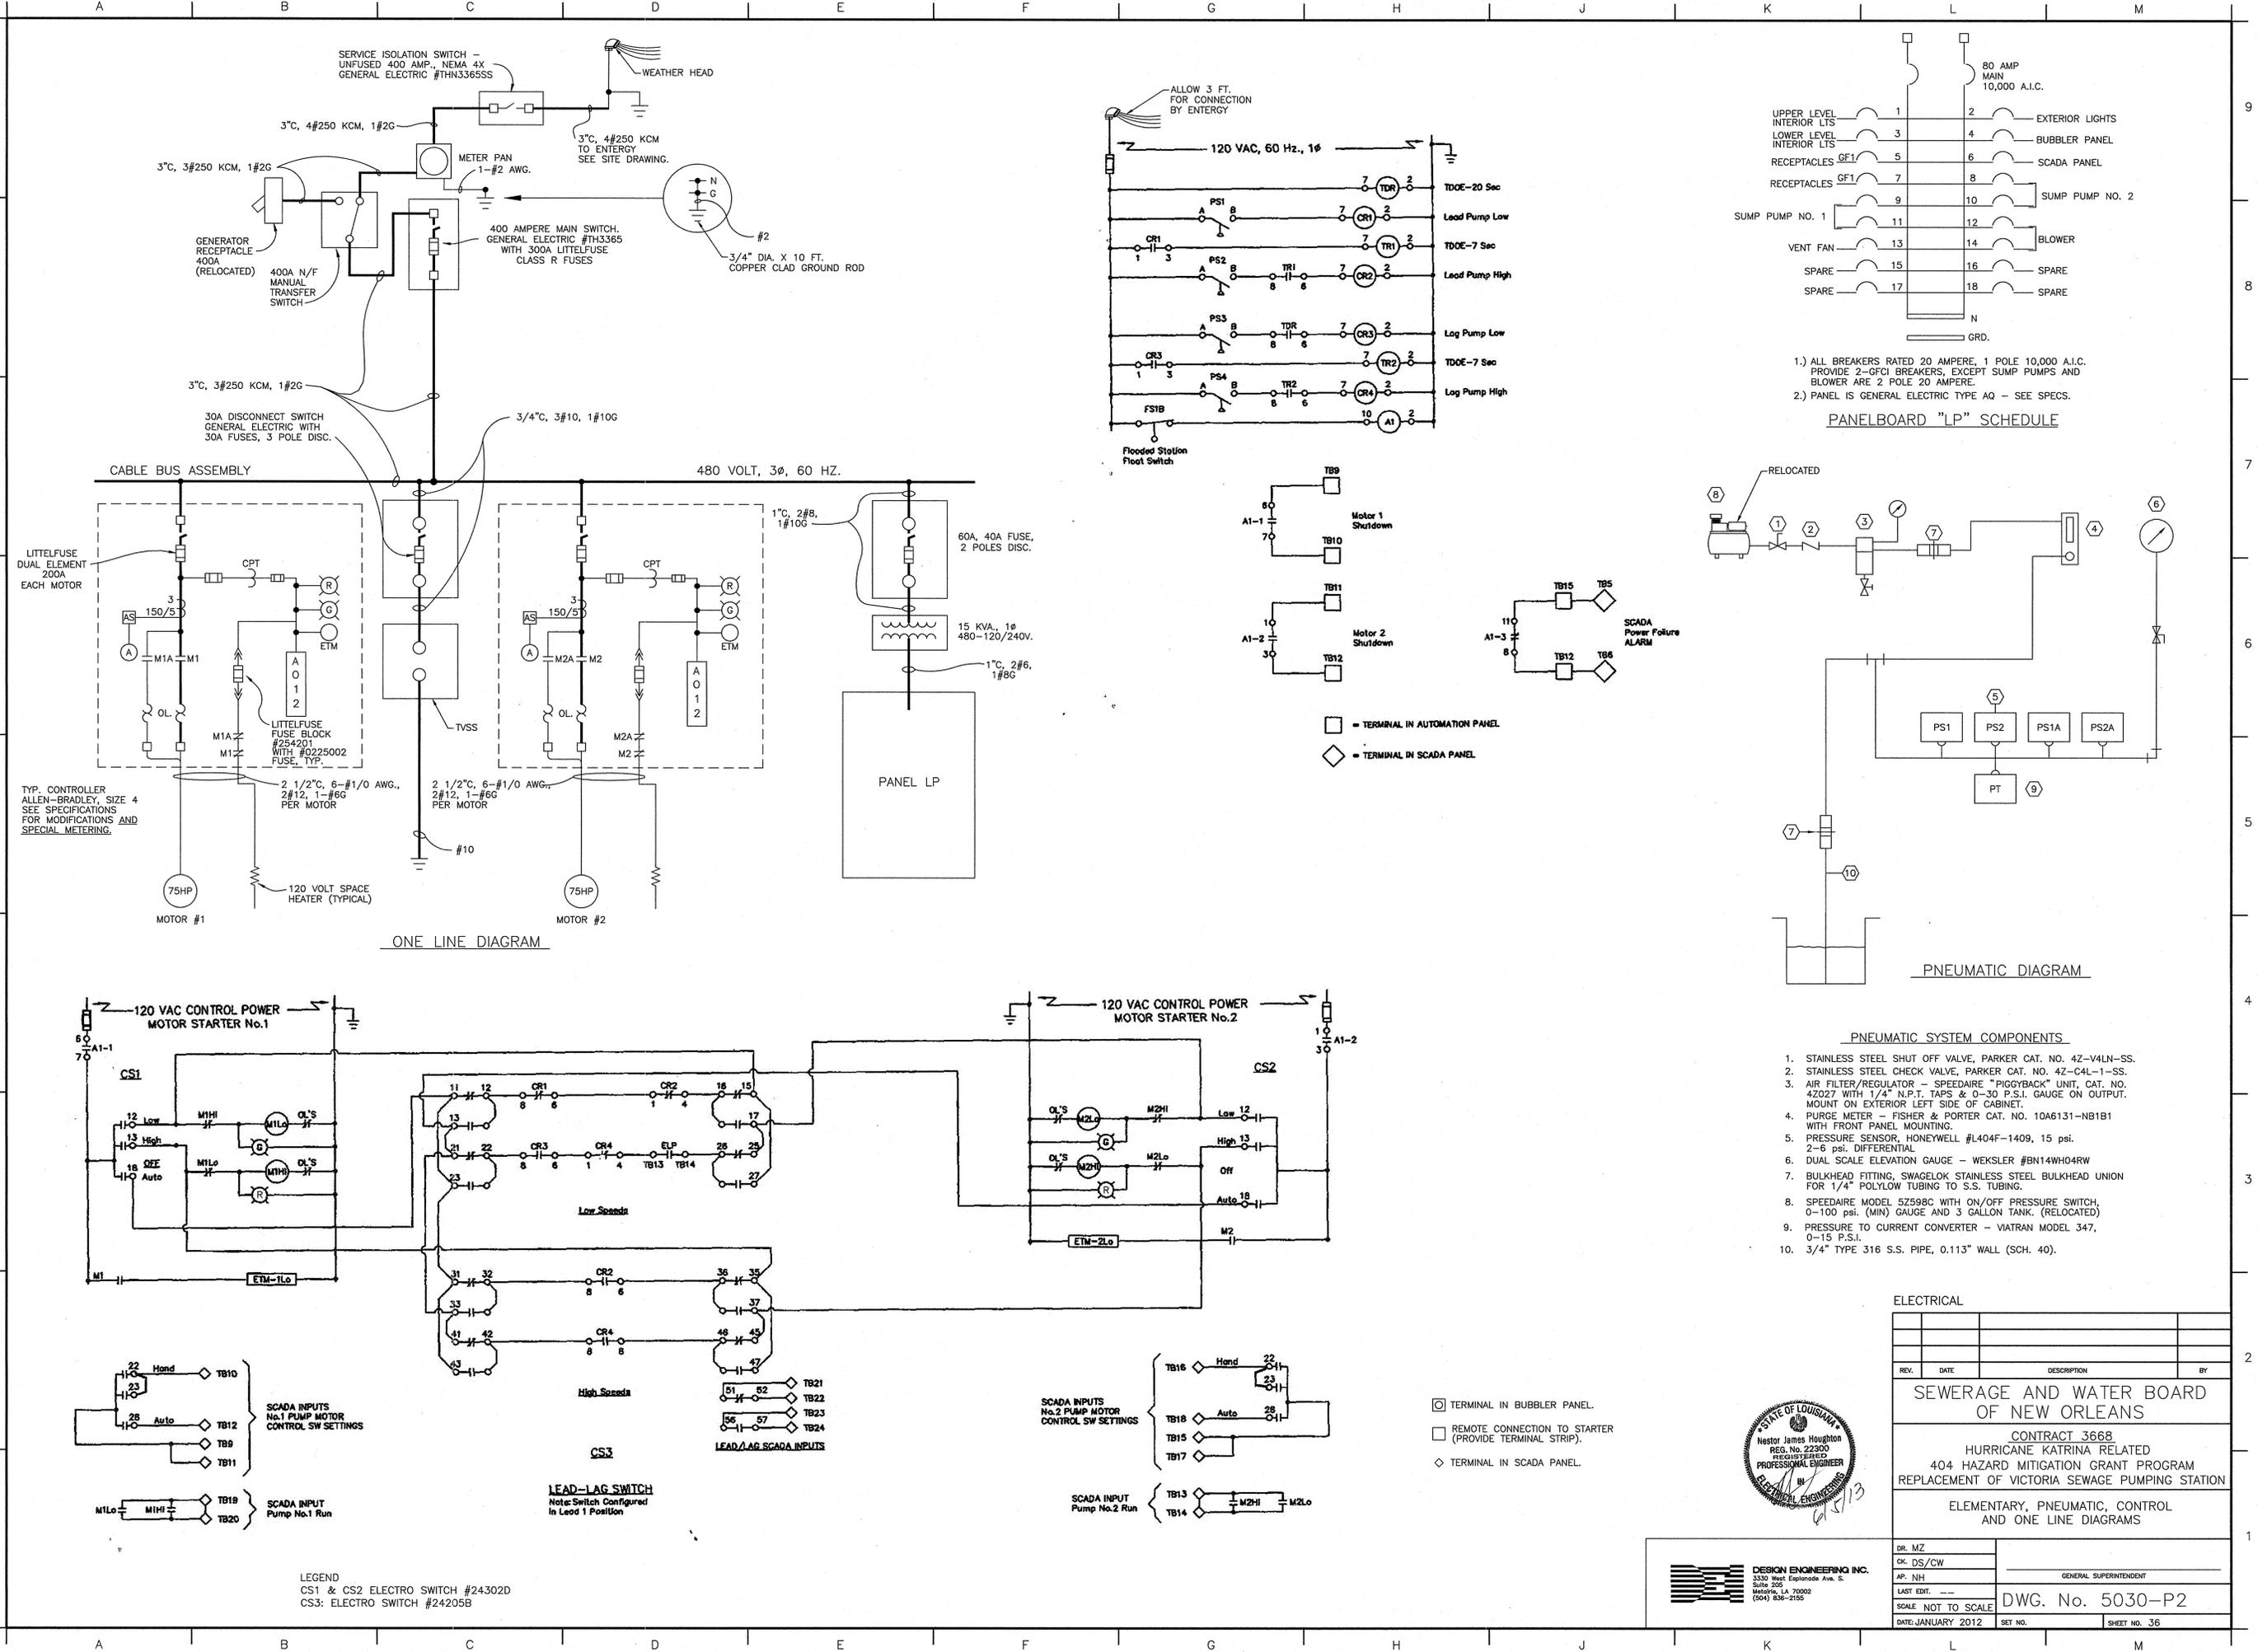


ONE LINE DIAGRAM

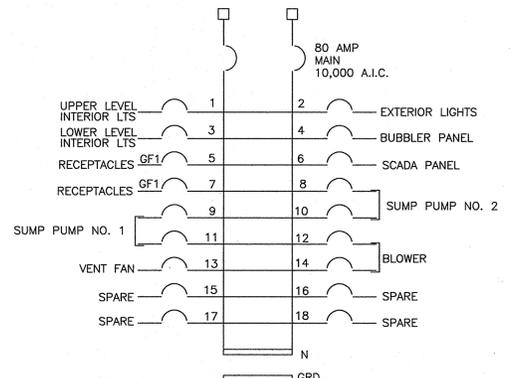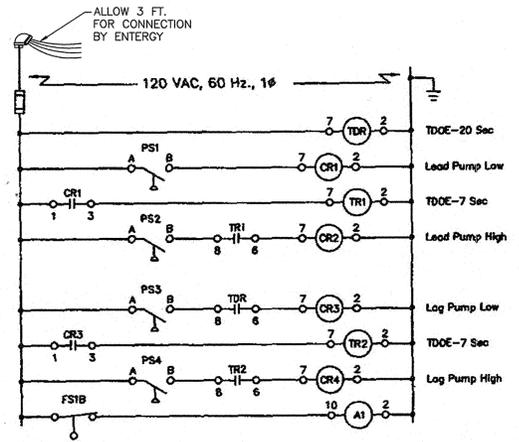

1.) ALL BREAKERS RATED 20 AMPERE, 1 POLE 10,000 A.I.C. PROVIDE 2-GFCI BREAKERS, EXCEPT SUMP PUMPS AND BLOWER ARE 2 POLE 20 AMPERE.
2.) PANEL IS GENERAL ELECTRIC TYPE AQ - SEE SPECS.



PANELBOARD "LP" SCHEDULE

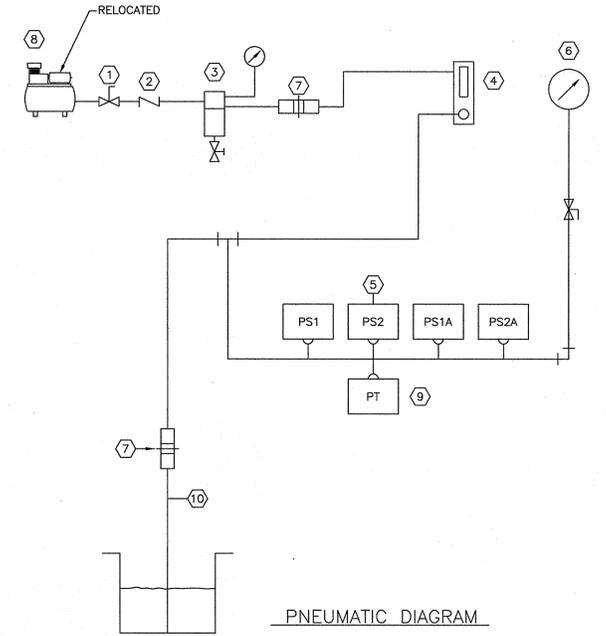

PNEUMATIC DIAGRAM

PNEUMATIC SYSTEM COMPONENTS

1. STAINLESS STEEL SHUT OFF VALVE, PARKER CAT. NO. 4Z-V4LN-SS.
2. STAINLESS STEEL CHECK VALVE, PARKER CAT. NO. 4Z-C4L-1-SS.
3. AIR FILTER/REGULATOR - SPEEDAIRE "PIGGYBACK" UNIT, CAT. NO. 4Z027 WITH 1/4" N.P.T. TAPS & 0-30 P.S.I. GAUGE ON OUTPUT. MOUNT ON EXTERIOR LEFT SIDE OF CABINET.
4. PURGE METER - FISHER & PORTER CAT. NO. 10A6131-NB1B1 WITH FRONT PANEL MOUNTING.
5. PRESSURE SENSOR, HONEYWELL #L404F-1409, 15 psi. 2-6 psi. DIFFERENTIAL
6. DUAL SCALE ELEVATION GAUGE - WEKSLER #BN14WH04RW
7. BULKHEAD FITTING, SWAGelok STAINLESS STEEL BULKHEAD UNION FOR 1/4" POLYLOW TUBING TO S.S. TUBING.
8. SPEEDAIRE MODEL 5Z598C WITH ON/OFF PRESSURE SWITCH, 0-100 psi. (MIN) GAUGE AND 3 GALLON TANK. (RELOCATED) 0-15 P.S.I.
9. PRESSURE TO CURRENT CONVERTER - VIATRAN MODEL 347, 0-15 P.S.I.
10. 3/4" TYPE 316 S.S. PIPE, 0.113" WALL (SCH. 40).

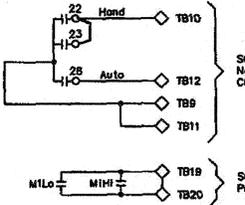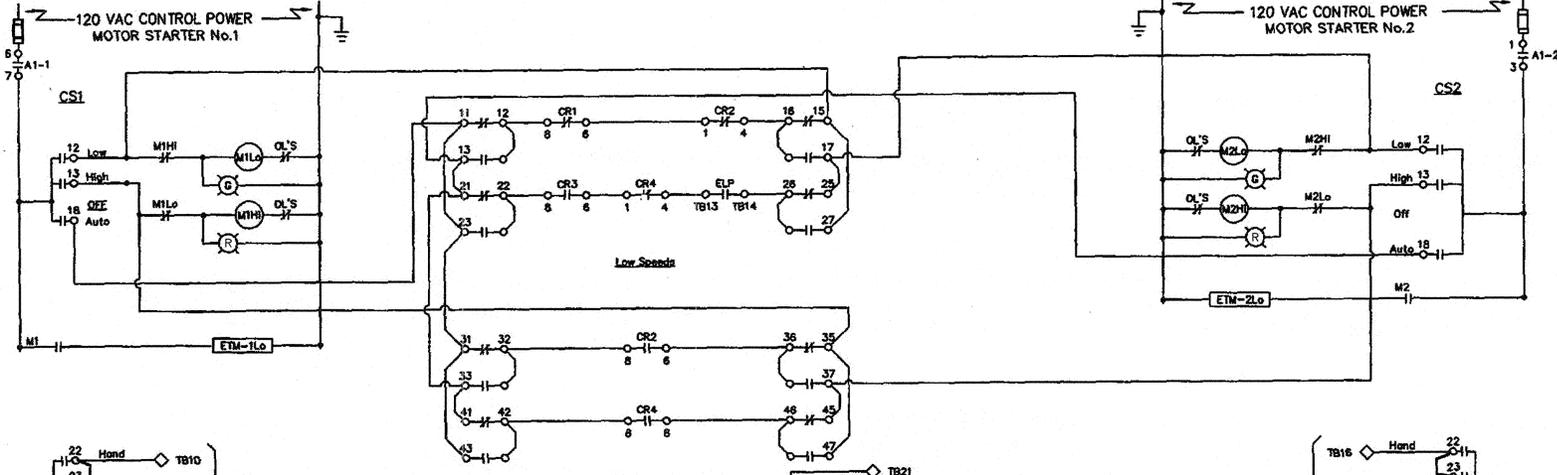

LEGEND
CS1 & CS2 ELECTRO SWITCH #24302D
CS3: ELECTRO SWITCH #24205B

SCADA INPUTS No. 2 PUMP MOTOR CONTROL SW SETTINGS

SCADA INPUT Pump No. 2 Run

- ☐ TERMINAL IN BUZZER PANEL.
- ☐ REMOTE CONNECTION TO STARTER (PROVIDE TERMINAL STRIP).
- ◇ TERMINAL IN SCADA PANEL.



DESIGN ENGINEERING INC.
3330 West Esplanade Ave. 2
Suite 205
Metairie, LA 70002
(504) 836-2155





ELECTRICAL			
REV.	DATE	DESCRIPTION	BY
SEWERAGE AND WATER BOARD OF NEW ORLEANS			
CONTRACT 3668 HURRICANE KATRINA RELATED 404 HAZARD MITIGATION GRANT PROGRAM REPLACEMENT OF VICTORIA SEWAGE PUMPING STATION			
ELEMENTARY, PNEUMATIC, CONTROL AND ONE LINE DIAGRAMS			
DR. MZ			
CK. DS/CW			
AP. NH			
LAST EDIT. ---			
SCALE NOT TO SCALE		DWG. No. 5030-P2	
DATE: JANUARY 2012	SET NO.		SHEET NO. 36

PRINTED May 30, 2013 2:54pm FILENAME - J:\6005.1-GOSHEP-2013\Contract 3688 - Victoria SPS\ELECTRICAL\SH1_37_ELEC_VICTORIA_BLDG_FP_EXT_REV_GOSHEP.dwg

A B C D E F G H J K L M

9
8
7
6
5
4
3
2
1

- LEGEND**
- F1 WALL MOUNT FLUORESCENT FIXTURE, COLUMBIA #WPM4-232-EU
 - F2 WALL MOUNT FLUORESCENT FIXTURE, COLUMBIA #FNPV4-232-CA-EU24-SS WITH #PTBA WALL BRACKET
 - F3 WALL PACK OUTDOOR FIXTURE, HUBBELL #FRM-150S-118
 - POWER CONDUIT DROP INTO SLAB.
 - ⊕ DUPLEX RECEPTACLE, HUBBELL #5362
 - ⊕ LIGHT SWITCH, HUBBELL #1221
 - ⊕ PHOTOCELL, HUBBELL #PTA-1
 - DASHED CONDUIT; ENCASED IN SLAB.
 - ⊕ SINGLE POLE MOTOR STARTING SWITCH ALLEN BRADLEY #600-TAX 216
 - ⊕ DOUBLE POLE MOTOR STARTING SWITCH ALLEN BRADLEY #600-TAX 109

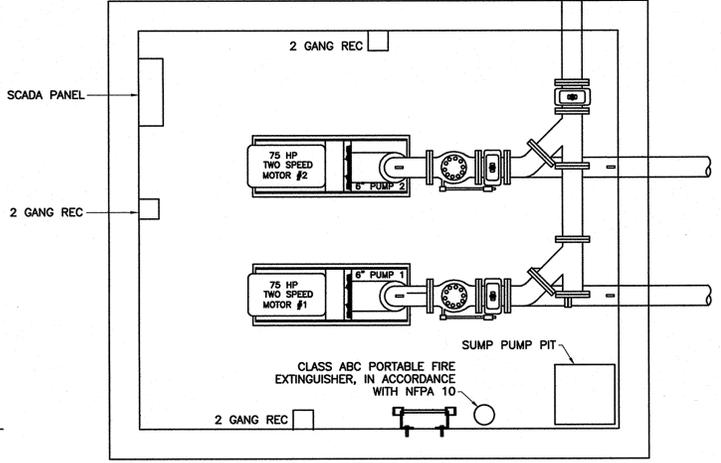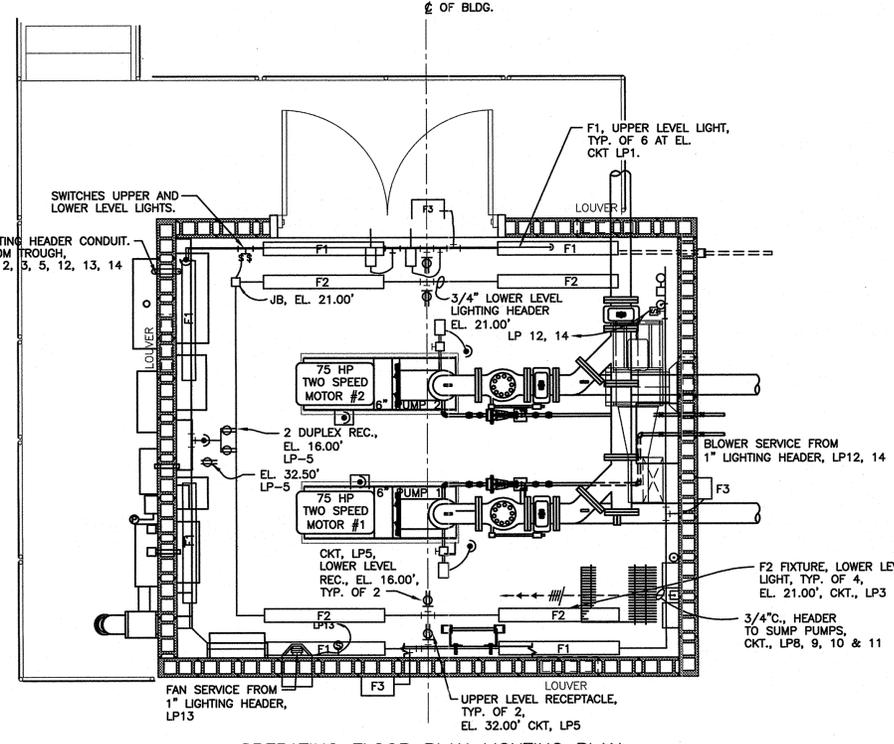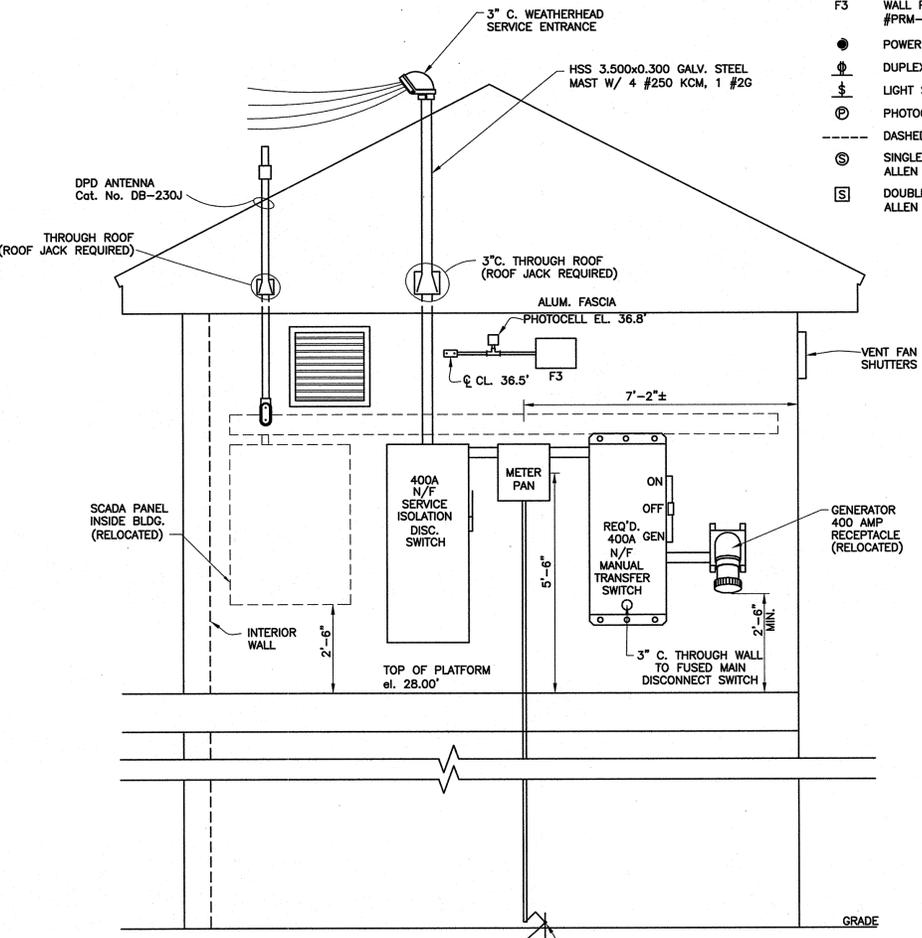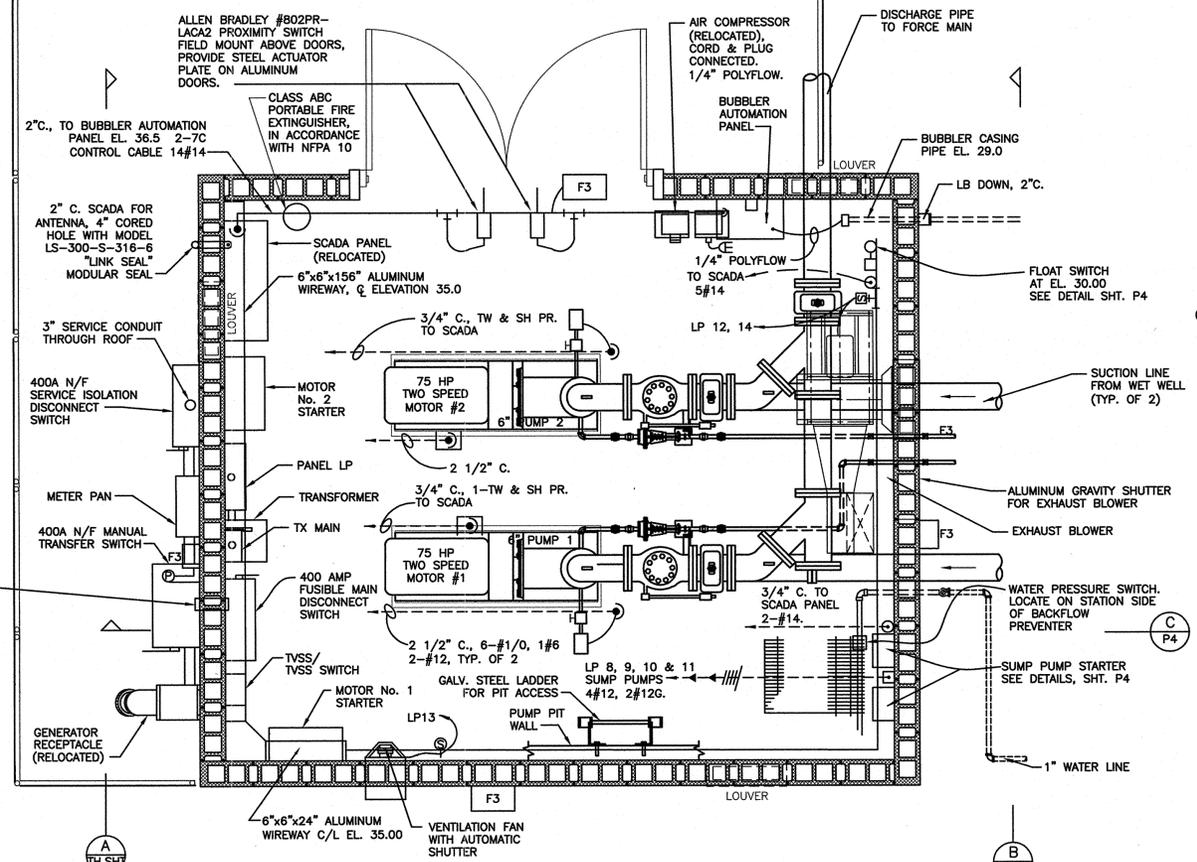

DESIGN ENGINEERING INC.
3330 West Esplanade Ave. S.
Suite 205
Metairie, LA 70002
(504) 885-2155

REV.	DATE	DESCRIPTION	BY

ELECTRICAL


SEWERAGE AND WATER BOARD OF NEW ORLEANS

CONTRACT 3688
HURRICANE KATRINA RELATED
404 HAZARD MITIGATION GRANT PROGRAM
REPLACEMENT OF VICTORIA SEWAGE PUMPING STATION

ELECTRICAL FLOOR PLAN, EXTERIOR WALL ELEVATIONS AND DETAILS


DR. MZ	
CK. DS/CW	
AP. NH	GENERAL SUPERINTENDENT
DATE: JANUARY 2012	SET NO.
SCALE: AS SHOWN	DWG. No. 5030-P3
	SHEET NO. 37

PRINTED May 30, 2013 2:56pm FILENAME J:\6005.1-GOSHEP-2013\Contract 3688 - Victoria SPS\ELECTRICAL\Bldg_Interior_Rev_Coshep.dwg

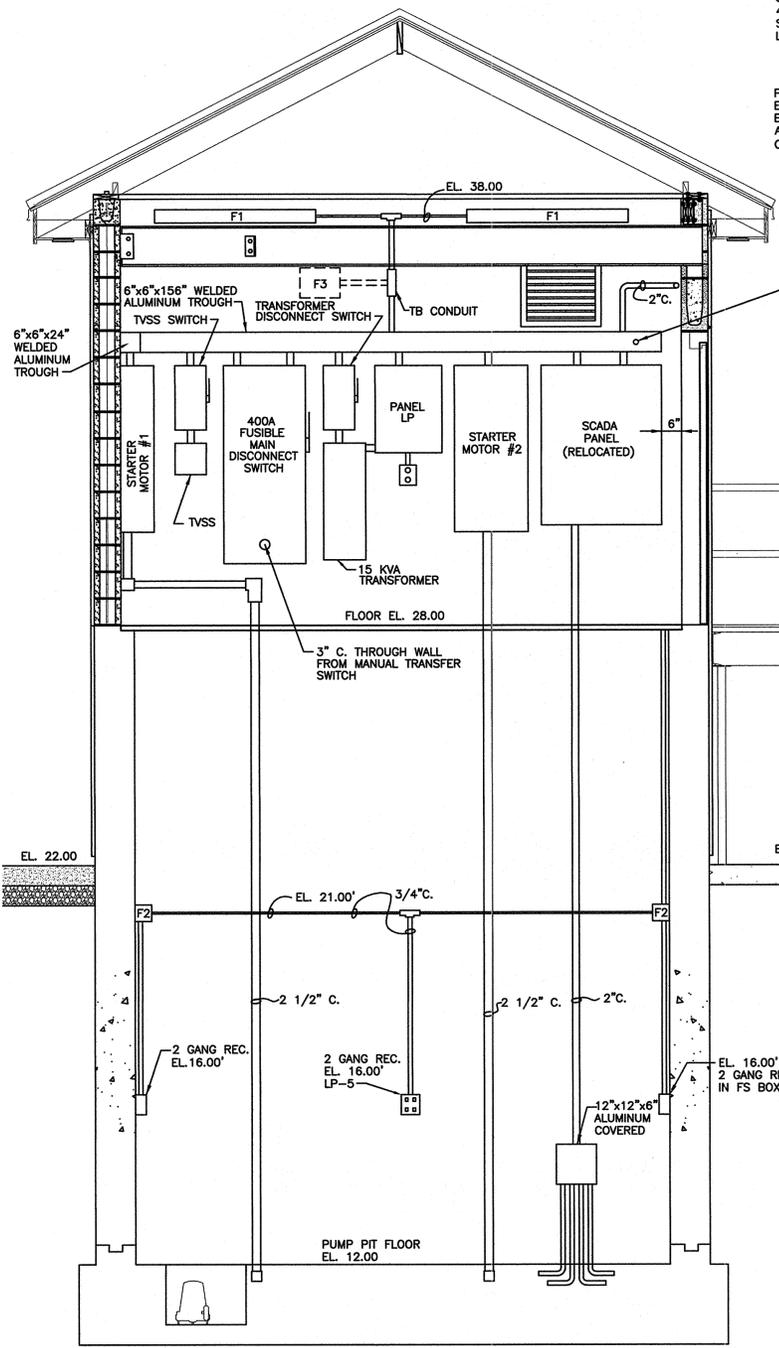


B
P3 CROSS-SECTION OF BUILDING
SCALE: 1/2" = 1'-0"
2' 0' 2'


NOTE:
1. THE GROUND WIRE MUST BE TAPPED IN THE TROUGH FOR ALL LOADS.

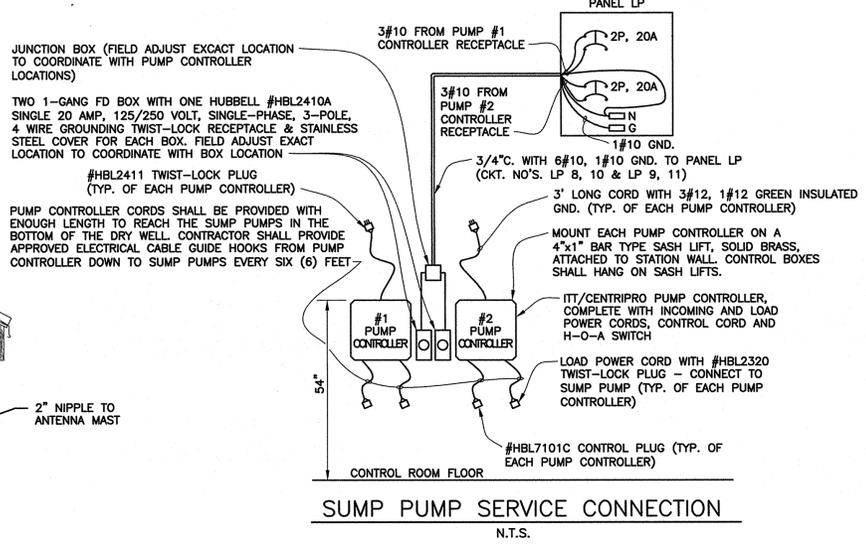

SUMP PUMP SERVICE CONNECTION
N.T.S.

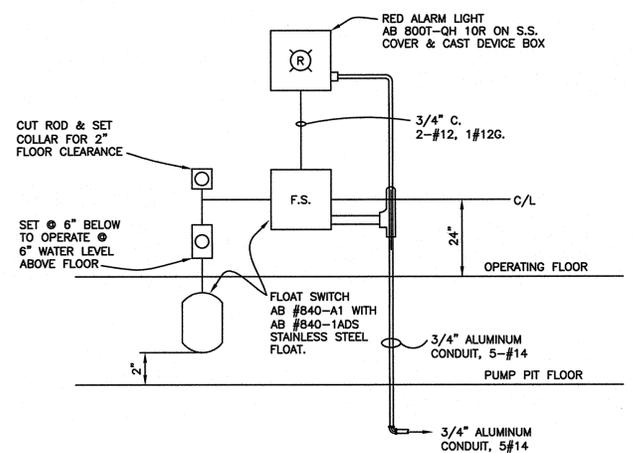

FLOODED STATION SWITCH
N.T.S.

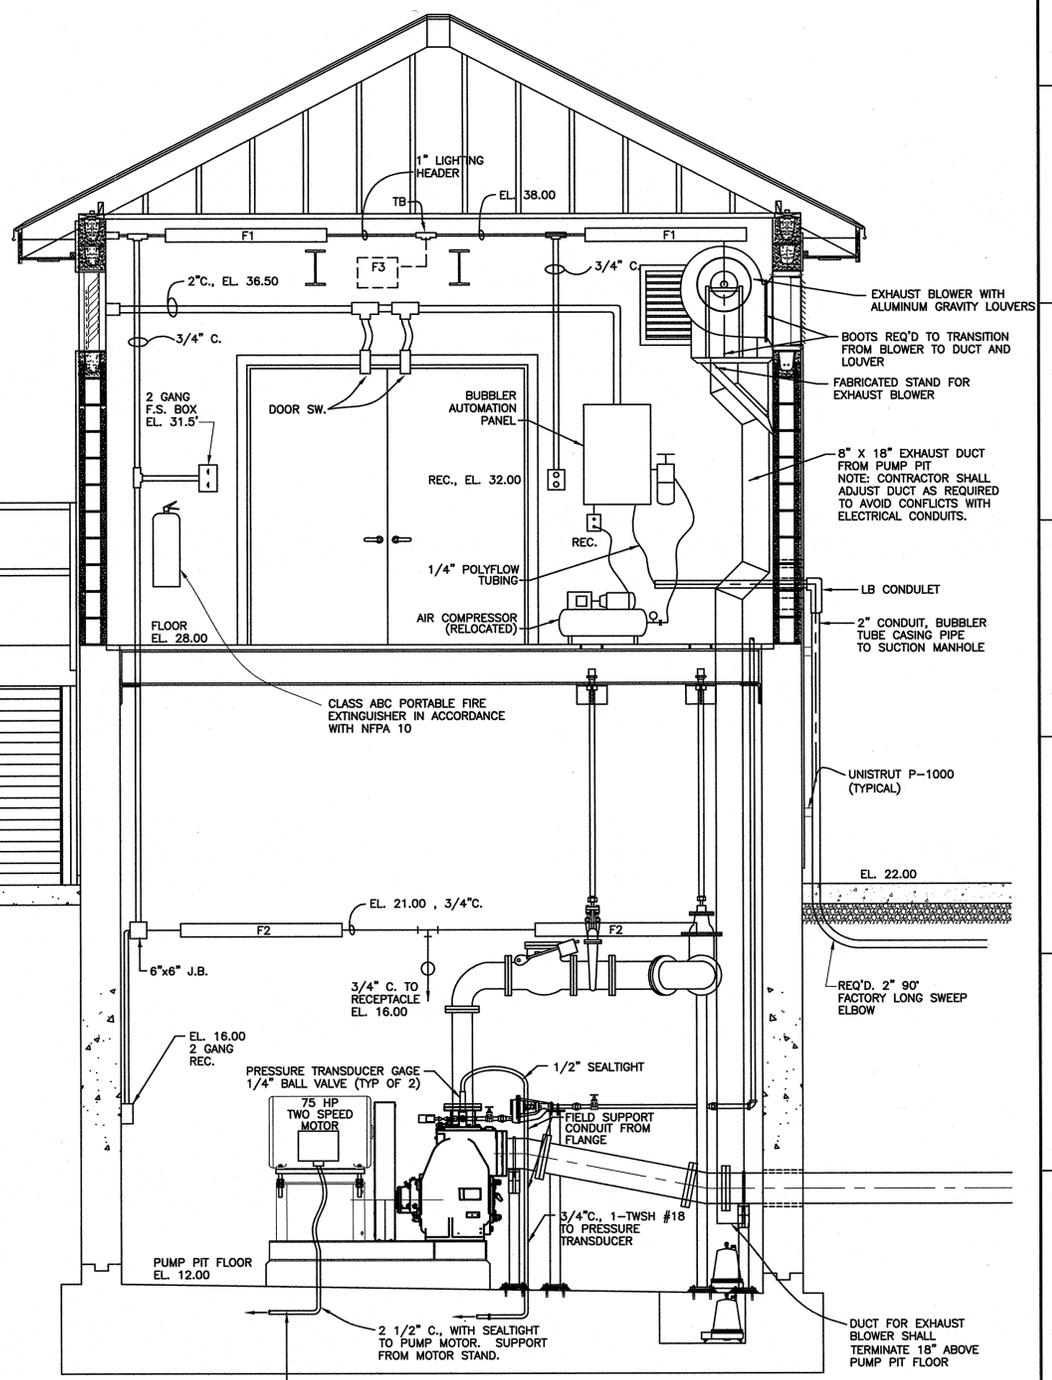


C
P3 LONGITUDINAL SECTION OF BUILDING
SCALE: 1/2" = 1'-0"
2' 0' 2'



DESIGN ENGINEERING INC.
3330 West Esplanade Ave. S.
Suite 205
Metairie, LA 70002
(504) 886-2155


ELECTRICAL			
REV.	DATE	DESCRIPTION	BY
SEWERAGE AND WATER BOARD OF NEW ORLEANS			
CONTRACT 3688 HURRICANE KATRINA RELATED 404 HAZARD MITIGATION GRANT PROGRAM REPLACEMENT OF VICTORIA SEWAGE PUMPING STATION			
ELECTRICAL INTERIOR WALL ELEVATIONS AND DETAILS			
DR. TH			
TRC. --			
CK. DS/CW			
AP. NH			
SCALE: AS SHOWN	DWG. No. 5030-P4		
DATE: JANUARY 2012	SET NO.		SHEET NO. 38

PRINTED May 30, 2013 - 2:58pm FILENAME - J:\6005.1-GOSHEP-2013\Contract 3668 - Victoria SPS\ELECTRICAL\Bldg_AUTO_PANEL_REV.dwg

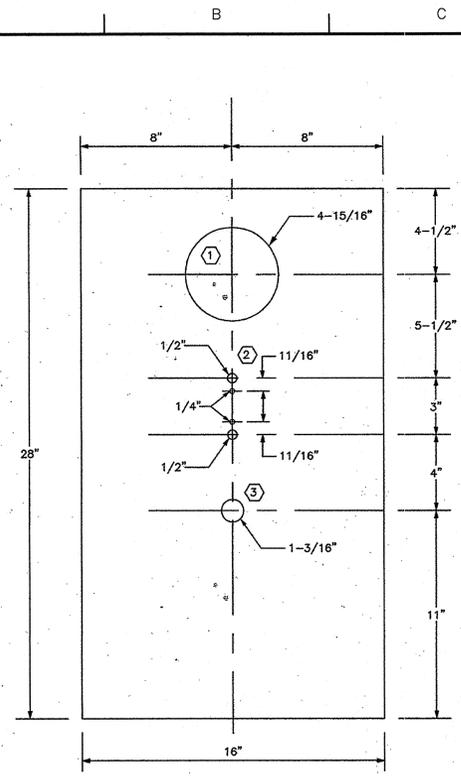


KNOCKOUT & DRILLING PLAN OF DOOR
SCALE: 3/4"=1'-0"


BILL OF MATERIALS			
ITEM #	QUANTITY	MANUFACTURER	DESCRIPTION
1	1	WEKSLER	MODEL # BN14WH04RW, FLUSH MOUNT, 4" GAUGE DUAL SCALE: 0-15 P.S.I. & 0-35 FEET OF WATER
2	1	FISCHER & PORTER	PURGE METER, CAT. # 10A6131-NB1B1 WITH 1/4" CONNECTIONS
3	1	ELECTRO SWITCH	LEAD/LAG CONTROL SWITCH, # 24205B WITH ESCUTOCHEN ENGRAVED: "LEAD #1 - LEAD #2"
4	1	GOULD-SHAWMUT	250 VOLT, 30 AMP, 2 POLE FUSEBLOCK # 20302
5	1 LOT	ALLEN BRADLEY	TERMINAL STRIP, COMPOSED OF # 1492-N1<ERMINALS, #1492-N1 MOUNTING RAIL # 1492-N3& END BARRIERS & # 1492-N23 TERMINAL END ANCHORS
6	4	POTTER & BRUMFIELD	CONTROL RELAYS # KRPA-11AG-120 WITH BASE # 27E122
7	1	POTTER & BRUMFIELD	CONTROL RELAY # KRPA-14AG-120 WITH BASE #27E123
8	3	POTTER & BRUMFIELD	TIMING RELAY # CHB-38-70002 WITH BASE # 27E122
9	4	HONEYWELL	#L404F-1409 PRESSURE SWITCH, RATED AT 15 P.S.I WITH ADJUSTABLE DIFFERENTIAL 2-6 P.S.I & 50 P.S.I SURGE PRESSURE RATING, SWITCH OPERATES ON RISING EDGE.
10	1	VIATRAN	MODEL 347, 0-15 psi, PRESSURE TRANSDUCER WITH STAINLESS STEEL WIRING CAP.
11	1	HOFFMAN	ENCLOSURE # A-302010LP WITH #A30P20 MOUNTING PANEL, MODIFIED FOR # A-L2BR THREE POINT LATCH, & #C-415A KEY LOCK
12	1	AIR COMPRESSOR	RELOCATED

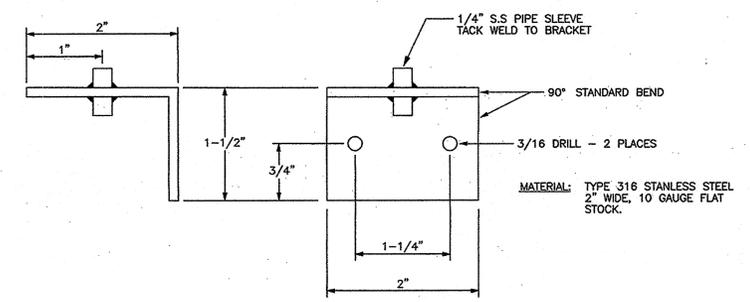

FRONT VIEW
AUTOMATION PANEL TRANSDUCER BRACKET
SCALE: 1"=1'-0"

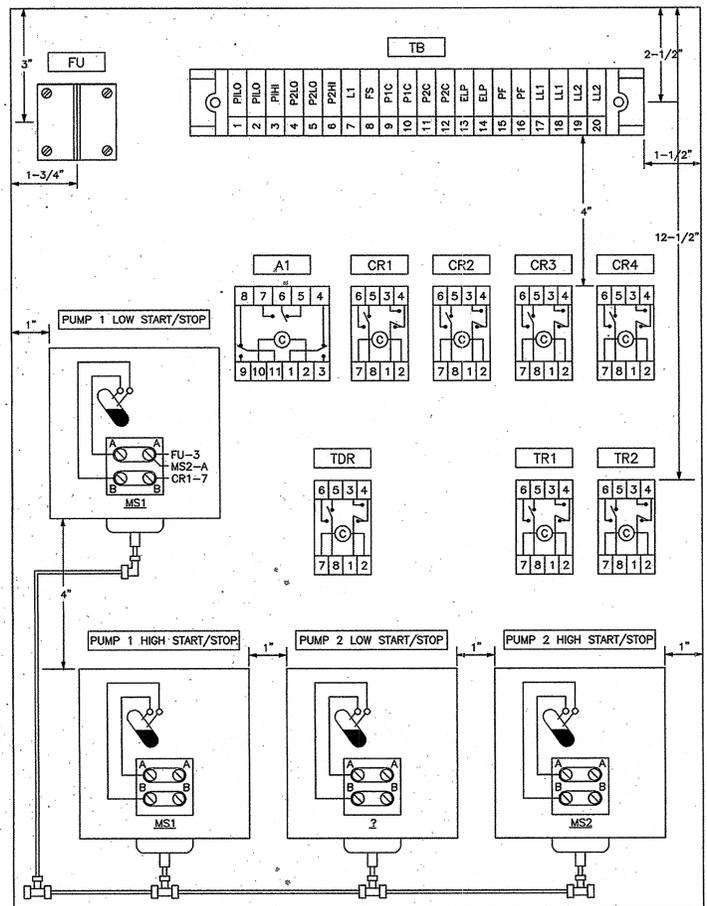

MOUNTING PANEL DEVICE LAYOUT
SCALE 1/2"=1'-0"

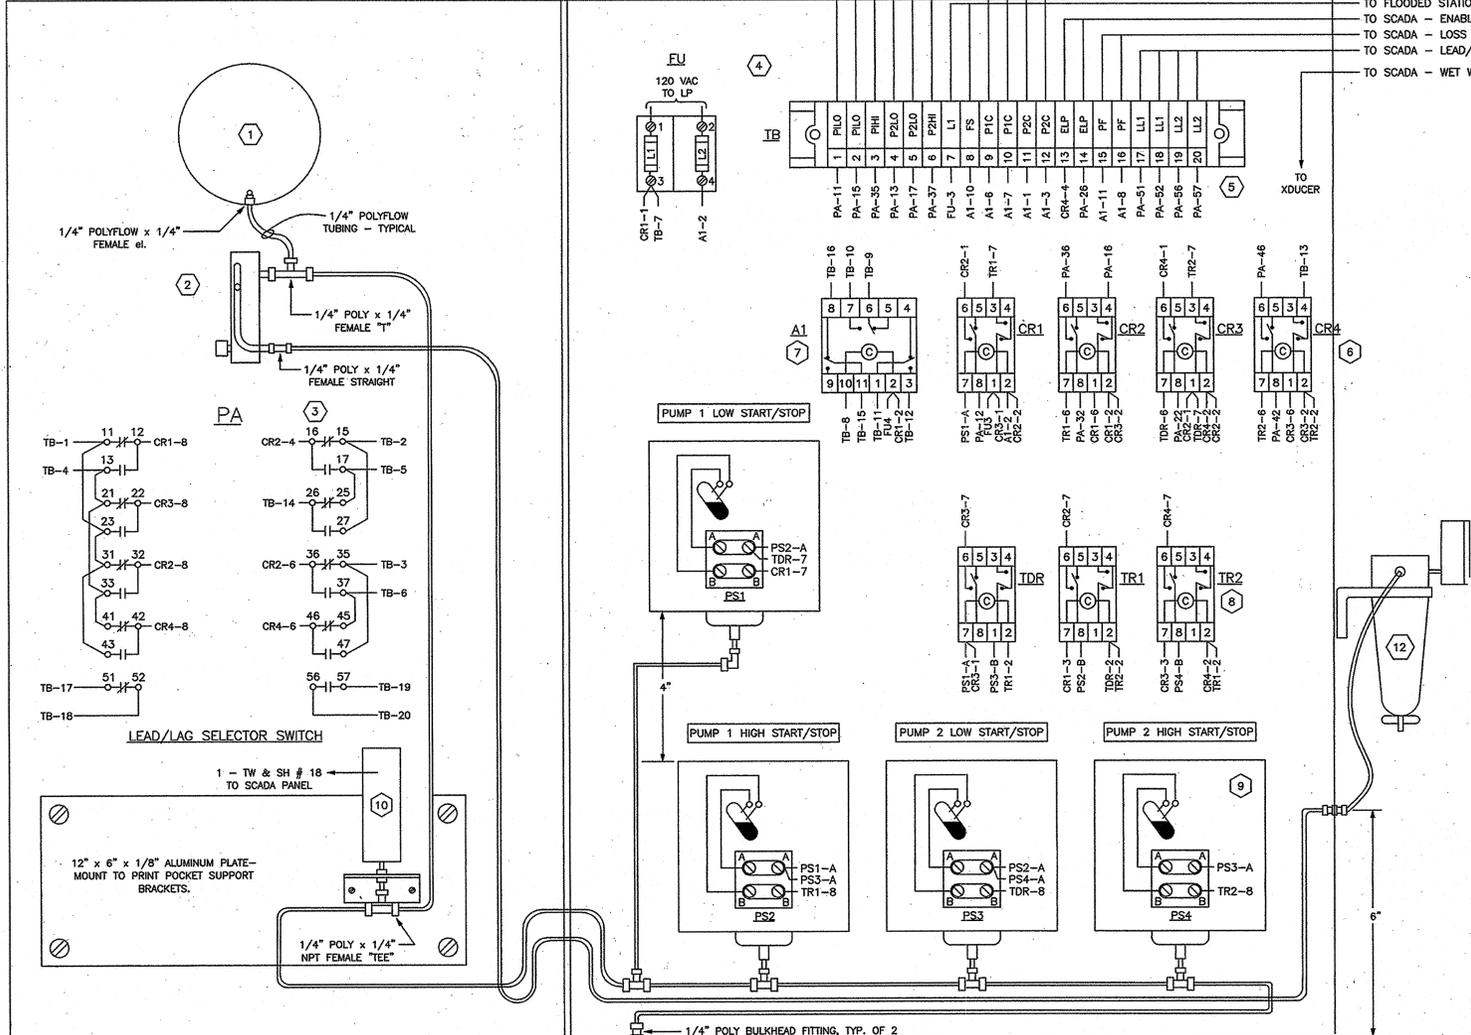


FRONT DOOR WIRING - REAR VIEW

PHYSICAL WIRING DIAGRAM


- CONTROL TO PUMP # 1 STARTER - LOW SPEED/HIGH SPEED
- CONTROL TO PUMP # 2 STARTER - LOW SPEED/HIGH SPEED
- TO FLOODED STATION FLOAT SW. (N.C. CONTACT)
- TO SCADA - ENABLE LAG PUMP
- TO SCADA - LOSS OF POWER
- TO SCADA - LEAD/LAG PUMP INPUT
- TO SCADA - WET WELL LEVEL, 1 - TW & SH PR.

ELECTRICAL			
REV.	DATE	DESCRIPTION	BY
SEWERAGE AND WATER BOARD OF NEW ORLEANS			
CONTRACT 3668 HURRICANE KATRINA RELATED 404 HAZARD MITIGATION GRANT PROGRAM REPLACEMENT OF VICTORIA SEWAGE PUMPING STATION			
AUTOMATION CONTROL PANEL FABRICATION AND WIRING			
DR. MZ			
CK. DS/CW			
AP. NH			GENERAL SUPERINTENDENT
LAST EDIT: ---			
SCALE AS SHOWN		DWG. No. 5030-P5	
DATE JANUARY 2012	SET NO.		SHEET NO. 39

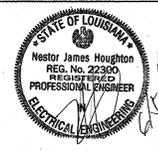

PRINTED May 30, 2013 2:59pm FILENAME -- J:\6005.1-GOSHEP-2013\Contract 3668 - Victoria SPS\ELECTRICAL\SHIT 40_ELEC_VICTORIA_BLDG_SCADA_REV.dwg

CIRCUIT ID	CONDUCTORS	DESTINATION/FUNCTION	REMARKS
a	3-#12 AWG. THHN/THWN	LIGHTING PANEL TO DATA SYSTEM ENCLOSURE. MAIN SOURCE OF POWER.	ROUTE IN STATION WIRING TROUGH. BUNDLE AND TIE-WRAP.
b	8-#14 AWG. THHN/THWN	ENCLOSURE TO STATION AUTOCON PANEL - TO INDICATE LEAD/LAG, POWER ALARM, LAG PUMP START.	ROUTE IN STATION WIRING TROUGH. BUNDLE AND TIE-WRAP.
c	5-#14 AWG. THHN/THWN	FLOODED STATION FLOAT SWITCH AND ALARM CHECK PILOT TO SCADA PANEL AND TO AUTOCON PANEL.	ROUTE FROM SCADA TO AUTOCON IN WIRING TROUGH. BUNDLE AND TIE-WRAP. 2-#14.
d	1 TW SH PAIR CABLE #18 AWG. BELDEN # 9318	ENCLOSURE TO PUMP DISCHARGE PRESSURE TRANSDUCERS.	RUN IN 3/4" CONDUIT, TWO REQUIRED.
e	7 CONDUCTOR #14 CONTROL CABLE	ENCLOSURE TO TERMINALS IN CONTROL PANEL OR MOTOR STARTERS FOR CONTROL SETTING AND MOTOR "ON" TIME.	ROUTE IN STATION WIRING TROUGH.
RESERVED			
g	2-#14 AWG. THHN/THWN (THREE CIRCUITS REQUIRED)	ENCLOSURE TO NEW STATION ENTRY LIMIT SWITCH FOR DOOR POSITION INDICATION & AUDIBLE DEVICES, AND TO STATION WATER PRESSURE SWITCH.	SEE DETAILS OF STATION FOR CONDUIT REQUIREMENT.
h	ANDREW # FS4-50B (1/2" SUPER-FLEX COAX CABLE)	ENCLOSURE TO RADIO ANTENNA FOR COMMUNICATION TO HOST STATION. PROVIDE CONNECTORS - EACH END.	RUN IN 2" CONDUIT FOR RADIO ANTENNA.
i	1 TW SH PAIR CABLE #18 AWG. BELDEN # 9318	ENCLOSURE TO STATION LEVEL PRESSURE SWITCH FOR WET-WELL LEVEL MONITORING.	ROUTE IN STATION WIRING TROUGH TO AUTOCON PANEL.

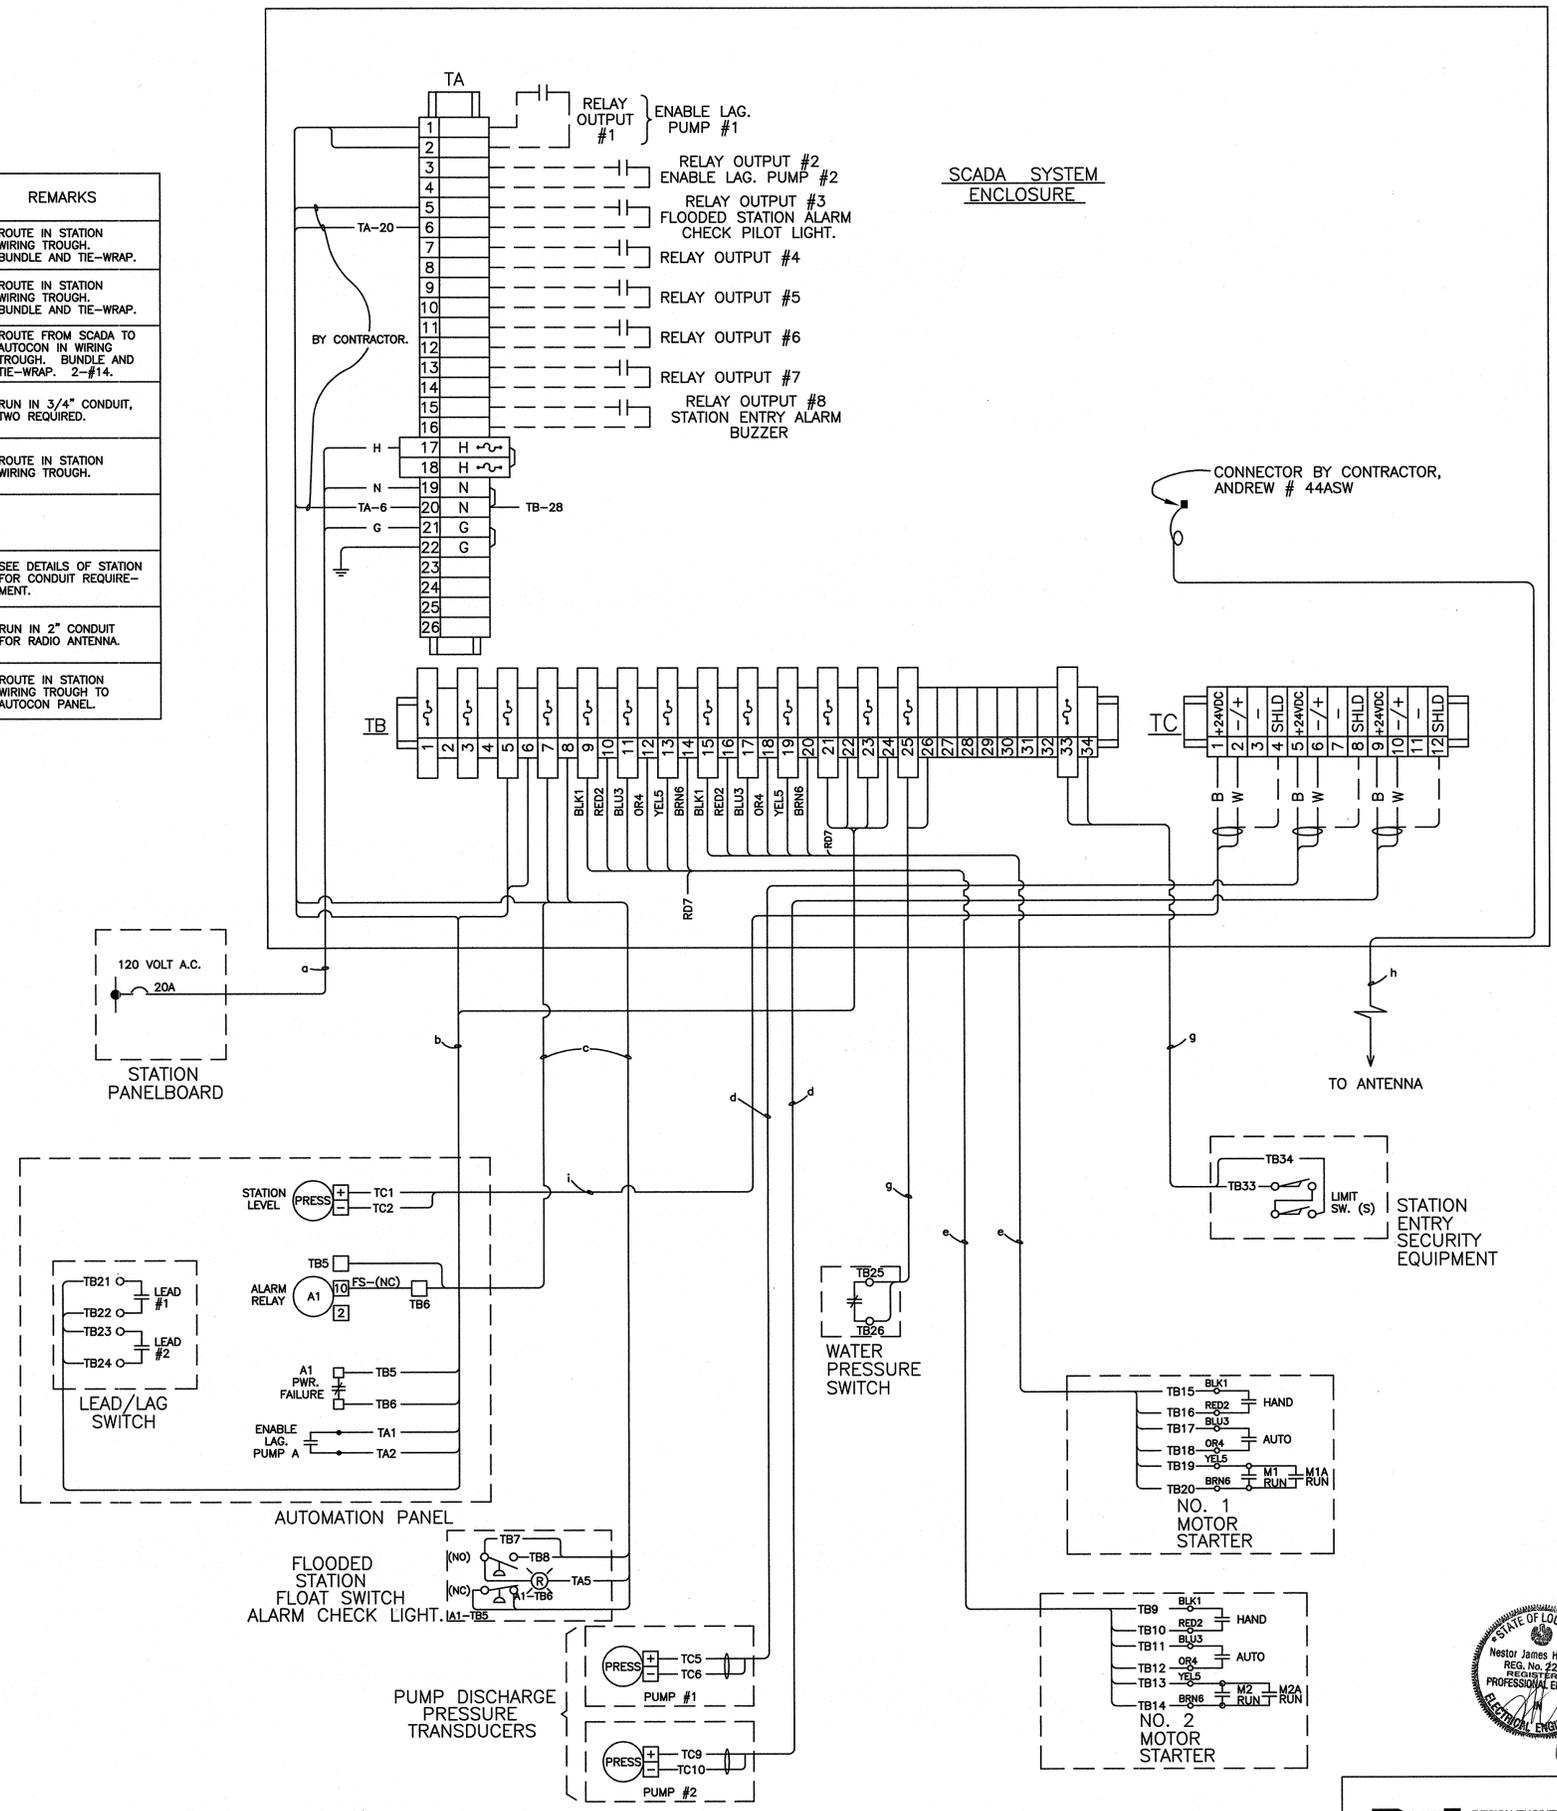

DESIGN ENGINEERING INC.
 3330 West Esplanade Ave. S.
 Suite 205
 Metairie, LA 70002
 (504) 836-2155

REV.	DATE	DESCRIPTION	BY

ELECTRICAL

SEWERAGE AND WATER BOARD OF NEW ORLEANS

CONTRACT 3668
 HURRICANE KATRINA RELATED
 404 HAZARD MITIGATION GRANT PROGRAM
 REPLACEMENT OF VICTORIA SEWAGE PUMPING STATION

SCADA PANEL RISER DIAGRAM AND DETAILS


DR. MZ
 CK. DS/CW
 AP. NH
 LAST EDIT. --
 SCALE AS SHOWN
 DATE JANUARY 2012

GENERAL SUPERINTENDENT





DWG. No. 5030-P6

SHEET NO. 40


PRINTED May 30, 2013 - 3:00pm FILENAME - J:\6005.1-GOSHEP-2013\Contract 3668 - Victoria SPS\ELECTRICAL\SH1 41_ELEC_VICTORIA_LIGHTNING_PROTECTION_PLAN.dwg

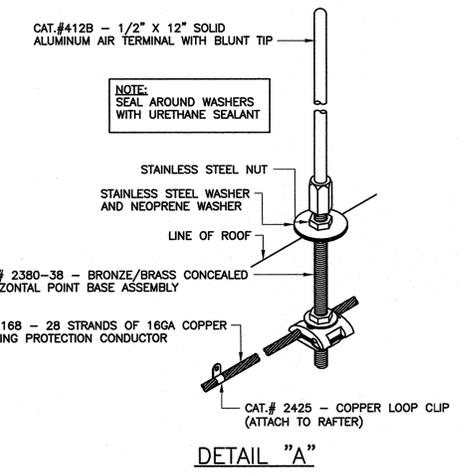

NOTE: CONTRACTOR SHALL LOCATE ASSEMBLY TO AVOID CONFLICTS WITH ROOF FRAMING MEMBERS

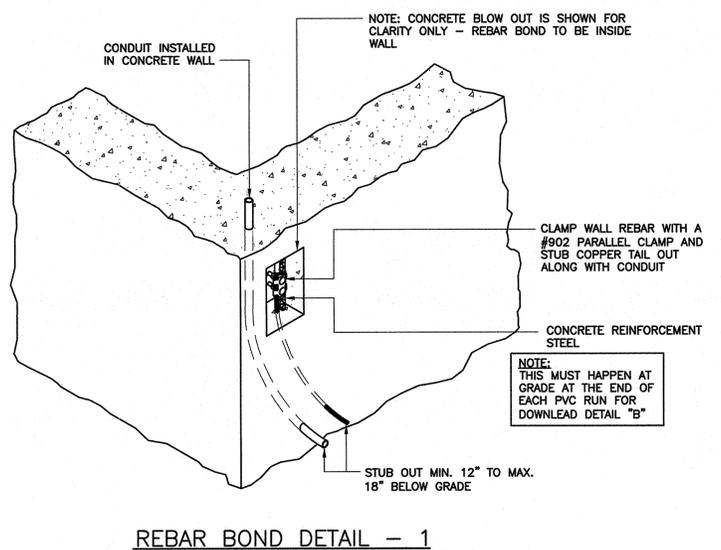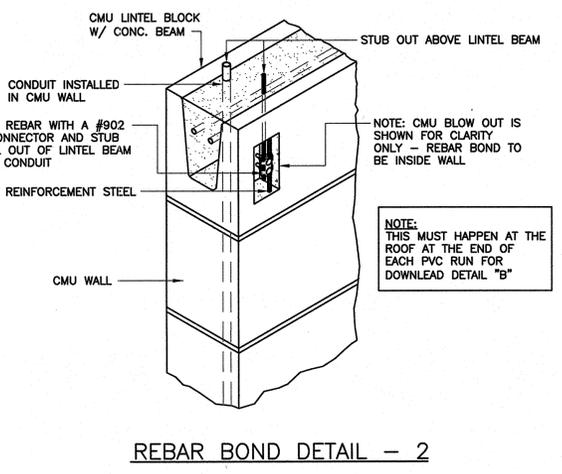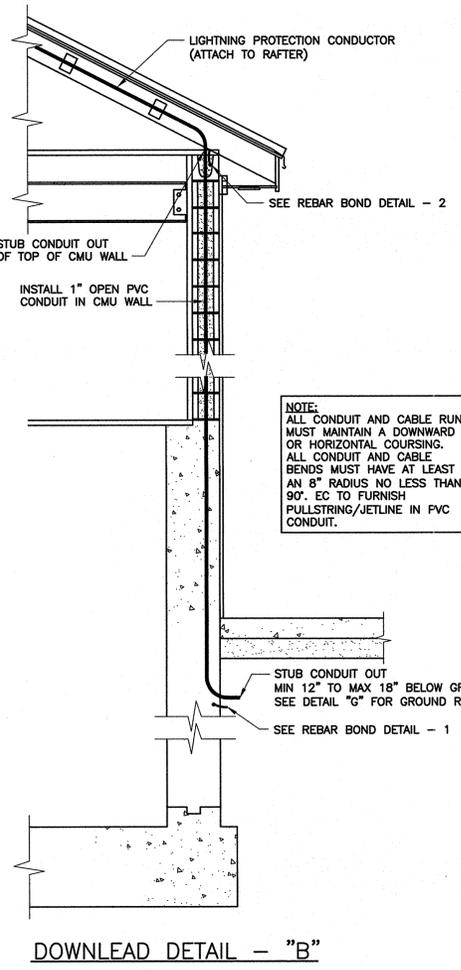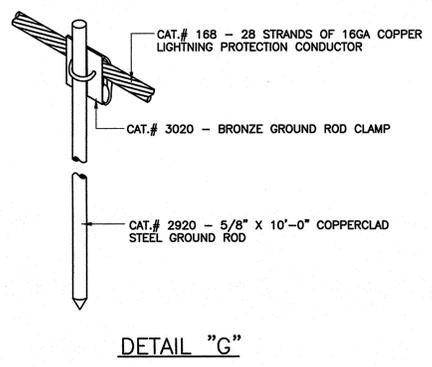

- GENERAL NOTES:**
- 1) THE LAYOUT SHOWN IS TYPICAL AND CONTRACTOR SHALL COORDINATE ACTUAL LOCATION OF COMPONENTS WITH BOARD ENGINEER.
 - 2) LIGHTNING PROTECTION SYSTEM SHOWN IS BASED ON A DESIGN PREPARED BY BONDED LIGHTNING PROTECTION SYSTEMS, LTD., 122 LEESLEY LANE, ARGYLE, TX 76226.

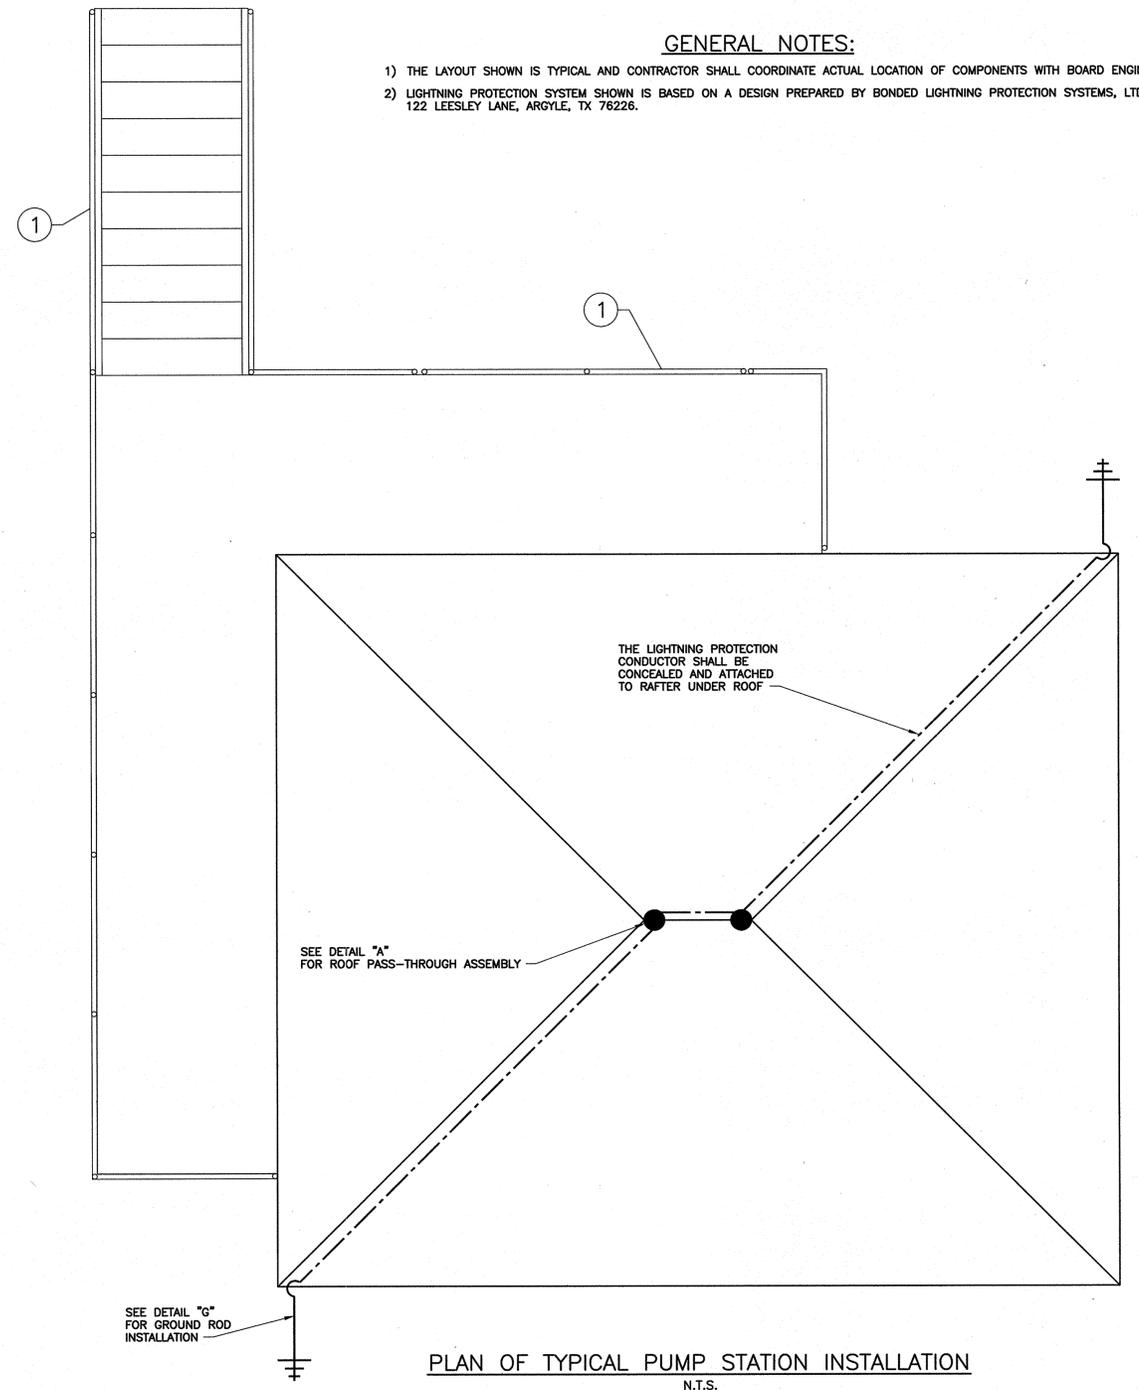

- SPECIFIC NOTES:**
- 1 LOWER ROOF IS UNDER ZONE OF PROTECTION CREATED BY HIGHER PROTECTED ROOFS.

SYMBOL LEGEND

SYMBOL	DESCRIPTION
---	LIGHTNING PROTECTION CONDUCTOR
⊕	GROUND ROD
●	AIR TERMINAL



DESIGN ENGINEERING INC.
3330 West Esplanade Ave. S.
Suite 205
Metairie, LA 70002
(504) 836-2155

ELECTRICAL

REV.	DATE	DESCRIPTION	BY

SEWERAGE AND WATER BOARD OF NEW ORLEANS

CONTRACT 3668
HURRICANE KATRINA RELATED
404 HAZARD MITIGATION GRANT PROGRAM
REPLACEMENT OF VICTORIA SEWAGE PUMPING STATION

LIGHTNING PROTECTION PLAN AND DETAILS

DR. TH	
TRC. --	
CK. DS	GENERAL SUPERINTENDENT
AP. NH	DWG. No. 5030-P7
SCALE: AS SHOWN	
DATE: APRIL 2013	SET NO. SHEET NO. 41