

# DRAWINGS OF

# COMFORTINN & SUITES

JOB No. 202281

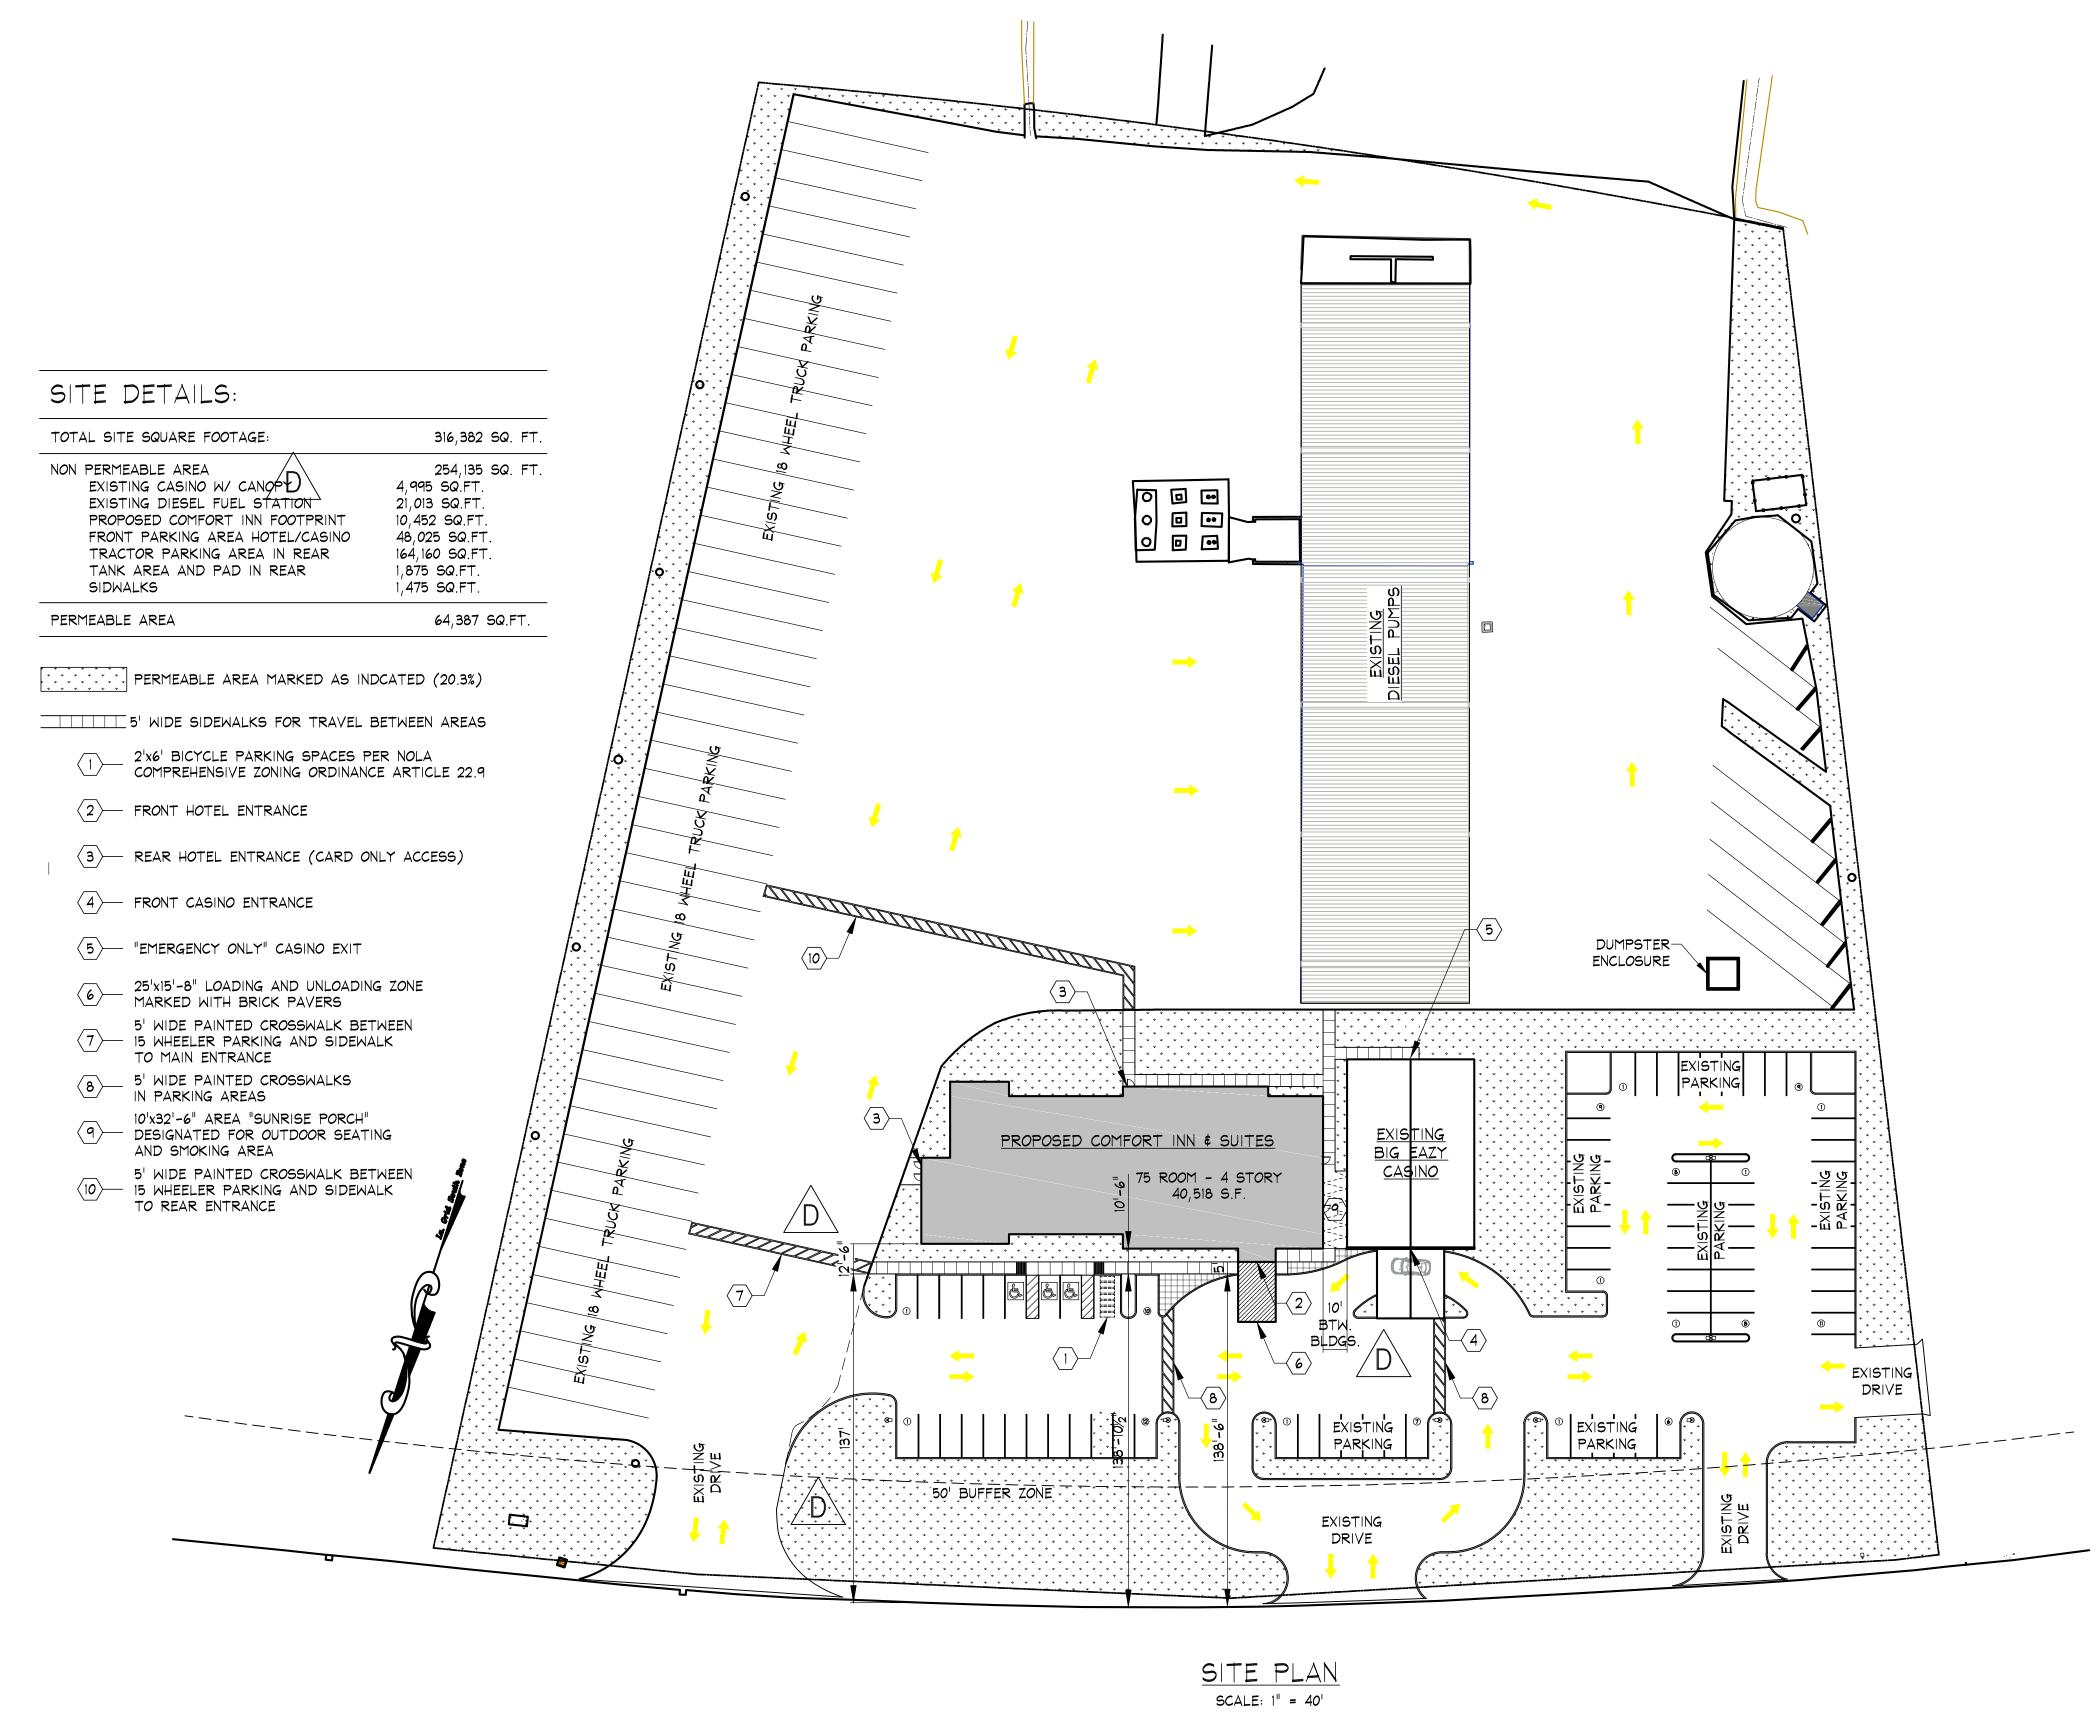

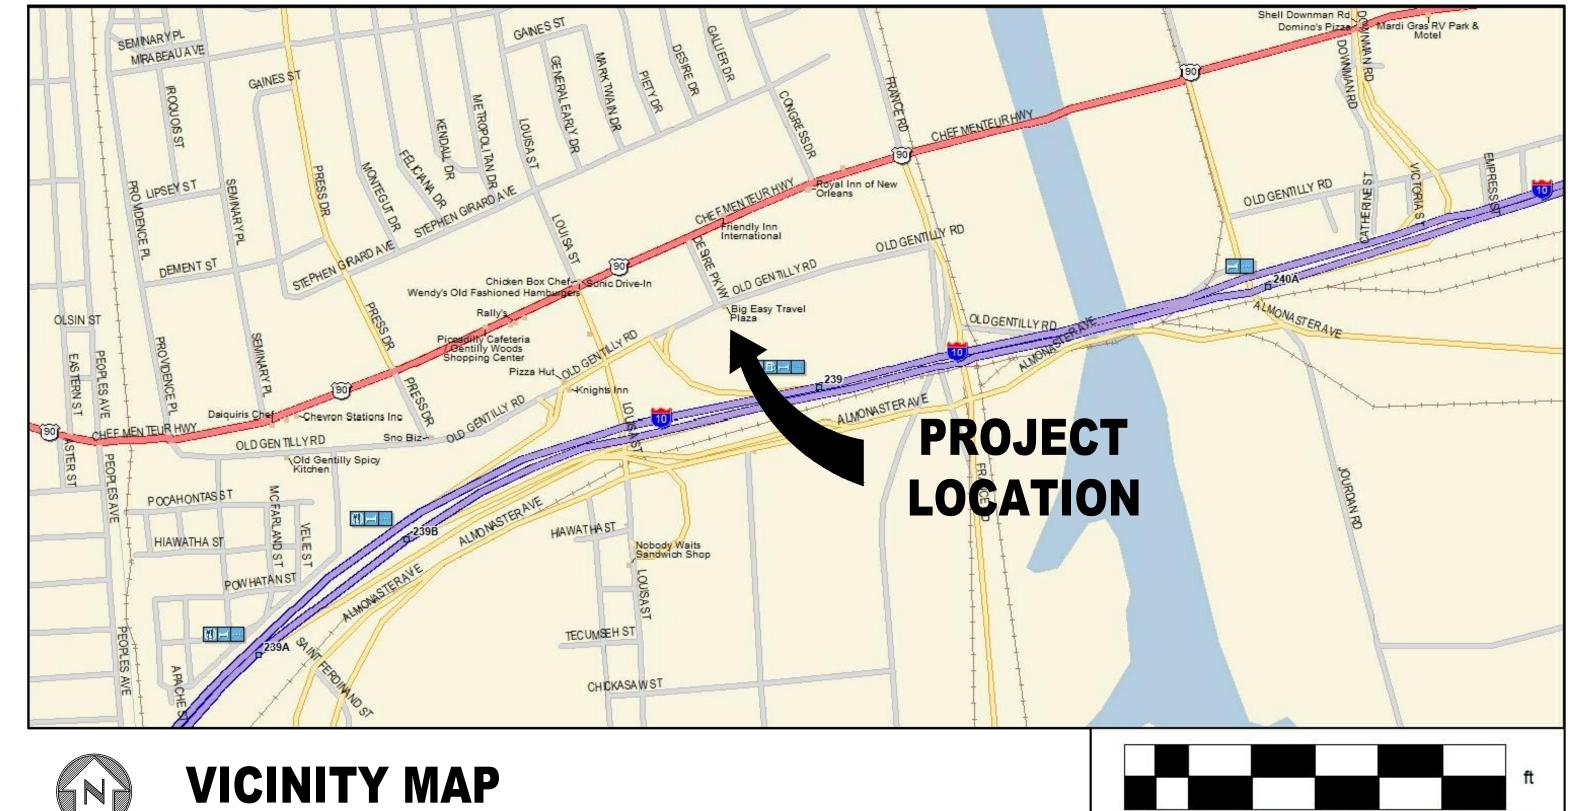

BY CHKD. APPR.

REVISION DESCRIPTION

B 12-07-22 WALL ASSEMBLY CALLOUTS/FLOOR PLAN ADDED PER FIRE MARSHALL

12-19-22 ADDED DWGs FOR CLARITY PER FIRE MARSHALL

01-05-24 INFORMATION FOR CITY PLANNING COMMITTEE MTG.

12-08-22 ISSUED FOR APPROVAL

PATEL CONSTRUCTION, LLC CONTACT: PINU PATEL 337-274-4280


PINUPATELL@GMAIL.COM

ARCHITECT / PROFESSIONAL OF RECORD DEAN HOTARD & ASSOCIATES, INC.

CONTACT: DEAN HOTARD
PHONE: 225-343-7591
EMAIL: DEANHOTARD@AOL.COM

**DRAWINGS FOR COMFORT INN & SUITES** 


Post Office Box 702
 Phone (225) 343-7591
 Port Allen, LA 70767
 Fax (225) 343-5101

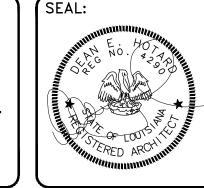

PROJECT NO. 202281 DRAWN BY: REV. NO.: BAO

COMMIT TO THE LORD WHATEVER YOU DO, AND YOUR PLANS WILL SUCCEED. PROVERBS 16:3

5000 OLD GENTILLY RD. NEW ORLEANS, LA. 70126 ORLEANS PARISH

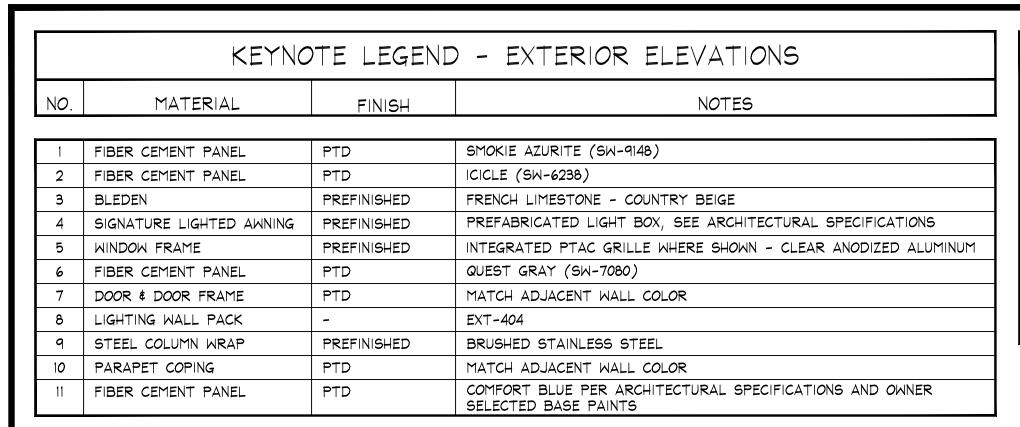

BASE PAINTS OPTION 1: COMFORT BLUE SHERWIN WILLIAMS - LOXON XP EXTERIOR W/ FLAT FINISH <u>OPTION 2</u>: COMFORT BLUE

OZ 32 64 128 - 10 1 -6 10 - -2 23 1 -

W1 - WHITE

LI - BLUE R3 - MAGENTA

ONE GALLON : LX11T0054

ULTRADEEP : 651032849

SHERWIN WILLIAMS - LOXON SELF-CLEANING W/ FLAT FINISH

ULTRADEEP : 651028326

 WI - WHITE
 11 - 

 L1 - BLUE
 4 63 1 1

 R3 - MAGENTA
 2 53 - 1

 ONE GALLON : LX13T0054

# GENERAL NOTES - EXTERIORS ELEVATIONS:

- 1. FOR SPECIFIC WINDOW ELEVATIONS & DETAILS; SEE SHEET A24.
- WHERE MATERIAL ALTERNATIVES EXIST, USE OF THESE MATERIALS MUST BE CONSISTENT THROUGHOUT THE ENTIRE PROJECT. MIXING OF MATERIALS AND COLOR SCHEMES ARE PROHIBITED.

# TRANSPARENCY CALCULATION:

- (A1) ---- TOTAL AREA (ft2) OF GROUND FLOOR BUILDING FRONT (A2) ----- TOTAL AREA (ft2) OF GLASS FRONT (W9) ---- AREA OF WINDOW MARK "9"
- (W6) ---- AREA OF WINDOW MARK "6" (W4) ---- AREA OF WINDOW MARK "4"

- (A1) = (BUILDING LESS ENTRY WIDTH x CEILING HEIGHT) + (ENTRY WIDTH x CEILING HEIGHT)
- = (151.75' x 11.09') + (15.67' x 11.5') = <u>1862.82</u>
- $(A^2) = 4 (W^9) + 4 (W^6) + (W^4) = 4 (29 \text{ ft}^2) + 4 (163.75 \text{ ft}^2) + 160.85 \text{ ft}^2$ = 116 + 655 + 160.85 = <u>931.85</u>
- $(A_2) / (A_1) = PERCENTAGE OF TRANSPARENCY = 931.85 / 1862.82 = 0.5002 = 50%$


LEFT ELEVATION

SCALE: 1/8" = 1'-0"

Comfort

RIGHT ELEVATION

SCALE:  $\frac{1}{8}$  = 1'-0"

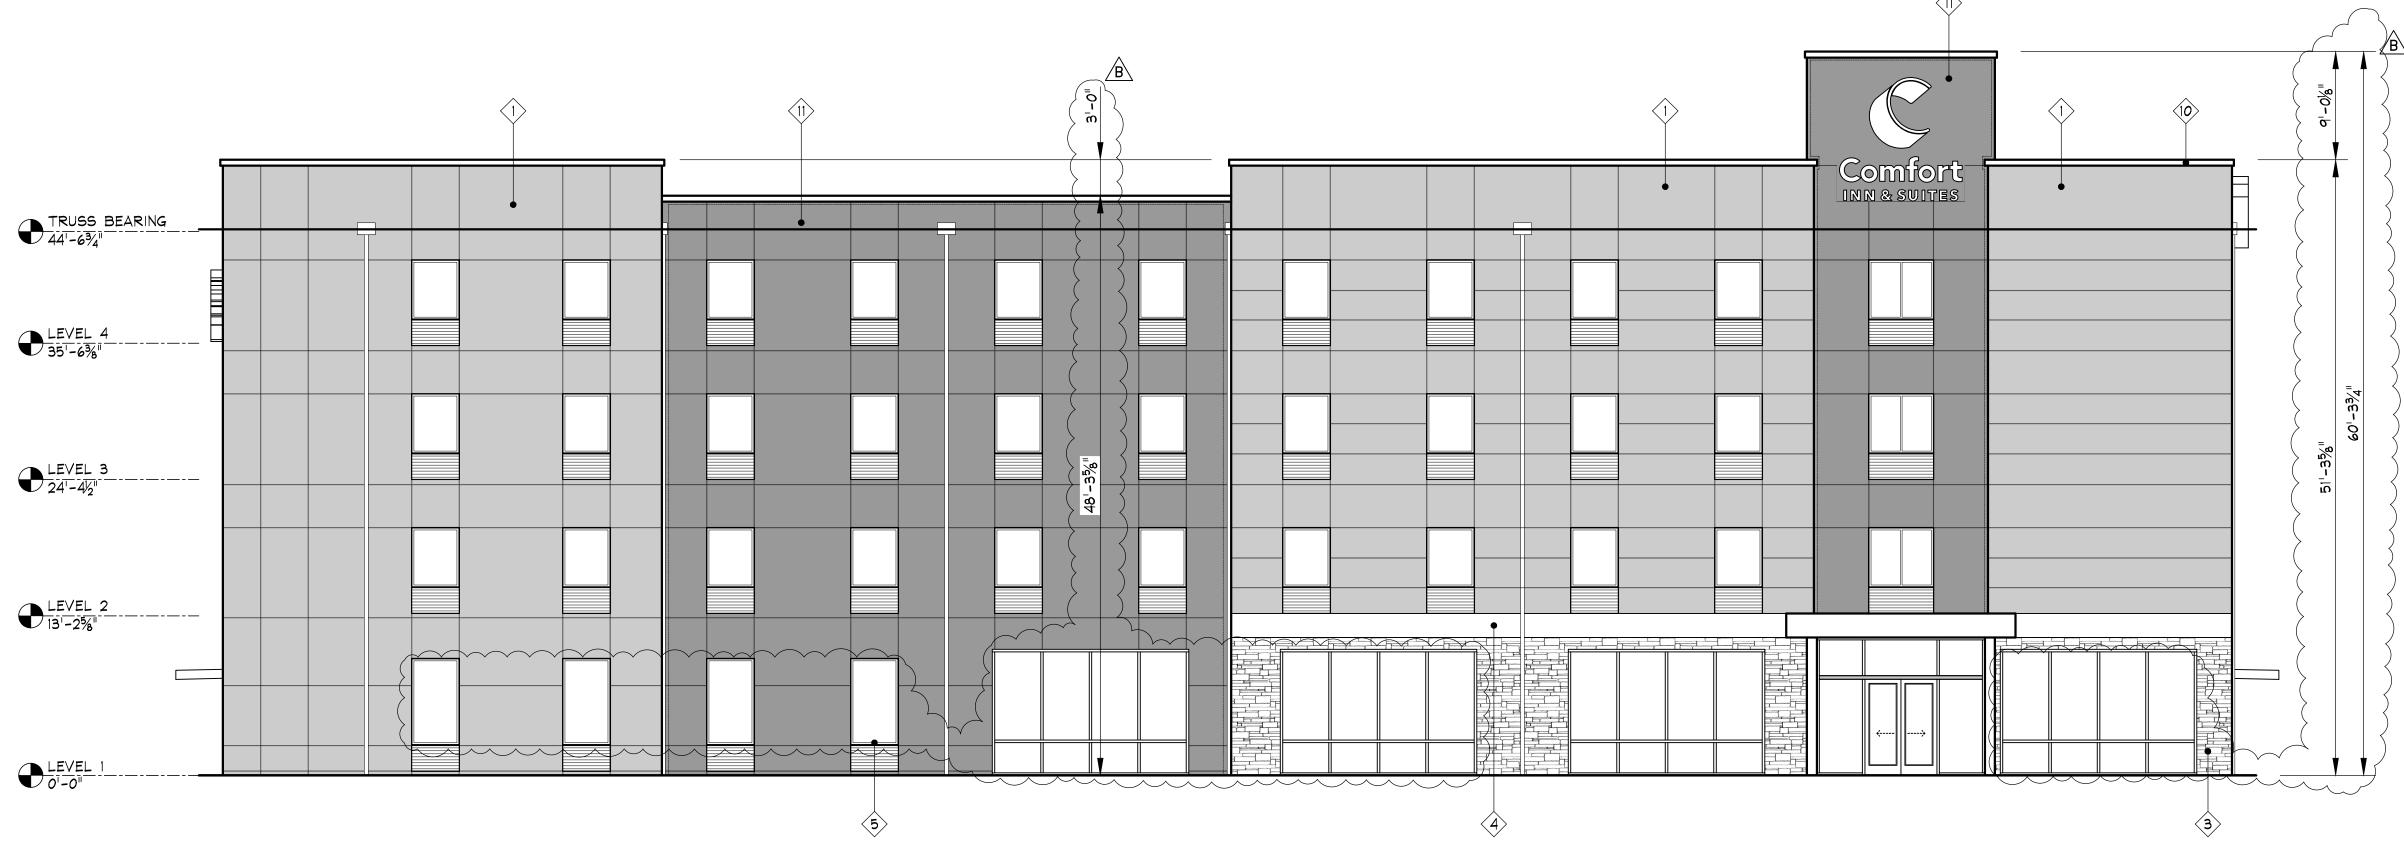

FRONT ELEVATION

SCALE: 1/6" = 1'-0"




BY CHKD. APPR. NO. DATE REVISION DESCRIPTION 12-08-22 ISSUED FOR APPROVAL B 11-06-23 REVISED TO CHANGE WINDOW SIZES, ADD BUILDING BAO BAO

# **DRAWINGS FOR COMFORT INN & SUITES**

5000 OLD GENTILLY RD. NEW ORLEANS, LA. 70126 ORLEANS PARISH



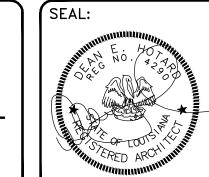


Comfort INN & SUITES


 $\langle 2 \rangle \langle 1 \rangle$ 


PROJECT NO. 202281 DRAWN BY: REV. NO.: BAO




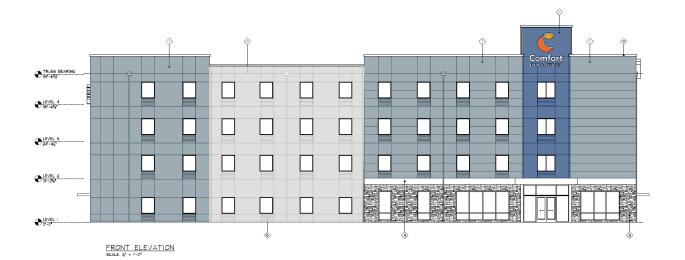



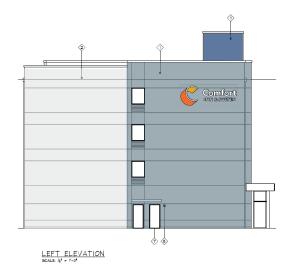

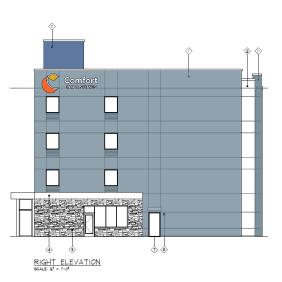

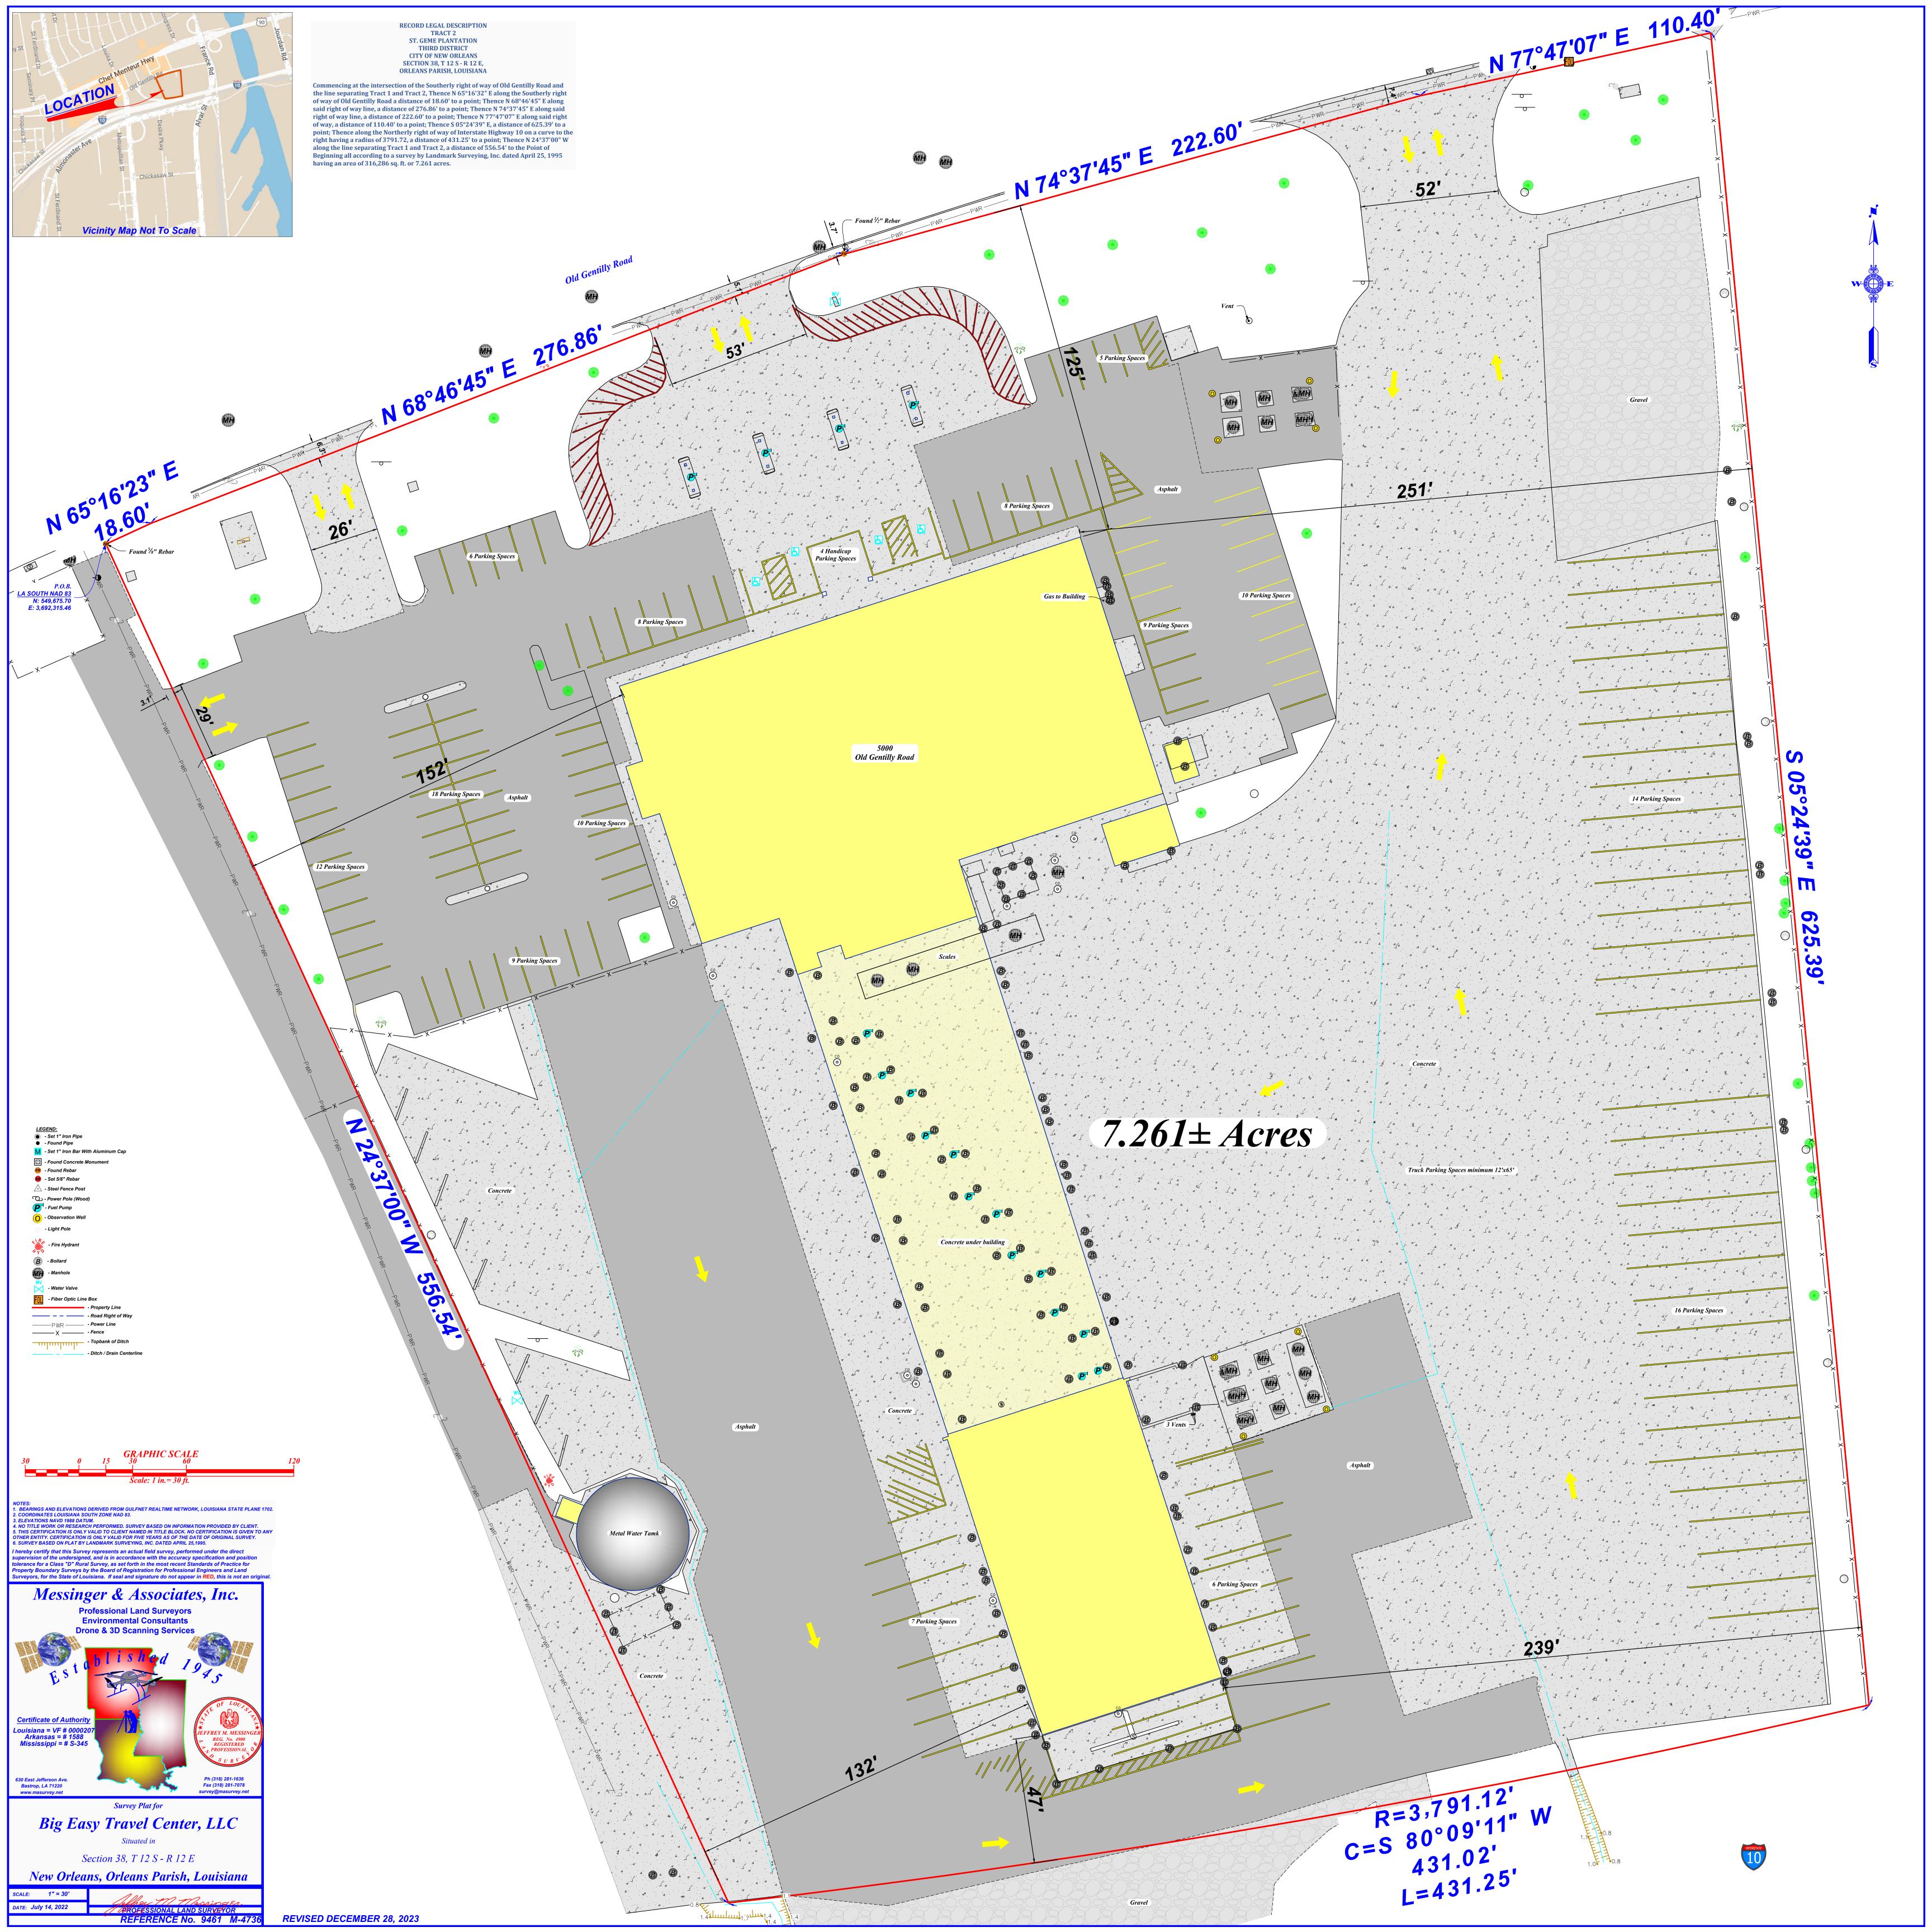



To: Design Advisory Committee

From: Nicole Webre & Wesley Gillen, Webre Consulting

**Date:** 1/9/2023

Re: 5000- 5090 Old Gentilly Road

## CPC staff and DAC Members:

# **Summary and Highlights:**

Presently we are before you for the construction of a new hotel with a floor area of 40,518 square feet which is a permitted use in the C-2 Auto-Oriented Commercial Zoning District because the building is over 40,000 sq ft. The building will round out the development site geared toward truckers and their 18-wheelers traveling along the I-10 corridor.

We are providing the following as a response to our December DAC review.

- The proposal for review is a new hotel (Comfort Inn & Suites) at the site where there is an existing conditional use for a casino and truck stop. Hotels are a permitted use.
- Earlier in 2023 the site plan DR 013-23 was approved which contained the new proposed hotel and new casino buildings and the site plan was recorded in the Orleans Parish Land Records.
- The site is located adjacent to the I-10 overpass and located near the end of Old Gentilly Road which terminates at France Road. The I-10 overpass abuts the rear of the property and the front of the property faces the rear of a shopping strip mall building.
- There is no crosswalk connectivity to the nearest bus-stop and there are no sidewalks along this portion of Old Gentilly Rd which was previously zoned Light Industrial.
- Public Works reviewed DAC's request to consider sidewalks and determined that installation of a sidewalk was "not required at this time."
- In the site plan Pedestrian Walkways have been added connecting parking areas to the hotel.
   Also, outdoor areas for hotel guests are identified in the site plan located between the hotel and casino buildings which are an outdoor seating area and an area for pets.
- Hotel elevation plans meet the 50% transparency on the ground floor.

### Narrative:

The proposed seventy-five room hotel will be four-stories to complement the site and its use which is tailored for travelers in oversized vehicles. The expansive parking and parking lanes are needed to allow for oversized vehicles carrying large containers is just 518 sf ft over the 40,000 square feet threshold.

### **Current Use:**

The site currently functions as a truck stop with diesel fueling docks and casino, which was permitted through a Conditional Use in 1994, **ZD120-94**. Since the Conditional Use was originally approved, the underlying zoning has changed from LI, Light Industrial, to C-2, Auto-Oriented Commercial. The **ZD120-94** zoning entitlement was amended through administrative design review process, in accordance with Article 4, Section 4.5.F, in 2023 (**Docket number DR013-23**) which resulted in the following changes:

- Casino and truck stop must maintain compliance with LI standards in place at the time of original CU approval, as well as any provisos.
- New hotel use must comply with current C-2 Auto Oriented Commercial District requirements.
- Enhanced landscaping, screening, and building setback requirements along Old Gentilly Road frontage, within parking area, and along the site's perimeter, described below.
- Improved circulation within the site as shown in the site plan.
- No significant changes in circulation to and from the site.
- Off-street parking will be provided and no parking variance or waivers are required.
- Recorded site plan for Zoning Docket DR013-23, which governs the site and submitted with this narrative.

Therefore, the scope of this design review is regarding the new hotel use over 40,000 square feet in area, which is an ancillary use that supports the primary truck stop use.

Pursuant to Article 4, Section 4.5.F.1-2, amendments to the recorded site plan for Zoning DR013-23 must be approved by the Executive Director of the City Planning Commission, which this site went through in early 2023. Modifications to this recorded site plan that the property owner can provide, that also do not require a new recorded site plan, include:

- Addition of sidewalk if existing utilities, landscaping requirements, and size of public right-of-way between curb and property line is wide enough to accommodate.
- Additional pedestrian striping/walkways.

Concurrently, we are applying to the Board of Zoning Adjustments (BZA). The site is in a C-2 Auto-Oriented Commercial District, where the maximum height for buildings is forty feet and no more than three stories, pursuant to **Article 15, Section 15.3.A.1** (Table 15-2) of the Comprehensive Zoning Ordinance. The proposed building is four stories in height, necessitating a waiver of one (1) story.

Below please find the approval standards of Article 4, Section 4.5.E of the Comprehensive Zoning Ordinance and how we intend to comply.

In reviewing site plan and design review applications, the relationship of the development plan to adopted land use policies and the goals and objectives of the Master Plan shall be evaluated. In addition, the following characteristics shall be considered:

1. Degree of conformity with the regulations of this Ordinance.

Response: The proposed hotel is one of the ancillary uses that will support the primary truck stop use, which was approved through a conditional use ordinance in 1994, **ZD120-94**. In early 2023, an administrative design review resulted in approved modifications to the original Final Development Plan

to include a new casino structure and enhanced landscaping and screening requirements, **DR013-23**. This zoning entitlement imposed standards on the site that are above and beyond that of the underlying zoning district via provisos. **Therefore, the DAC can be assured that the site not only meets the requirements of the Ordinance, it exceeds them.** 

Further, we believe that the proposed hotel building and use are highly appropriate for the C-2 Auto-Oriented Commercial District. The District "is intended for large-scale, auto-oriented commercial uses and strip commercial developments, which require significant parking."

2. Degree of conformity with all applicable regulations within the City Code, and the goals and policies of the Master Plan.

Response: The hotel will comply with all regulations of the City Code and the respective reviews will be conducted during the plan review process. With respect to the Plan for the 21st Century, the proposed building is consistent with the goals, range of uses, and development character of the General Commercial Future Land Use Category. A hotel will support the goal of increasing the retail tax base, as hotel guests will frequently patronize adjacent retail uses. Further, the FLU category encourages "larger commercial structures" and "minimal negative impacts on surrounding residential areas." The rear property line runs parallel to the I-10 elevated interstate. It is also adjacent to an LI Light Industrial District to the south. Finally, the site is over 1000 feet from the residential district to the north, as shown in Figure 1. Therefore, no negative impacts on residential uses are expected.

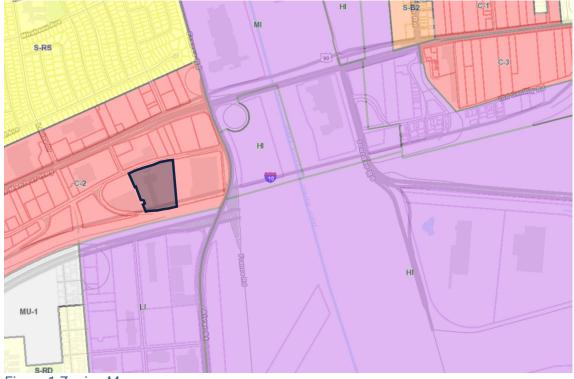


Figure 1 Zoning Map

3. The location, arrangement, size, design, and general site compatibility of buildings, lighting, and signs, including:

- a. Compatibility with, and mitigation of, any potential impact upon, adjacent property.
- b. Site illumination designed and installed to minimize adverse impact on adjacent properties.

Response: As noted previously, the approved Final Development Plan meets the requirements of the conditional use ordinance and the subsequent administrative design review, **DR013-23**, placed enhanced development, operational and landscaping standards on the site. Compatibility with the surrounding development and mitigation of the impacts of the truck stop use on adjacent uses was the primary goal of the provisos of approval. **DR013-23's provisos consist of enhanced landscaping, site design, and screening requirements that resulted from the 2023 administrative design review that mitigate potential impacts on adjacent property include:** 

- The provision of a continuous vegetative buffer along the periphery of the site consisting of sixfoot-tall evergreen hedge and large deciduous shade trees.
- A paving and building setback of fifty feet from and within the property along Old Gentilly Road with shade trees, shrubs, and groundcover.
- The provision of landscaping on the interior of all parking areas using deciduous shade trees.
- Screening along Old Gentilly Road of all vehicular use areas with a continuous hedge, berm, and/or masonry wall that is thirty inches in height.
- Detailed landscape plantings at all entries.
- All loading areas and trash dumpsters are screened from the public right-of-way and by a six-foot-tall, opaque fence with gate.
- With regard to lighting, the recorded site plan indicates night and security lighting throughout the site.

Considering that the hotel use is far less intense than the truck stop use, the DAC can be certain that any detrimental impacts have been mitigated.

- 4. Landscape and the arrangement of open space or natural features on the site shall:
  - a. Create a desirable and functional environment for motorists, pedestrians, bicyclists, and occupants of residential dwellings, business owners, and employees. To achieve such an environment, landscape may take advantage of open space design features such as bike paths, running paths, and outdoor relaxation areas.
  - b. Preserve unique natural resources, including measures to preserve and protect existing healthy, mature trees.
  - c. Protect natural resources and landscape on adjacent sites.
  - d. Design drainage facilities to promote the use and preservation of natural watercourses and patterns of drainage.
  - e. Utilize plant materials suitable to withstand the climatic conditions of New Orleans and microclimate of the site. The use of native species is encouraged.

f. Screening to buffer the impact of the development on adjacent uses and enhance the appearance and image of the City by screening incompatible uses and certain site elements, and creating a logical transition to adjoining lots and developments.

Response: The applicant intends to preserve all mature/viable trees and greenspace onsite, further enhance those features with berms and abundant plantings that soften the environment, serve as a buffer between adjacent uses, and comply with Article 23 Section 4, Selection, Installation, and Maintenance of Plant Material, as shown in the recorded landscape plan for DR013-23. Accommodations for pedestrians include illuminated awnings at the façade, pedestrian seating area between the new hotel and existing casino, pedestrian striping leading to the front entrances of both the casino and hotel, as well as striping leading from the rear parking area to the rear entrances. Further, the landscaping of the parking lot serves to define the vehicular use areas and guide pedestrians safely from their cars to the entry. Additionally, there will be screening along Old Gentilly Road of all vehicular use areas with a continuous hedge and/or masonry wall maintained at a height of thirty inches. As noted above, there will be a continuous vegetative buffer along the right and left property lines made up of a six-foot-tall evergreen hedge and large deciduous shade trees. This is in addition to the fifty-foot paving and building setback that will contain shade trees, shrubs, and ground cover.

Regarding drainage and protecting natural watercourses, all paved areas are existing and are the minimum dimensions needed to accommodate parking and circulation within the site. Both the number of car and truck parking spaces has been reduced from the previously approved (**ZD120-94**) plan. A Drainage Plan has also been submitted and approved by SWB and the City's Stormwater Review Division in OneStop. Finally to protect natural watercourses, the owners have submitted a litter abatement program that has been approved by the Department of Sanitation and includes daily trash pickup and the provision of sturdy trash receptacles.

- 5. Circulation systems and off-street parking shall be designed to:
  - a. Provide adequate and safe access to the site for motor vehicles as well as alternate modes of transportation, including pedestrians, bicyclists, and public transit.
  - b. Minimize potentially dangerous traffic movements.
  - c. Separate pedestrian and auto circulation and provide for bicycle parking or storage where required.
  - d. Minimize curb cuts by using cross-access servitudes and shared parking.
  - e. Design off-street parking lots or garages to minimize adverse impacts on adjacent properties, particularly through the use of perimeter and interior landscape, and promote logical and safe parking and internal circulation.
  - f. Clearly define pedestrian access from the parking area to the building(s). A clearly defined visible and identifiable network of pedestrian connections should be provided in and between parking lots, street sidewalks, open spaces, buildings, and public transit.

Response: The applicants are proposing no significant changes in circulation to and from the site as all existing curb cuts with two-way traffic will be retained and re-utilized. Within the site, circulation will

be similar to the previously approved plan for **ZD120-94**, with the only modification being that traffic will flow around the new row of parking from the center curb cut as opposed to through the fueling deck that was previously in its place. This constitutes an improvement as there are fewer potential vehicular conflicts.

Pedestrian striping and walkways have been added in the front and rear parking areas leading to front and rear entrances for the hotel and casino, as well as eight bicycle parking spaces located in the hotel's front parking area. Further, the landscaping of the parking lot serves to define the vehicular use areas and guide pedestrians safely from their cars to the entry.

Connectivity regarding pedestrian walkways to sidewalks, adjacent properties, and public transit is limited due to existing site conditions, as shown in **Figure 2**. There is limited space for a sidewalk in the public right-of-way, which varies in width from 7' 4" to 3' 7" and has utilities present, as shown **in the survey submitted with this report.** This survey has also been submitted to the Department of Public Works to determine if sidewalk installation is feasible given the existing conditions and the response was that, "Sidewalks are not required at this time."

The nearest public transit stops are at Winn Dixie on Desire Parkway. The only existing crosswalk for riders is on Desire Parkway. From there riders must cross Old Gentilly Road, with no crosswalk, from Desire Parkway and enter the neighboring property at 4700 Old Gentilly Road, which has no sidewalk due to existing fenced in utilities, as shown in yellow in **Figure 2, and in Figures 3, 4, and 5.** 

As mentioned above, Public Works reviewed whether sidewalks were required and determined that they "were not required at this time". Utility lines, the property line abutting the street and landscaping requirements make it difficult to incorporate a sidewalk.



Figure 2 Surrounding Development



Figure 3 Fenced Utilities Blocking Sidewalk Connection at 4700 Old Gentilly Road, East Facing



Figure 4 Fenced Utilities Blocking Sidewalk Connection at 4700 Old Gentilly Road, North Facing



Figure 5 Fenced Utilities Blocking Sidewalk Connection at 4700 Old Gentilly Road, West Facing

# Conclusion:

The new hotel constitutes a major investment in the neighborhood that is expected to elevate the standards of development in the vicinity. The massing of the proposed four-story structure was chosen in part due to the limited developable area, as 18-wheelers require larger turning radiuses, and to the scale of the I-10 elevated highway, thereby creating a more balanced, harmonious relationship of the structure to it's environment.

 From:
 Louis R. Haywood

 for
 Wesley Giller

 DE
 Nicole Vebre: Stephen K. Kroll

 Skulpiect:
 RE: Sidewalk Installation Question-5000 Old Gentiliy Roa

 Tuesday, January 9, 2024 3:03:22 PM

 Image/001\_Jung

Hi Weslev.

After review of local conditions, DPW does not require a sidewalk at this time.

Thank you, Louis

Louis Haywood
Construction Project Manager
City of New Orleans Department of Public Works
LRHaywood@nola.gov
(504) 658-8056 (O)
(504) 329-9555 (C)

From: Wesley Gillen <wesley@webreconsulting.com>
Sent: Thursday, December 28, 2023 11:17 AM

EMAIL FROM EXTERNAL SENDER: DO NOT click links, or open attachments, if sender is unknown, or the message seems suspicious in any way. DO NOT provide your user ID or password. If you believe that this is a phishing attempt, use the reporting tool in your Outlook to send this message to Security.

Good morning, Louis,

My name is Wesley Gillen with Webre Consulting and I am hoping you can clarify whether one of our projects, at 5000 Old Gentilly, will be required to install sidewalks.

The area between the property line and the street varies in width, ranging from 7.4' to 3.7' with some utilities, catch basins, and existing trees present. A new hotel will be constructed, as shown in the attached and recorded site plan for the entire truck stop (DR013-23).

Will we need to install a sidewalk for the construction of the hotel along the entirety of the site? Below is an aerial image of the site and surrounding development. I have attached the survey showing the dimensions for the public right-of-way and the approved site plan for DR013-23.

Thank you for your assistance, Wesley Gillen




Wesley Gillen she/her/hers

Associate Consultant



Wesley@webreconsulting.com

Office: (504) 605-3699

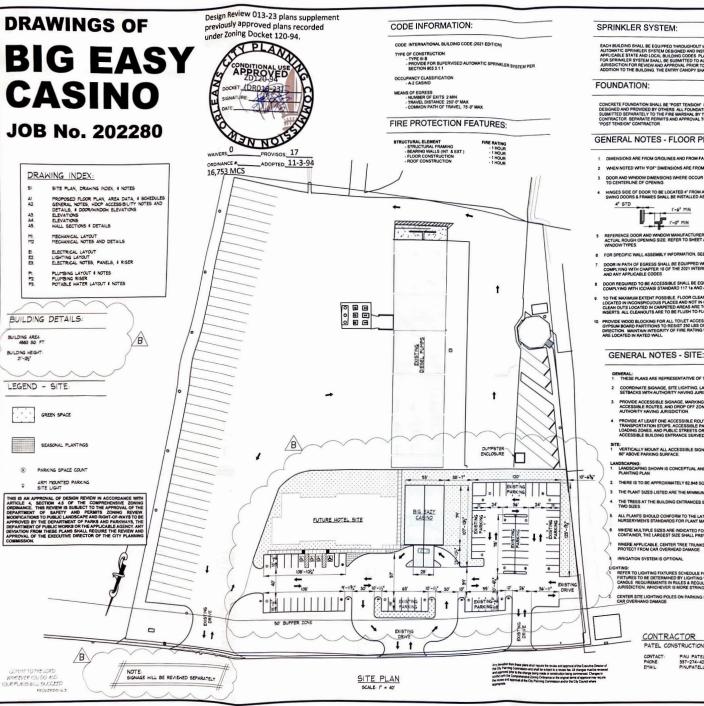



EACH BUILDING SHALL BE EQUIPPED THROUGHOUT WITH A SUPERVISED AUTOMATIC SPRINKLER SYSTEM DEBIGNED AND INSTALLED TO MEET ALL APPLICABLE STATE AND LOCAL BUILDING CODES PLANS AND SPECIFICATIONS FOR SPRINKLER SYSTEM SHALL BE SUBMITTED TO AUTHORITY HAVING JURISDICTION FOR REVIEW AND APPROVAL PRIOR TO CONSTRUCTION IN ADDITION TO THE BUILDING, THE ENTRY CANOPY SHALL ALSO BE SPRINKLED

CONCRETE FOUNDATION SHALL BE "POST TENSION" FOUNDATION SHALL BE DESIGNED AND PROVIDED BY OTHERS ALL FOUNDATION DRAWNINGS SHALL BE SUBMITTED SEPARATELY TO THE FIRE MARSHALL BY THE "POST TENSION" CONTRACTOR SEPARATE PERMITS AND APPROVAL TO BE OSTAINED BY THE

### **GENERAL NOTES - FLOOR PLANS:**

- 1. DIMENSIONS ARE FROM GRIDLINES AND FROM FACE OF STRUCTURE, UNO
- 2 WHEN NOTED WITH "FOF" DIMENSIONS ARE FROM FACE OF FINISH
- DOOR AND WINDOW DIMENSIONS WHERE OCCUR ARE FROM FACE OF STUD TO CENTERLINE OF OPENING.
- HINGES SIDE OF DOOR TO BE LOCATED 4" FROM ADJACENT WALL. UND SWING DOORS & FRAMES SHALL BE INSTALLED AS SHOWN BELOW. UND



- REFERENCE DOOR AND WINDOW MANUFACTURERS' SPECIFICATIONS FOR ACTUAL ROUGH OPENING SIZE. REFER TO SHEET AZ FOR DOOR AND WINDOW TYPES
- 6 FOR SPECIFIC WALL ASSEMBLY INFORMATION, SEE SHEET AS
- DOOR IN PATH OF EGRESS SHALL BE EQUIPPED WITH HARDWARE COMPLYING WITH CHAPTER 10 OF THE 2021 INTERNATIONAL BUILDING CODE AND ANY APPLICABLE CODES
- TO THE MAXIMUM EXTENT POSSIBLE. FLOOR CLEAN OUTS ARE TO BE LOCATED IN INCONSPICUOUS PLACES AND NOT IN GUESTROOMS ALL FLOOR CLEAN OUTS LOCATED IN CARPETED AREAS ARE TO BE FITTED WITH CARPET INSERTS ALL CLEANOUTS ARE TO BE FLUSH TO FLOORWALLS.
- PROVIDE WOOD BLOCKING FOR ALL TOILET ACCESSORIES MOUNTED IN GYPSUM BOARD PARTITIONS TO RESIST 250 LBS OF PULL FORCE IN ANY DIRECTION. MAINTAIN INTEGRITY OF FIRE RATING WHERE ACCESSORIES ARE LOCATED IN RATED WALL.

- GENERAL: 1. THESE PLANS ARE REPRESENTATIVE OF THE MINIMUM DESIGN CRITERIA
- COORDINATE SIGNAGE, SITE LIGHTING, LANDSCAPING, PARKING, AND SETBACKS WITH AUTHORITY HAVING JURISDICTIONS.
- PROVIDE ACCESSIBLE SIGNAGE, MARKING AND STRIPING FOR LANES, ACCESSIBLE ROUTES, AND DROP OFF ZONES AS REQUIRED BY THE AUTHORITY HAVING JURISDICTION
- PROVIDE AT LEAST ONE ACCESSIBLE ROUTE WITHIN THE SITE FROM PUBLIC TRANSPORTATION STOPS, ACCESSIBLE PARKING, ACCESSIBLE PASSENGER LOADING ZONES, AND PUBLIC STREETS OR SIDEWALKS TO THE ACCESSIBLE BUILDING ENTRANCE SERVED
- VERTICALLY MOUNT ALL ACCESSIBLE SIGNS WITH BOTTOM OF LETTERING 60° ABOVE PARKING SURFACE.
- LANDSCAPING:

  1. LANDSCAPING SHOWN IS CONCEPTUAL AND IS NOT TO BE CONSIDERED A PLANTING PLAN.
- 2. THERE IS TO BE APPROXIMATELY 62,848 SQ. FT. (20%) OF GREEN SPACE.
- 3. THE PLANT SIZES LISTED ARE THE MINIMUM SIZES ALLOWED
- THE TREES AT THE BUILDING ENTRANCES SHALL EXCEED THE MINIMUM BY
- ALL PLANTS SHOULD CONFORM TO THE LATEST EDITION OF THE AMERICAN NURSERYMEN'S STANDARDS FOR PLANT MATERIAL.
- WHERE MULTIPLE SIZES ARE INDICATED FOR CALIPER, HEIGHT, OR CONTAINER, THE LARGEST SIZE SHALL PREVAIL.
- WHERE APPLICABLE, CENTER TREE TRUNKS ON PARKING STRIPES TO PROTECT FROM CAR OVERHEAD DAMAGE.
- IRRIGATION SYSTEM IS OPTIONAL
- HTING:
  REFER TO LIGHTING FIXTURES SCHEDULE FOR SITE LIGHTING ACTUAL # OF
  FIXTURES TO BE DETERMINED BY LIGHTING VENDOR BASED ON FOOT
  CANDLE REQUIREMENTS IN RULES & REGULATIONS OR AUTHORITY HAVING
  JURISDICTION, WHICHEVER IS MORE STRINGEN.
- CENTER SITE LIGHTING POLES ON PARKING STRIPES TO PROTECT FROM

### CONTRACTOR

PATEL CONSTRUCTION, LLC

PINU PATEL 337-274-4280 PINUPATELLOGMAIL COM

ARCHITECT / PROFESSIONAL OF RECORD DEAN HOTARD & ASSOCIATES, INC.

CONTACT

DEANHOTARDOADL.COM





### PROVISOS OF CONDITIONAL USE ORDINANCE NO. 16753

### TRAFFIC IMPACTS AND SITE CIRCULATION ISSUES

- WATER AND SITE CRECULATION ISSUES

  FOR CITY PLANNING COMMISSION, IN CONSISTATION WITH THE
- HMEGMANN PROPERTY IN THE EVENT THAT THE DEPARTMENT OF REETS DETERMINES SUCH MEASURES HAVE BECOME NECESSARY
- THE DEVELOPER SHALL FINANCE THE RETENTION AND/OR RELOCATION OF UTILITIES MADE NECESSARY BY THE DEVELOPMENT OF THE TRUCK STOP

### SITE, BUILDING DESIGN, SIGNAGE AND LANDSCAPE ISSUES:

- THE DEVELOPER SHALL SUBMIT A LANDSCAPE PLAN OF APPROVAL AS PART OF FINAL PLANS AND SHALL INDICATE:
- A THE PROVISION OF A CONTINUOUS VEGETATIVE BUFFER ALONG THE
- A THE PROVISION OF A CONTINUOUS SYSTEM BUFFER ALONG THE PERIPHERY OF THE SITE IN THE FORM OF A CONTINUOUS EVERGREEN HEDGE AT LEAST SIX (8) FEET TALL AND A CONTINUOUS BORDER OF LARGE BECLIOUSUS SHADE TREES

  b. A PAVING AND BUILDING SETBACK OF AT LEAST FIFTY FEET FROM AND WITHIN THE PROPERTY LINE ALONG OLD GENTILLY ROAD, AND
- LANOSCAPING INCLUDING SHADE TREES, SHRUBS AND
- c. THE PROVISION OF LANDSCAPING ON THE INTERIOR OF ALL AUTOMOBILE PARKING AREAS UTILIZING DECIDUOUS SHADE TREES. d SCREENING ALONG OLD GENTILLY ROAD OF ALL VEHICULAR USE
  AREAS WITH A CONTINUOUS HEDGE BERM, ANDOR MASONRY WALL
  TO A MAINTAINED HEIGHT OF THIRTY (30) INCHES.
- . DETAILED LANDSCAPE PLANTINGS AT ALL ENTRIES AND SIGN BASES. THE DEVELOPER SHALL PROVIDE NIGHT AND SECURITY LIGHTING THROUGHOUT THE SITE.
- ALL LOADING AREAS AND TRASH DUMPSTERS SHALL BE SCREENED FROM THE PUBLIC RIGHT-OF-WAY BY A SIX FOOT TALL OPAQUE FENCES WITH GATES CONSTRUCTED OF EITHER WOOD OR MASONRY OR A COMBINATION
- ANY NEW POOPS SHALL BE PITCHED
- ANY NEW ROOFS SHALL BE PITCHED
  ALL BULDING ELVATIONS OF THE PROPOSED MODIFICATIONS TO THE
  EXISTING BULDING SHALL BE SUBMITTED FOR REVIEW AND APPROVAL
  THE PROPOSED DETACHED SIGN SHALL BE LIMITED TO 35 FEET IN HEIGHT
  AND 175 SQUARE FEET IN FACE AREA.
- AND 173 SOLUME FEET IN FACE AREA.
  ANY PROPOSED SIGNAGE ON THE BUILDING SHALL BE SUBMITTED TO THE
  CITY PLANNING COMMISSION STAFF AND THE DEPARTMENT OF SAFETY
  AND PERMITS FOR REVIEW AND APPROVAL AND SHALL BE LIMITED TO 175
  SQUARE FEET IN FACE AREA.

- ENHANCEMENTAL ISSUES


- PERMITS AND CITY PLANNING CUMMISSION.

  THE DEVELOPER SHALL INITIATE AND MAINTAIN A LITTER ABATEMENT
  PROGRAM FOR THE OLD GENTILLY ROAD FRONTAGE TO THE SATISFACTION
  OF THE CITY PLANNING COMMISSION THE PROGRAM SHALL INCLUDE DAILY
  TRASH PICK-UP AND THE PROVISION OF STURDY TRASH RECEPTACLES.

17. THIS DEVELOPMENT SHALL NOT PROVIDE GAMING DEVICES UNLESS IT SATISFIES ALL THE REQUIREMENTS OF THE STATE OF LOUISIANA REGARDING GAMING AT TRUCK STOP FACILITIES.



-22


CASINO

EASY

BIG

O OLD GENTILLY ROAD ORLEANS, LA 70126 ORLEANS PARISH

5000 NEW

otard Francis

ean

П

SHEET NO. S1 PROJECT NO. 202280 DRAWN BY: REV. NO.

BAO B